




SEZIONE A-A
SCALA 1:50

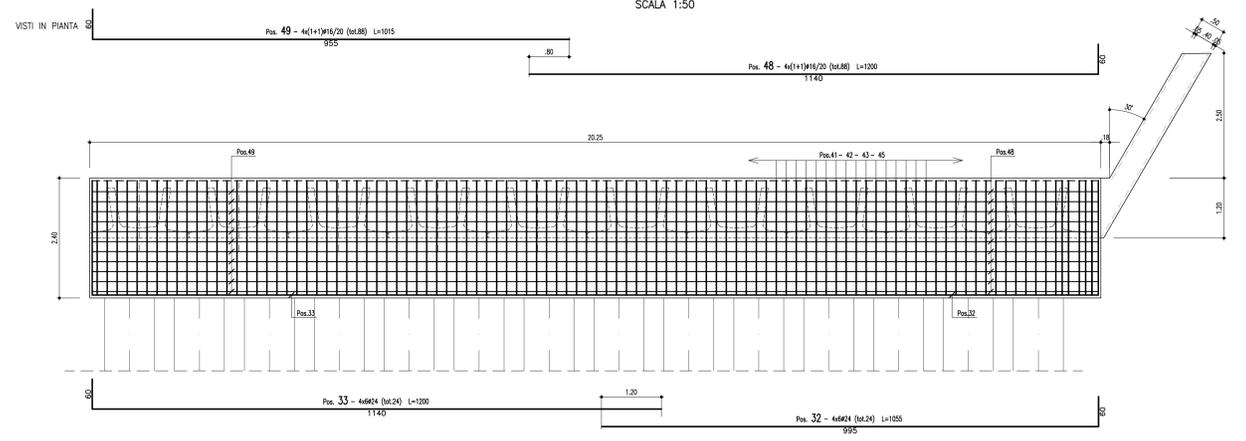


SEZIONE C-C
SCALA 1:25

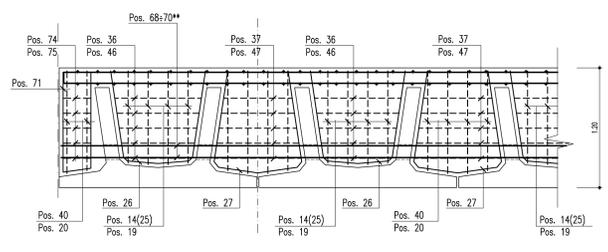

ARMATURA SEZIONE LONGITUDINALE B-B
SCALA 1:50

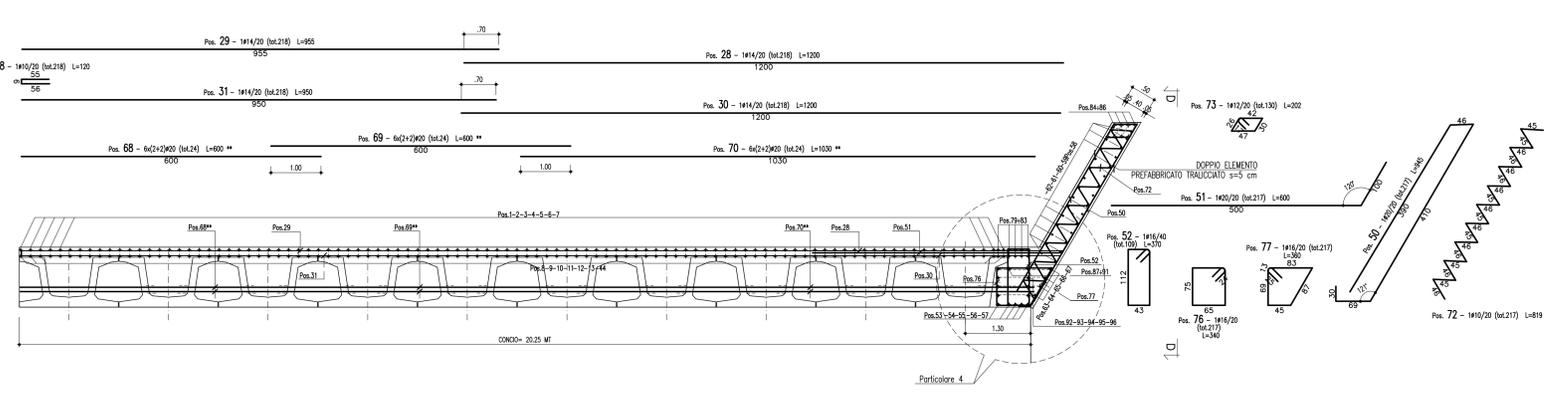

PARTICOLARE 4
SCALA 1:25

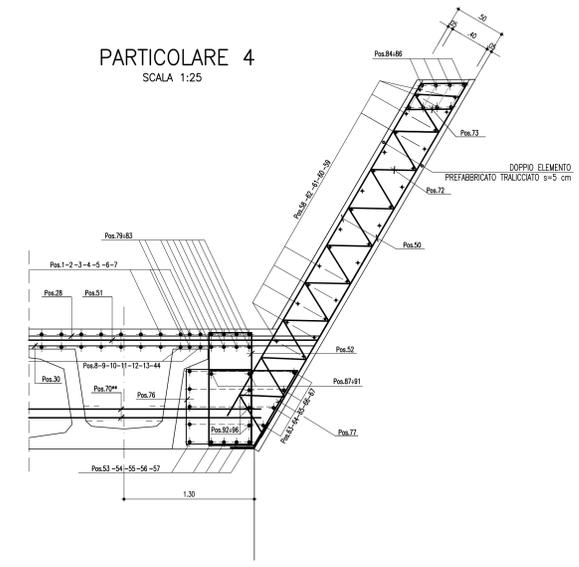

SEZIONE D-D
SCALA 1:50

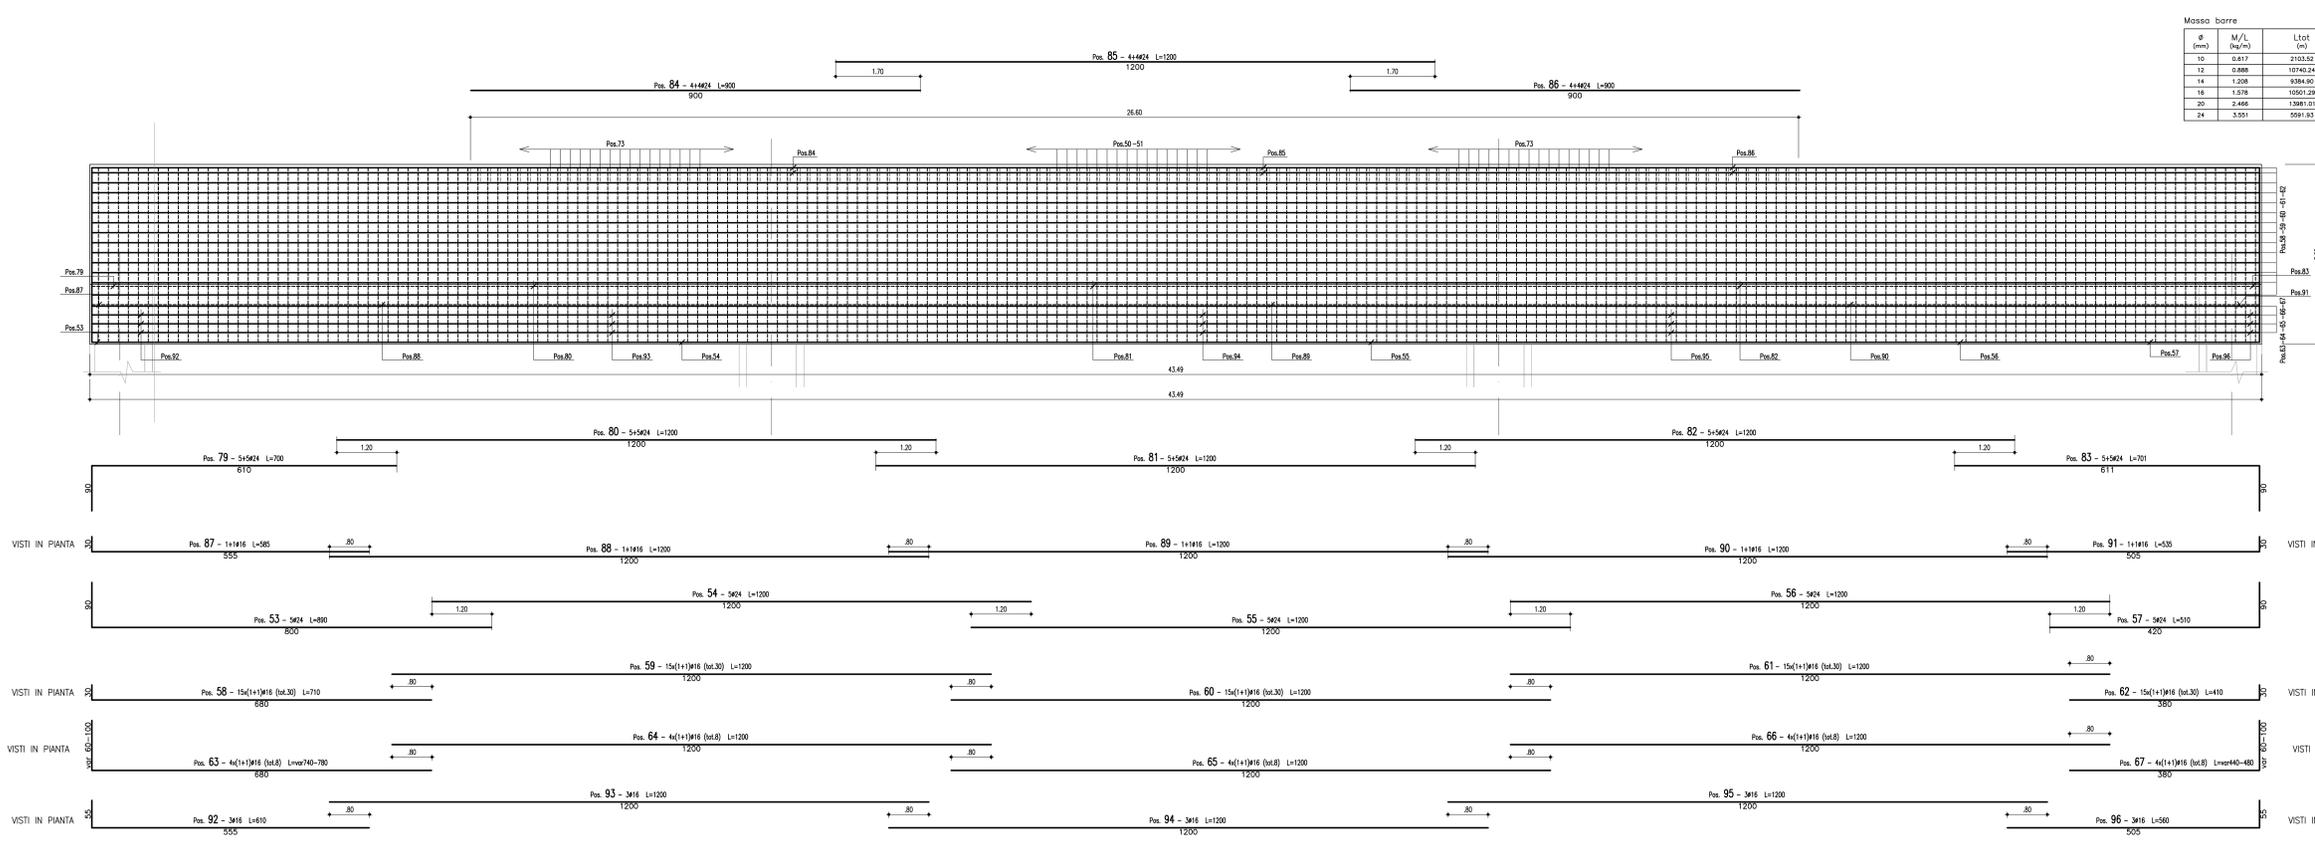


Table with columns: Sagoma, Pos., Ø (mm), nb, A (cm²), B (cm), C (cm), D (cm), E (cm), F (cm), G (cm), H (cm), I (cm), J (cm), L (cm), Ltot (cm), Note. It lists reinforcement data for various bar positions.

Table titled 'Mossa barre' with columns: Ø (mm), M/L (kg/m), Ltot (m), Mtot (kg). It provides weight and length data for different bar sizes.

Table titled 'MATRICE DI REVISIONE' with columns: REV, DATA, DESCRIZIONE MODIFICA. It is a revision matrix for the project.

Project information block including: COLLEGAMENTO AUTOSTRADALE DALMINE - COMO - VARESE - VALICO DEL GAGGIOLO E OPERE AD ESSI CONNESSE; TRATTA B1, B2, C, D, FV13+14, GREENWAY; AS BUILT; OPERE D'ARTE MAGGIORI; GALLERIE ARTIFICIALI; GALLERIA ARTIFICIALE LOMAZZO; ARMATURA CONCO S - TAV 22. Includes logos for STRABAG, ICM, and 3TI ITALIA S.p.A.