



| | |
|---|-----------------------|
| GENERAL LAYOUT AREA -1- | LDL 001 (P-0001) |
| STEAM TURBINE AREA PLAN FROM EL. 400 TO EL. 9.900 | LDL 004 Sh.1 (R-0001) |
| STEAM TURBINE AREA PLAN FROM EL. 9.900 TO ABOVE | LDL 004 Sh.2 (R-0002) |
| STEAM TURBINE AREA SECTIONS A-A B-B C-C | LDL 004 Sh.3 (R-0003) |
| GAS TURBINE HALL AND BOILERS AREA PLAN | LDL 005 Sh.1 (R-0004) |
| GAS TURBINE HALL AND BOILERS AREA SECTIONS | LDL 005 Sh.2 (R-0005) |
| SEA WATER PUMPSTATION AND CHLORINATION PLAN | LDL 006 Sh.1 (R-0006) |
| SEA WATER PUMPSTATION AND CHLORINATION SECTIONS | LDL 006 Sh.2 (R-0007) |
| SWITCHGEAR ROOM PLAN | LDL 007 Sh.1 (R-0008) |
| SWITCHGEAR ROOM SECTIONS | LDL 007 Sh.2 (R-0009) |

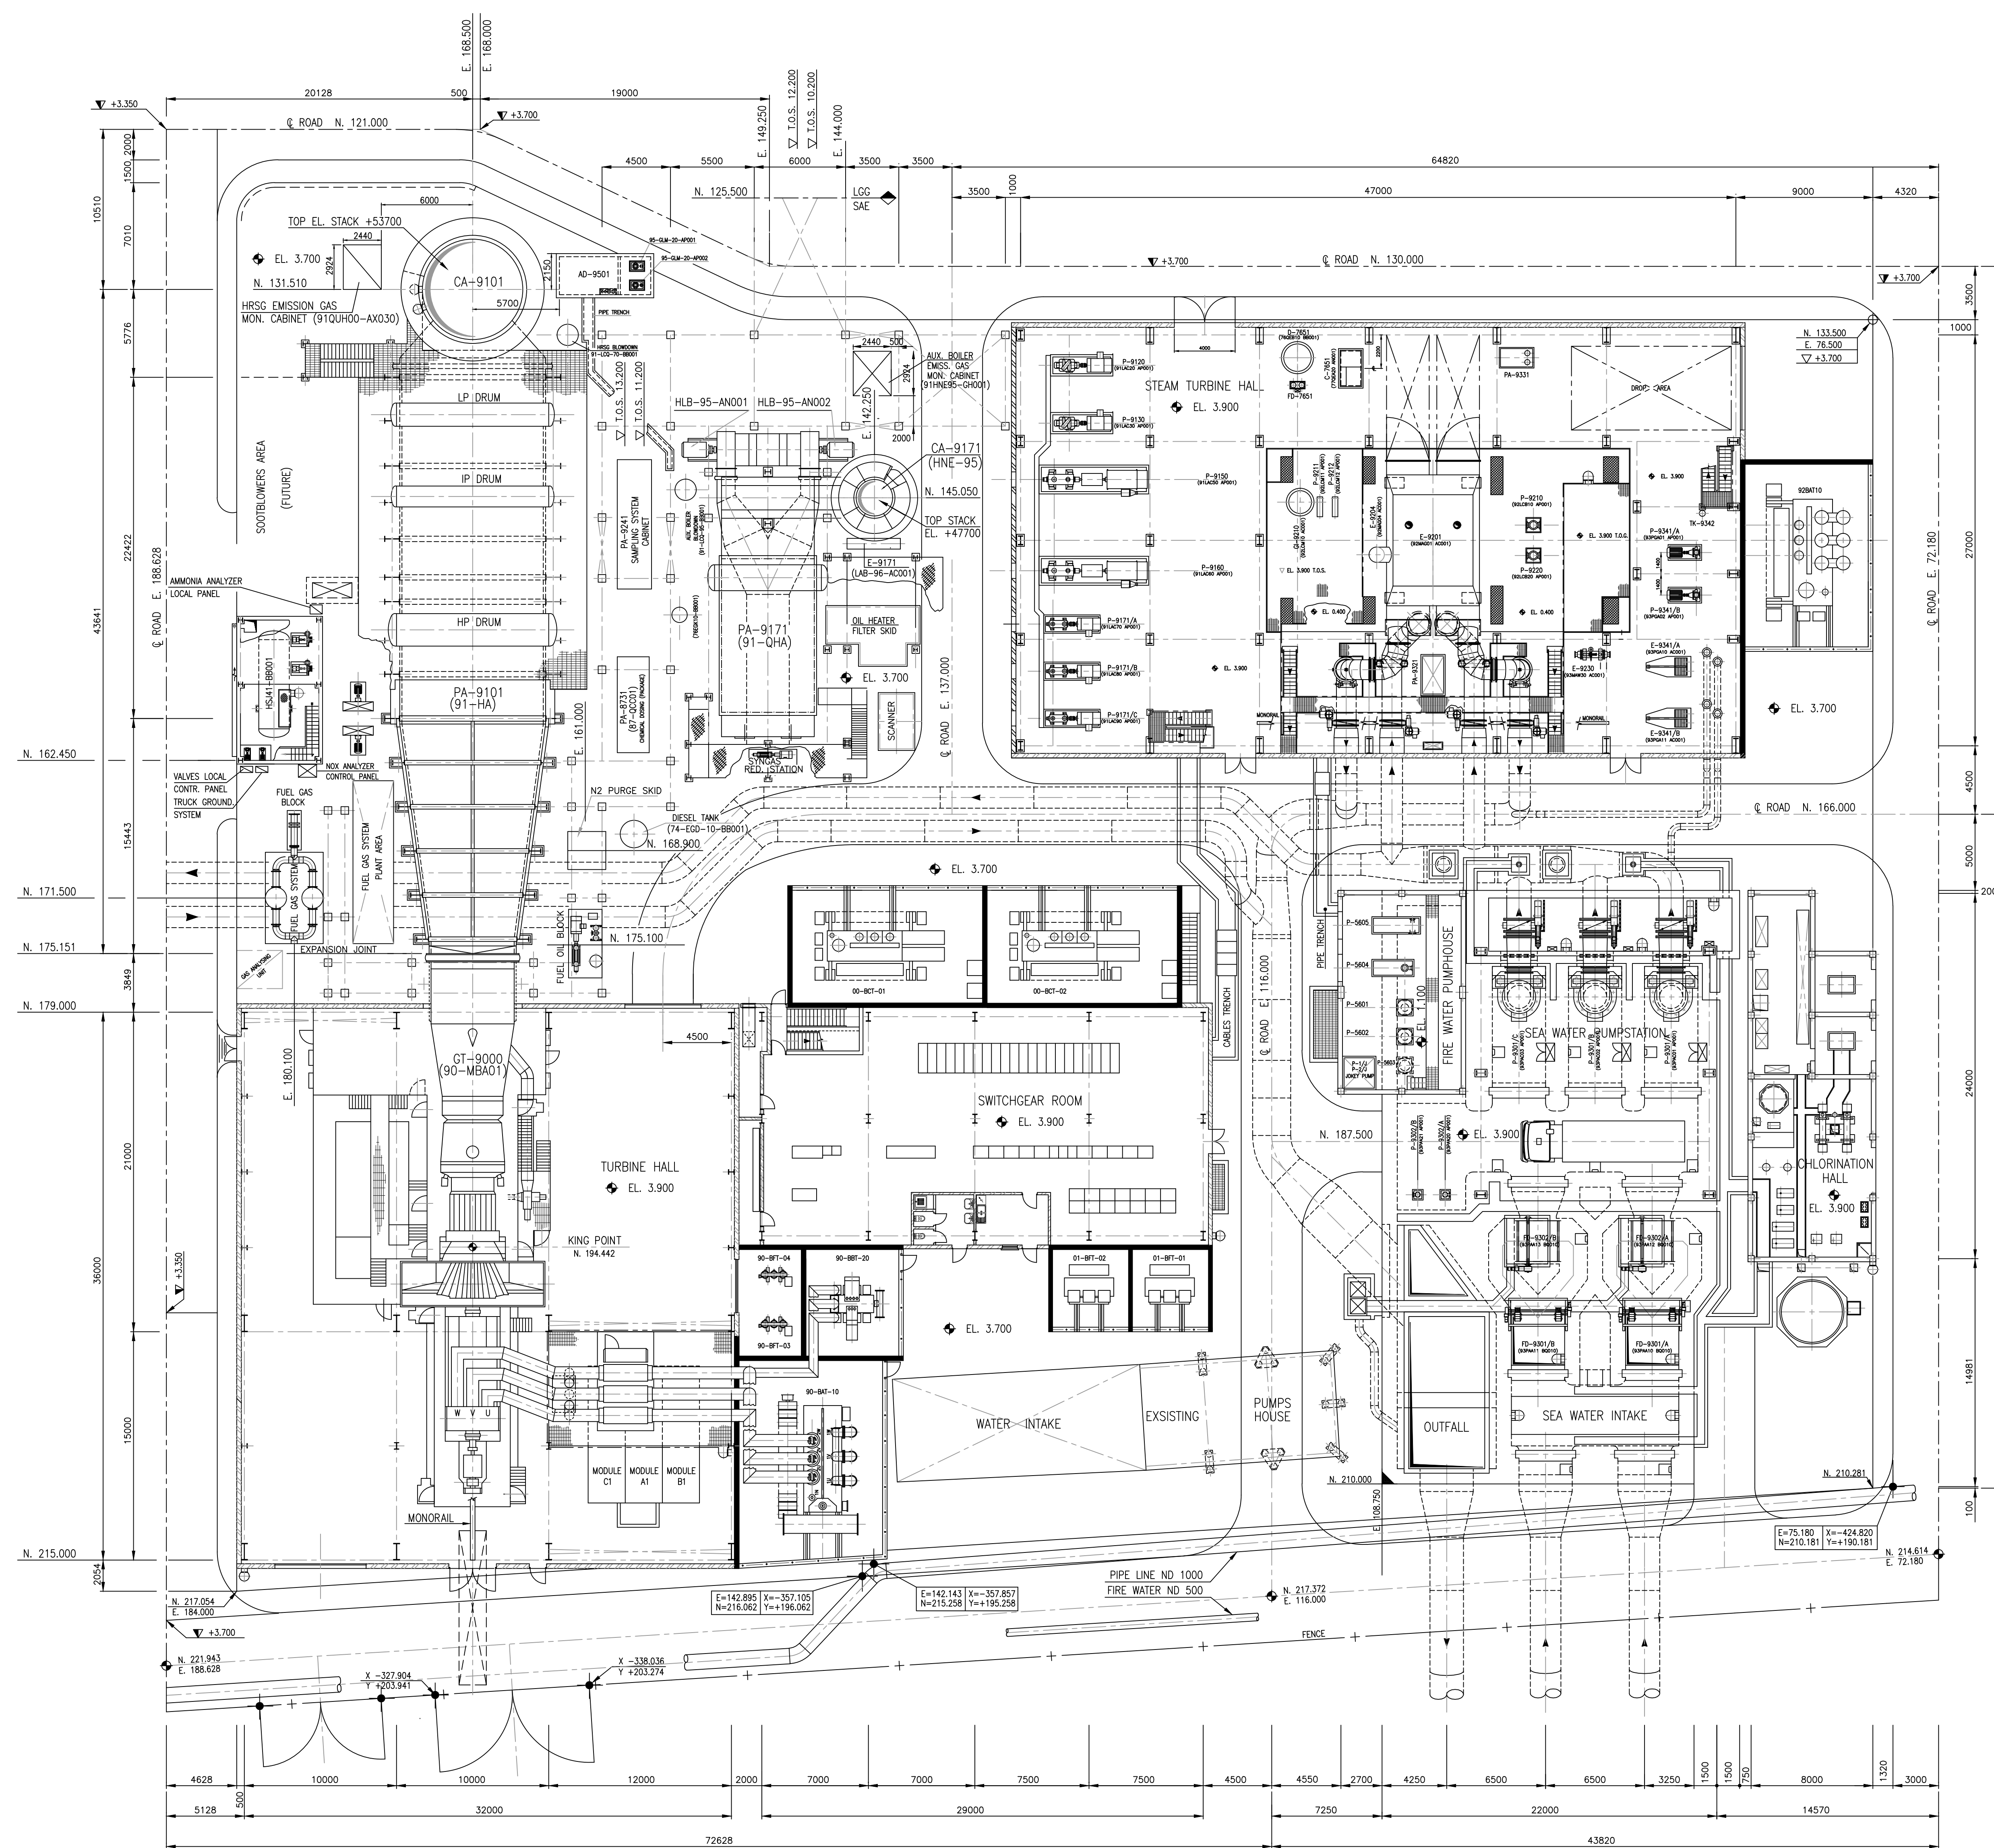

| | |
|--|--|
| REV. A ISSUED FOR APPROVAL DATE 27-06-96 DO NOT USE FOR CONSTRUCTION | REV. B ISSUED FOR APPROVAL DATE 10-06-97 DO NOT USE FOR CONSTRUCTION |
| REV. "C" APPROVED FOR CONSTRUCTION APPROVED BY F.W.I. FAX No. 2.1.313 DATED 07/08/97 | REV. "D" APPROVED FOR CONSTRUCTION APPROVED BY F.W.I. FAX No. 2.1.313 DATED 07/08/97 |
| REV. "E" APPROVED FOR CONSTRUCTION APPROVED BY F.W.I. FAX No. 2.1.313 DATED 07/08/97 | REV. "F" APPROVED FOR CONSTRUCTION APPROVED BY F.W.I. FAX No. 2.1.313 DATED 07/08/97 |

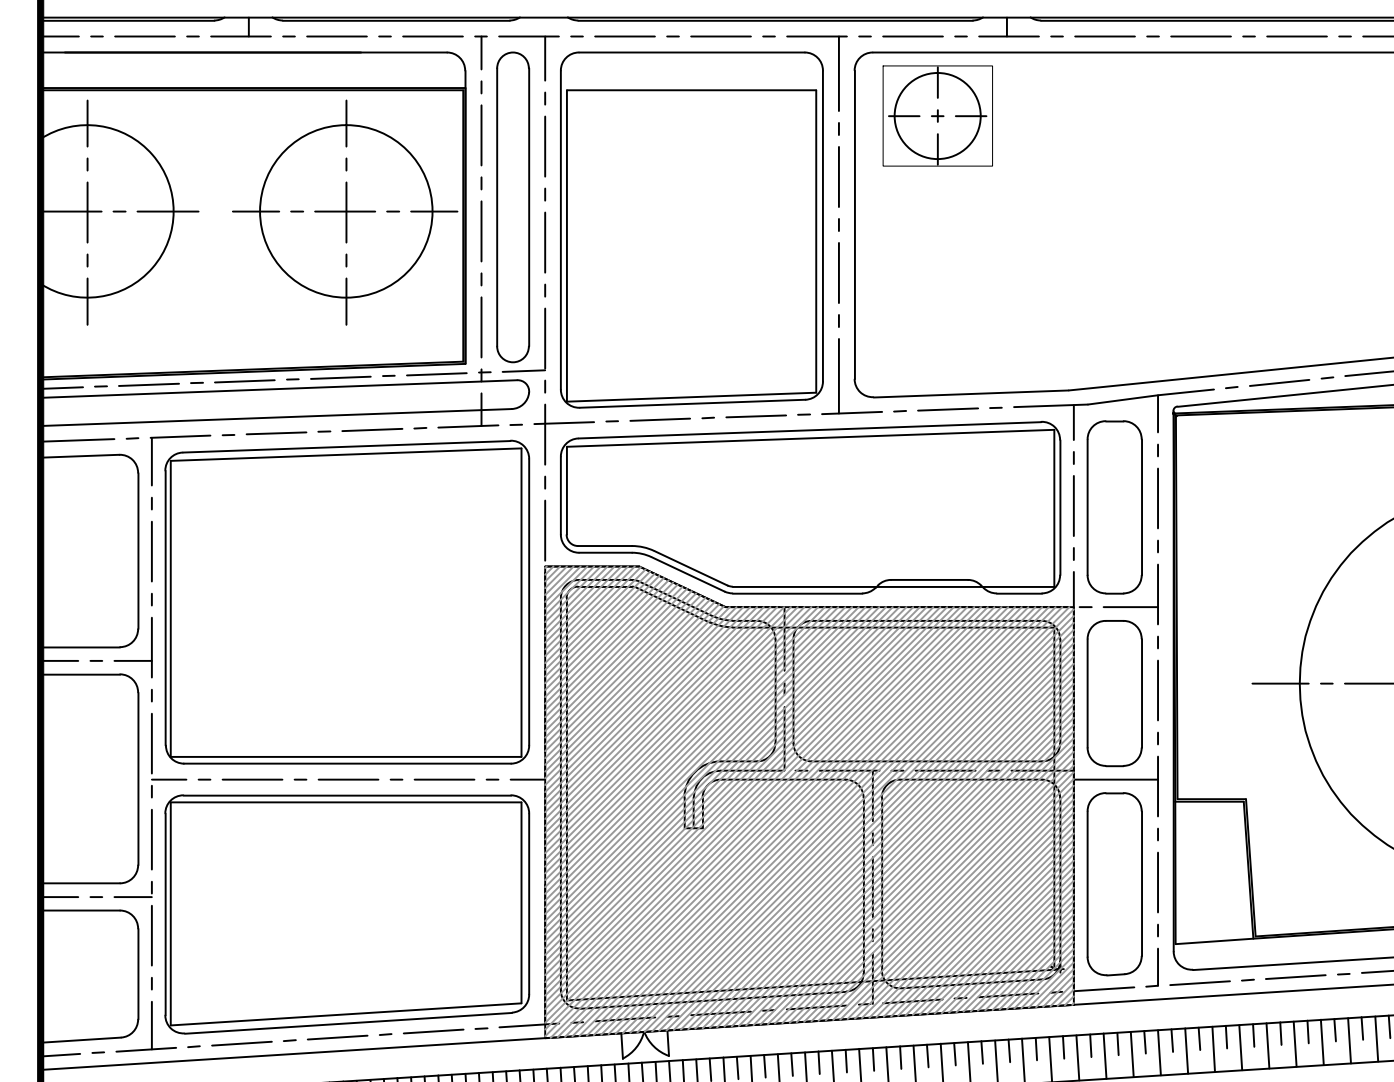

| REV. | DATE | DESCRIPTION | DRAWN | CHECKED | APPROVED |
|------|----------|---|----------|---------|------------|
| I | 03/08/99 | AS BUILT | SANDRI | PROZZI | NEGRİ |
| H | 01/02/99 | REVISED WHERE INDICATED | BELOTTI | BARBERI | TROUBETZKY |
| G | 24/12/98 | REVISED WHERE INDICATED | BELOTTI | BARBERI | TROUBETZKY |
| F | 26/06/98 | REVISED WHERE INDICATED | BELOTTI | BARBERI | TROUBETZKY |
| E | 06/04/98 | REVISED WHERE INDICATED-ADDED VESSEL 782K10-B0001 | BELOTTI | BARBERI | TROUBETZKY |
| D | 26/01/98 | REVISED WHERE INDICATED | BELOTTI | BARBERI | TROUBETZKY |
| C | 21/10/97 | GENERAL REVISION | PROZZI | BARBERI | TROUBETZKY |
| B | 02/07/97 | ISSUED FOR A.F.C. | PROZZI | BARBERI | TROUBETZKY |
| A | 27/06/96 | ISSUED FOR APPROVAL | AUDITORE | BARBERI | LUSURIELLO |

api EMERGA API REFINERY FALCONARA - ITALY
INTEGRATED GASIFICATION AND COMBINED CYCLE PROJECT

ABB TEMPORARY ASSOCIATION OF COMPANIES:
ABB SAE SADELMİ MILAN ITALY
ABB LUMMUS CREST WIESBADEN GERMANY
ABB POWER GENERATION BADEN SWITZERLAND

THE DRAWINGS, SPECIFICATIONS, CALCULATIONS AND ALL OTHER MATERIALS AND INFORMATION CONTAINED IN AND SUBMITTED WITH THIS DOCUMENT ARE THE PROPERTY OF ABB SAE SADELMİ SPA AND CONFIDENTIAL BY RECEIPT OF THIS DOCUMENT YOU AGREE NOT TO REPRODUCE IT IN WHOLE OR IN PART MAY BEGAIN ITS CONTENTS EXCEPT TO MEMBERS OF YOUR COMPANY WHO HAVE A NEED TO KNOW.

| | |
|-----------------|--------------------------------------|
| SCALE | 1=200 |
| FORM SIZE | A0 2 3 7 2 0 0 0 0 0 0 0 0 0 0 0 2 1 |
| JOB NUMBER | 21372 |
| ORIG. | A |
| SUBJECT | H |
| SOC. | P |
| DOCUMENT NUMBER | 0000 |
| REV. | 02 |
| SHEET | 1 |
| OF | 1 |

POWER AREA LAYOUT

DATE: 02/05/96

SCALE: 1=200

FORM SIZE: A0 2 3 7 2 0 0 0 0 0 0 0 0 0 0 0 2 1

JOB NUMBER: 21372

ORIG.: A

SUBJECT: H


SOC.: P


DOCUMENT NUMBER: 0000


REV.: 02

SHEET: 1

OF: 1

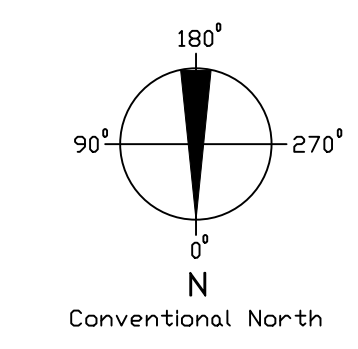

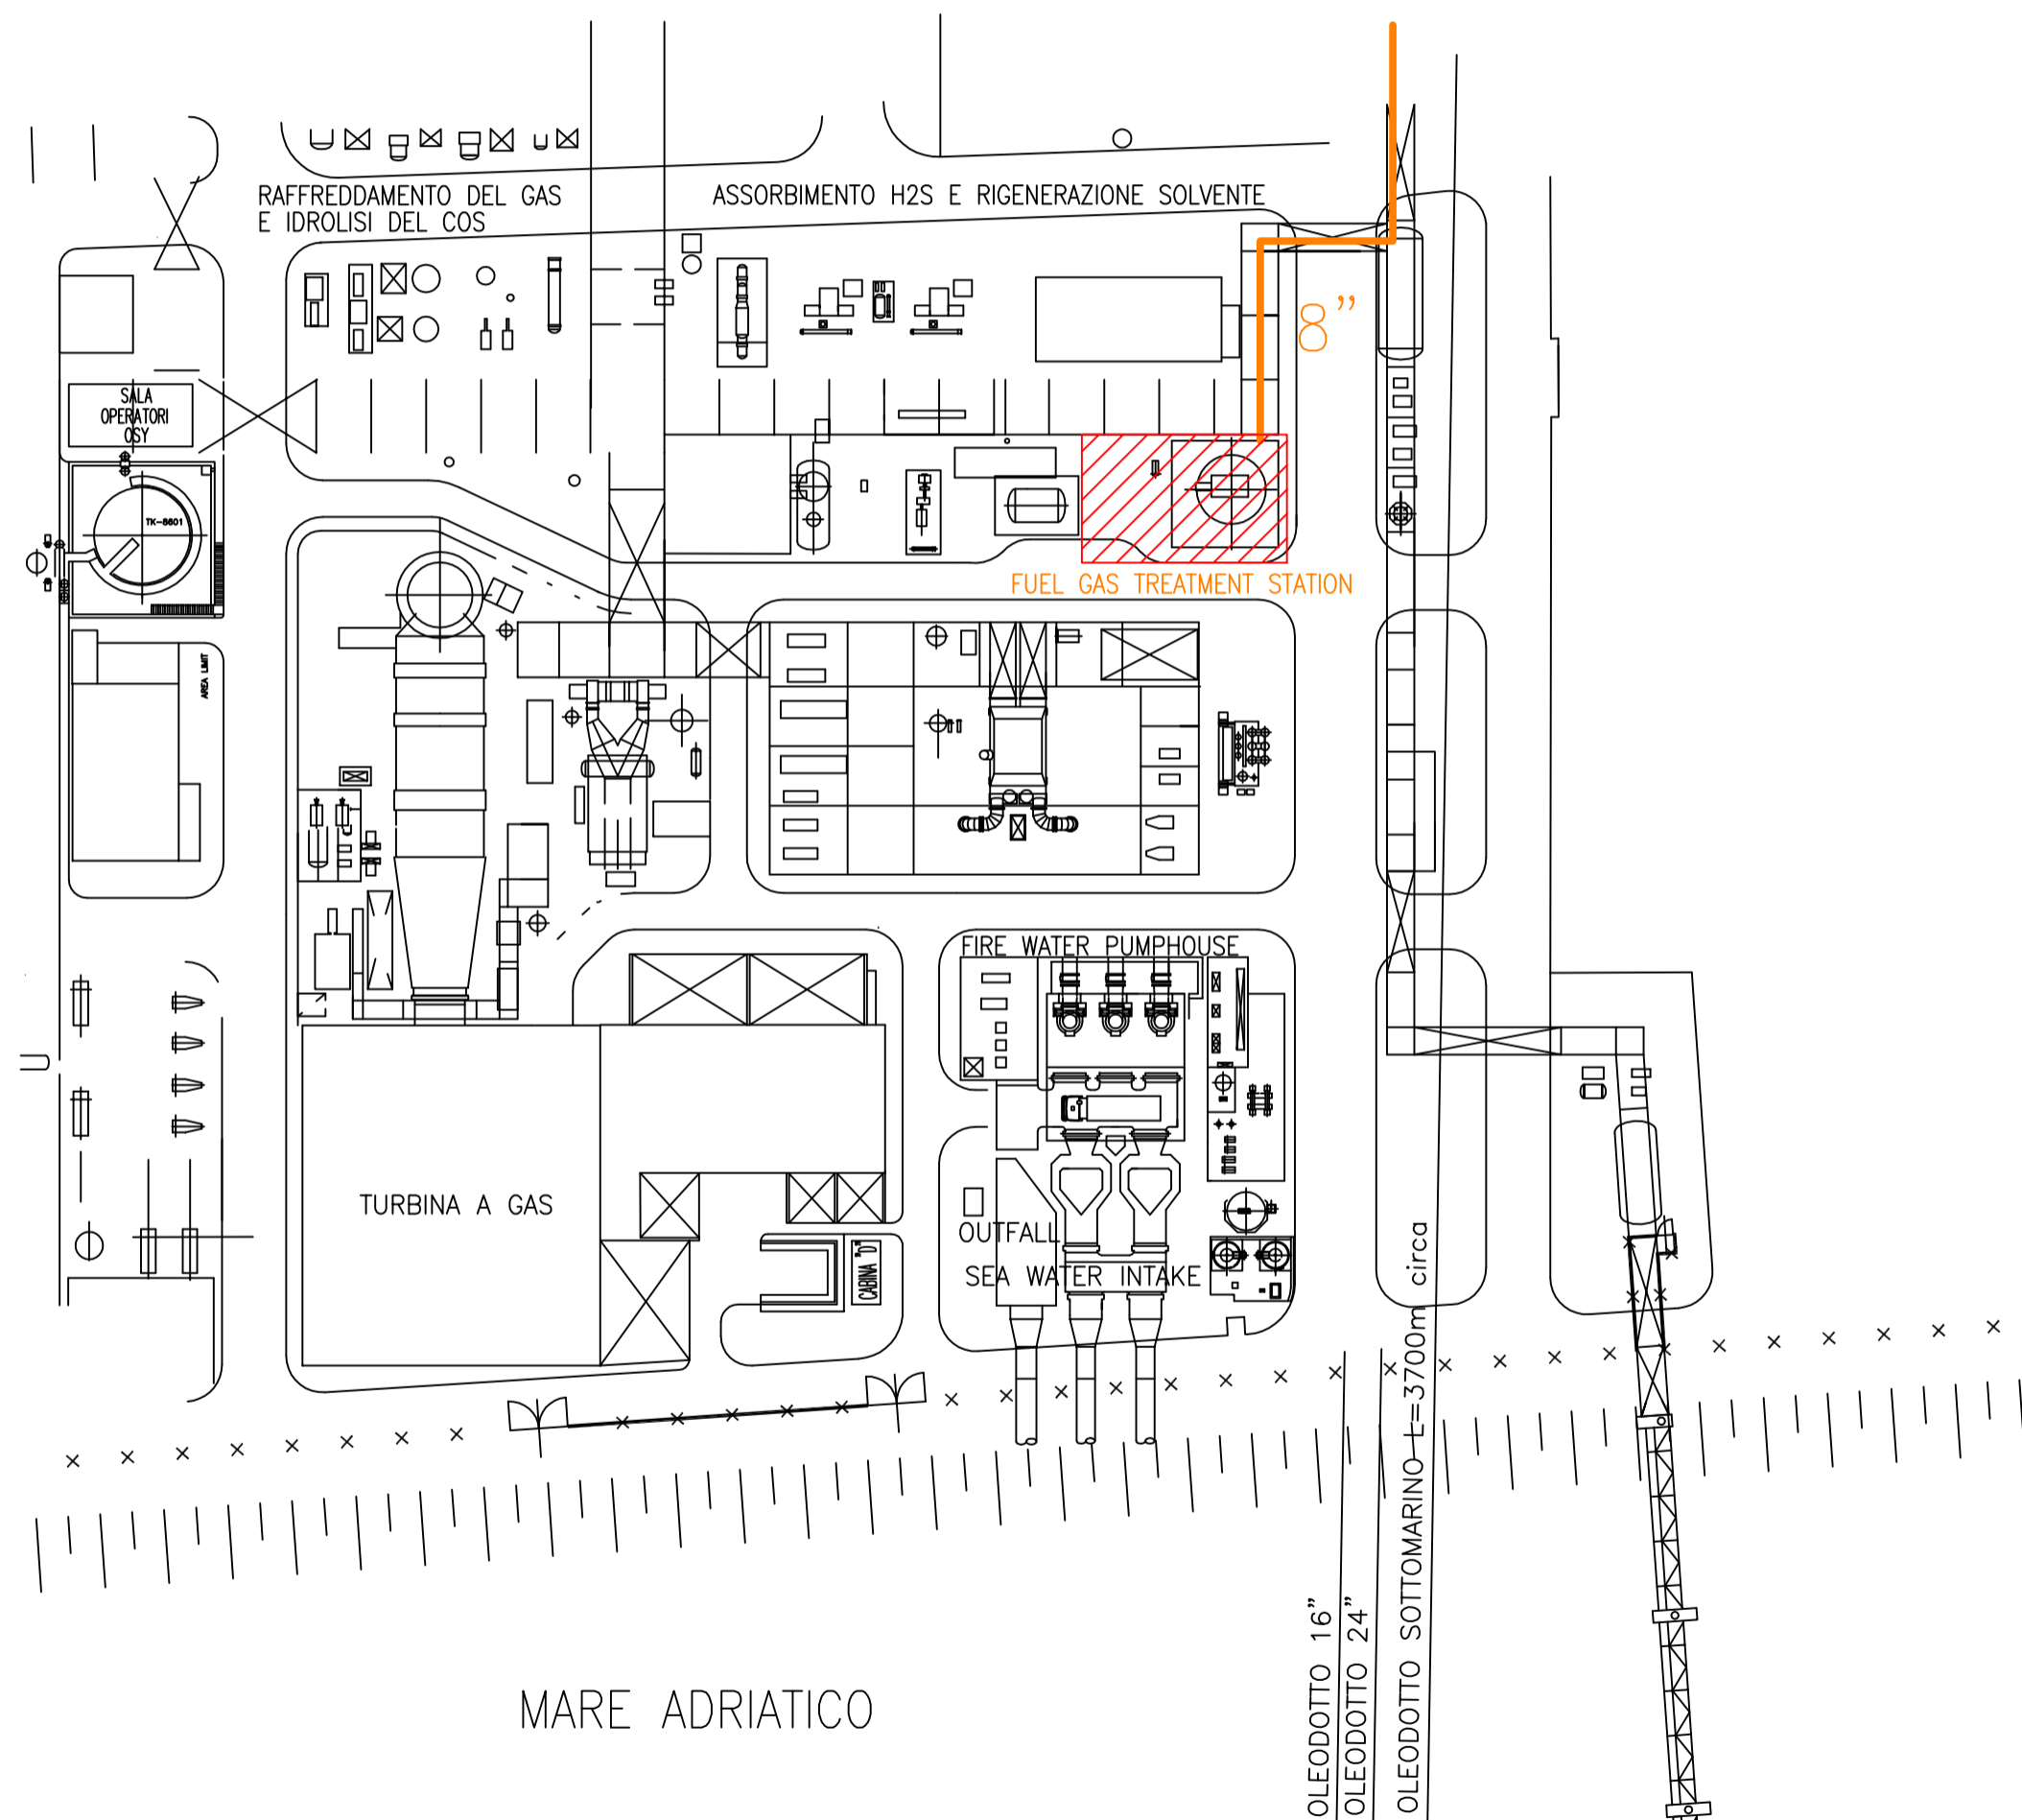

| | | | | | | | | | | |
|---|--|---|-----------------|-------|--------------------|------|----------|---|--|--|
|  | | API REFINERY FALCONARA-ITALY CCPP NATURAL GAS CONVERSION | | | | | | | | |
| | | AREA INSERIMENTO FGTS STRALCIO | | | | | | | | |
| DISEGNATO | | | | | | | ZUCCHI | | | |
| CONTROLLATO | | | | | | | PIACENTE | | | |
| APPROVATO | | | | | | | LODATO | | | |
| NOME CAD | | | | | | | - | | | |
| DATA | | 20/06/12 | | | | | | | | |
| SCALA | | UNITA' | GRUPPO ARCHIVIO | FORM. | NUMERO DISEGNO API | REV. | FOGLIO | 1 | | |
| | | | | | | | DI | 1 | | |