
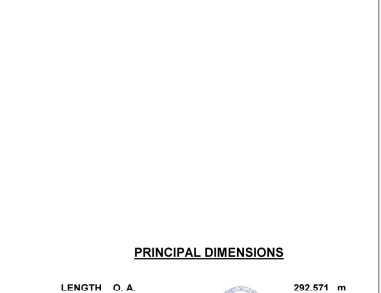
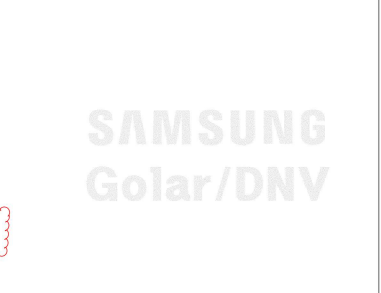
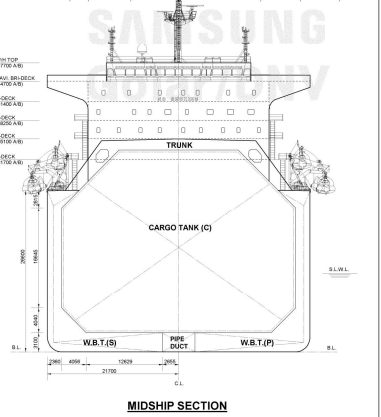
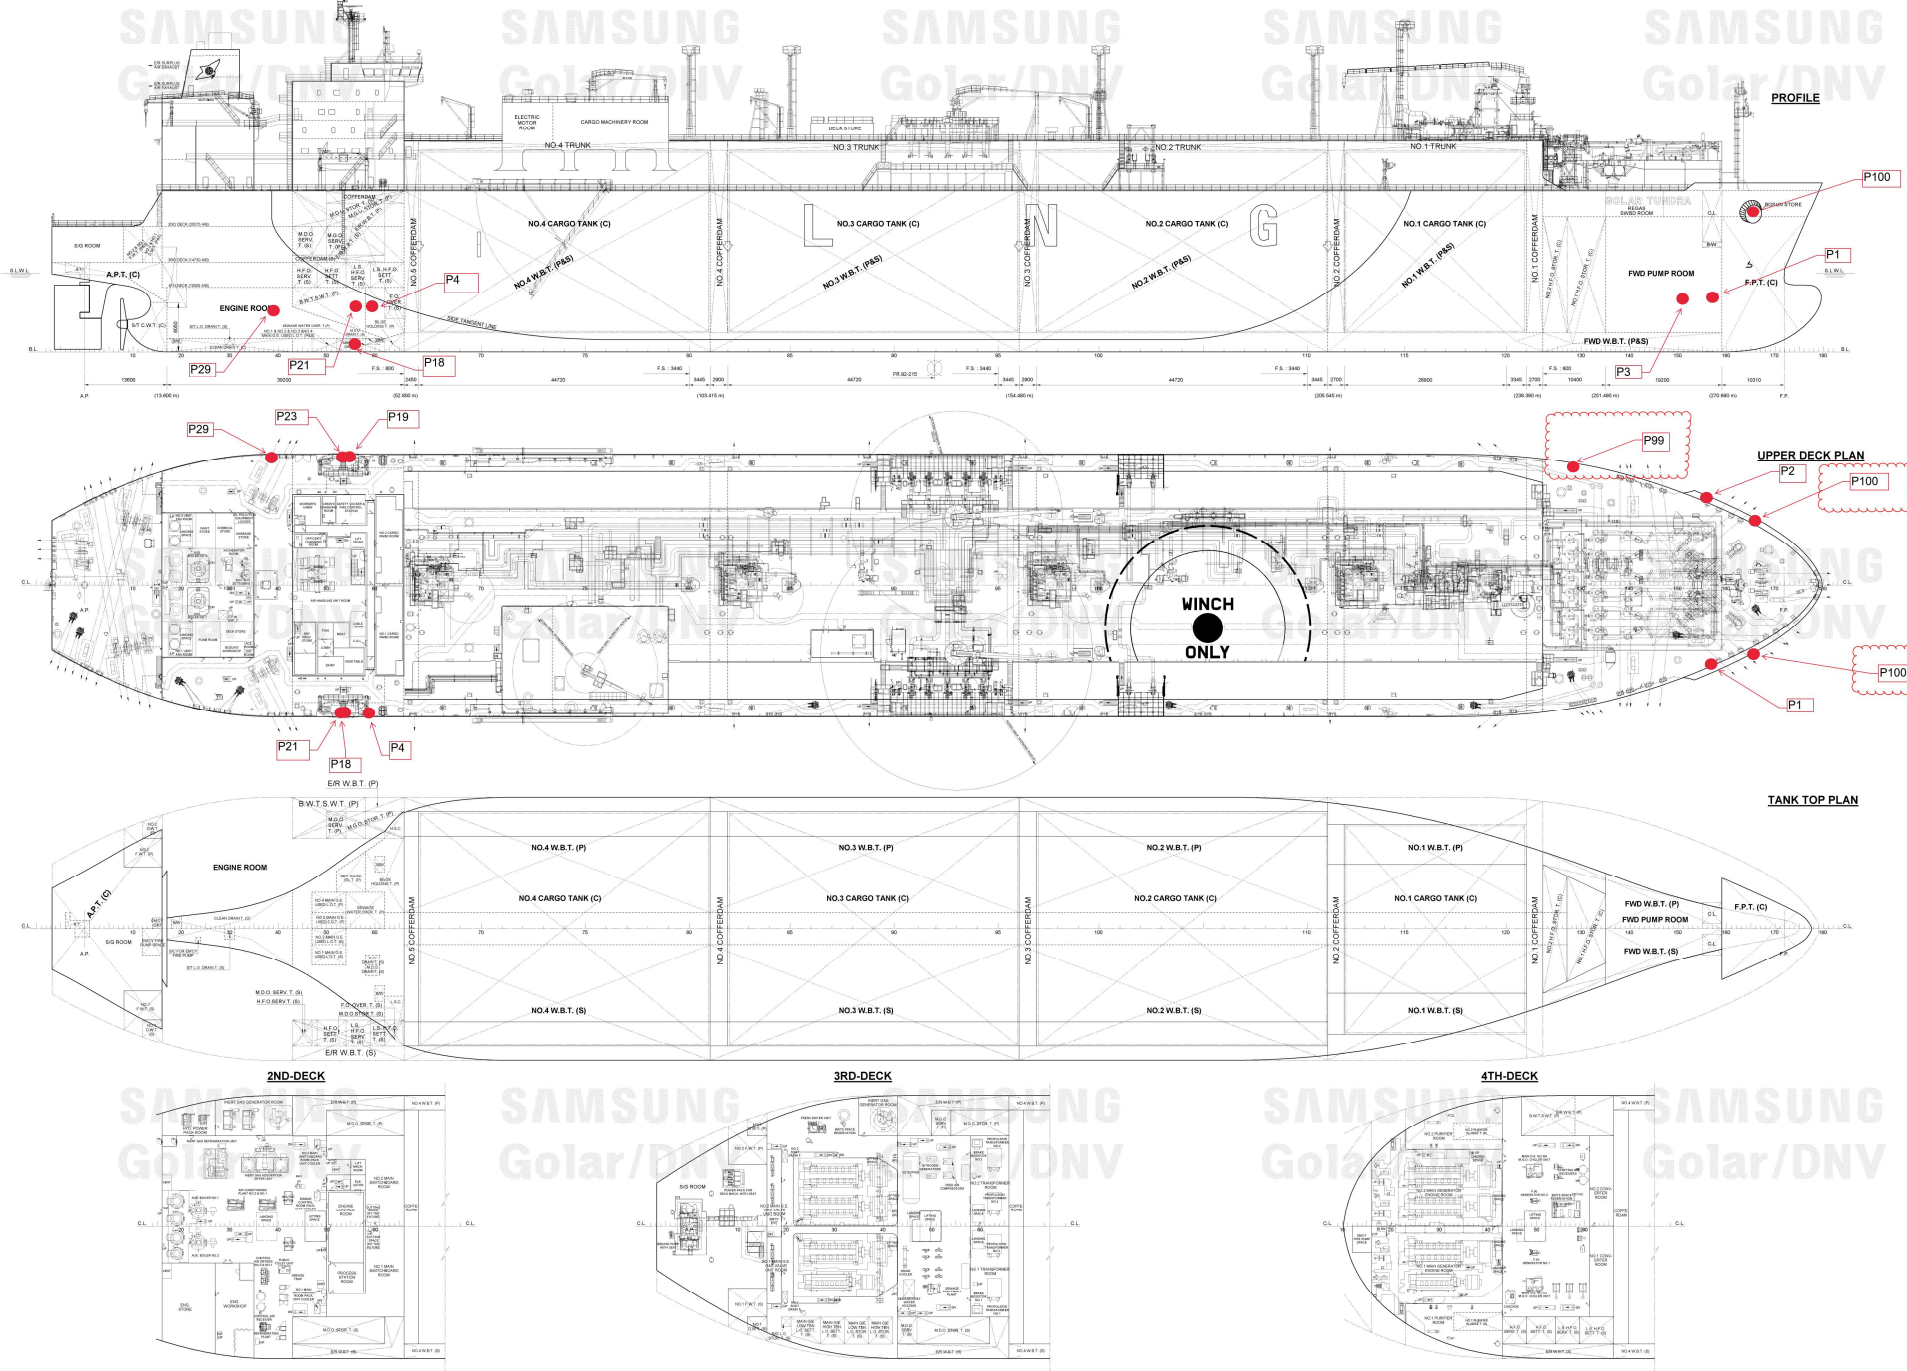


GENERAL ARRANGEMENT

PLAN HISTORY				
Rev.	Issued Date	Reason for Issue	Prepared by	Checked by
1	17 April 2013	Prepared by General Design	Y. C. Jiang	D. Y. Kang
A	19 June 2012	Updated for Lubeoil and Flue gas system	H. J. Kim	D. Y. Kang
B	26 Oct. 2012	Updated for Lifeboat	H. J. Kim	D. Y. Kang
C	26 June 2013	Updated for Final Version	W. H. Jiang	D. Y. Kang
D	08 Oct. 2013	Updated for DNV's Final Version	W. H. Jiang	D. Y. Kang
E	20 Sep. 2016	Revised for Buyer's Request	W. H. Jiang	H. S. Kim

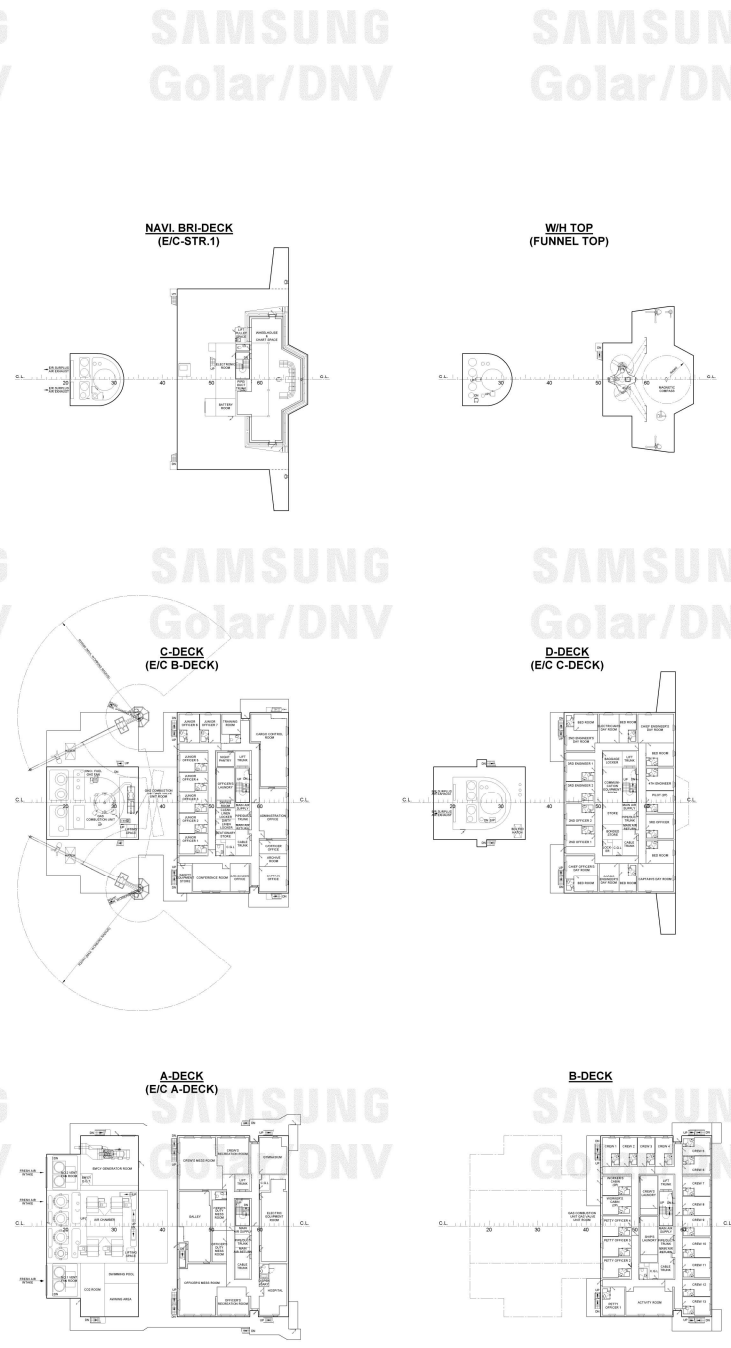

PRINCIPAL DIMENSIONS				
LENGTH	B. P.	281.0	m	
BREADTH (MOULDED)		43.4	m	
2	AGOSTO 2023	EMESSO PER ENTI		
1	NOVEMBRE 2022	EMESSO PER ENTI		
0	PROGETTO INIZIALE	EMESSO PER ENTI		
REV.	DATA	REVISIONE		
DOCUMENTAZIONE TECNICA ALLEGATA ALLA DOMANDA AIA				
ALLEGATO B.21 PLANIMETRIA RETI FOGNARIE, DEI SISTEMI DI TRATTAMENTO, DEI PUNTI DI EMISSIONE DEGLI SCARICHI LIQUIDI E DELLA RETE PIEZOMETRICA				
P0003106-L0111	Rev.	Rev.	2	1.6.1