


## ELENCO SCARICHI FINALI, POZZETTI DI CONTROLLO E RELATIVA GEOREFERENZIAZIONE

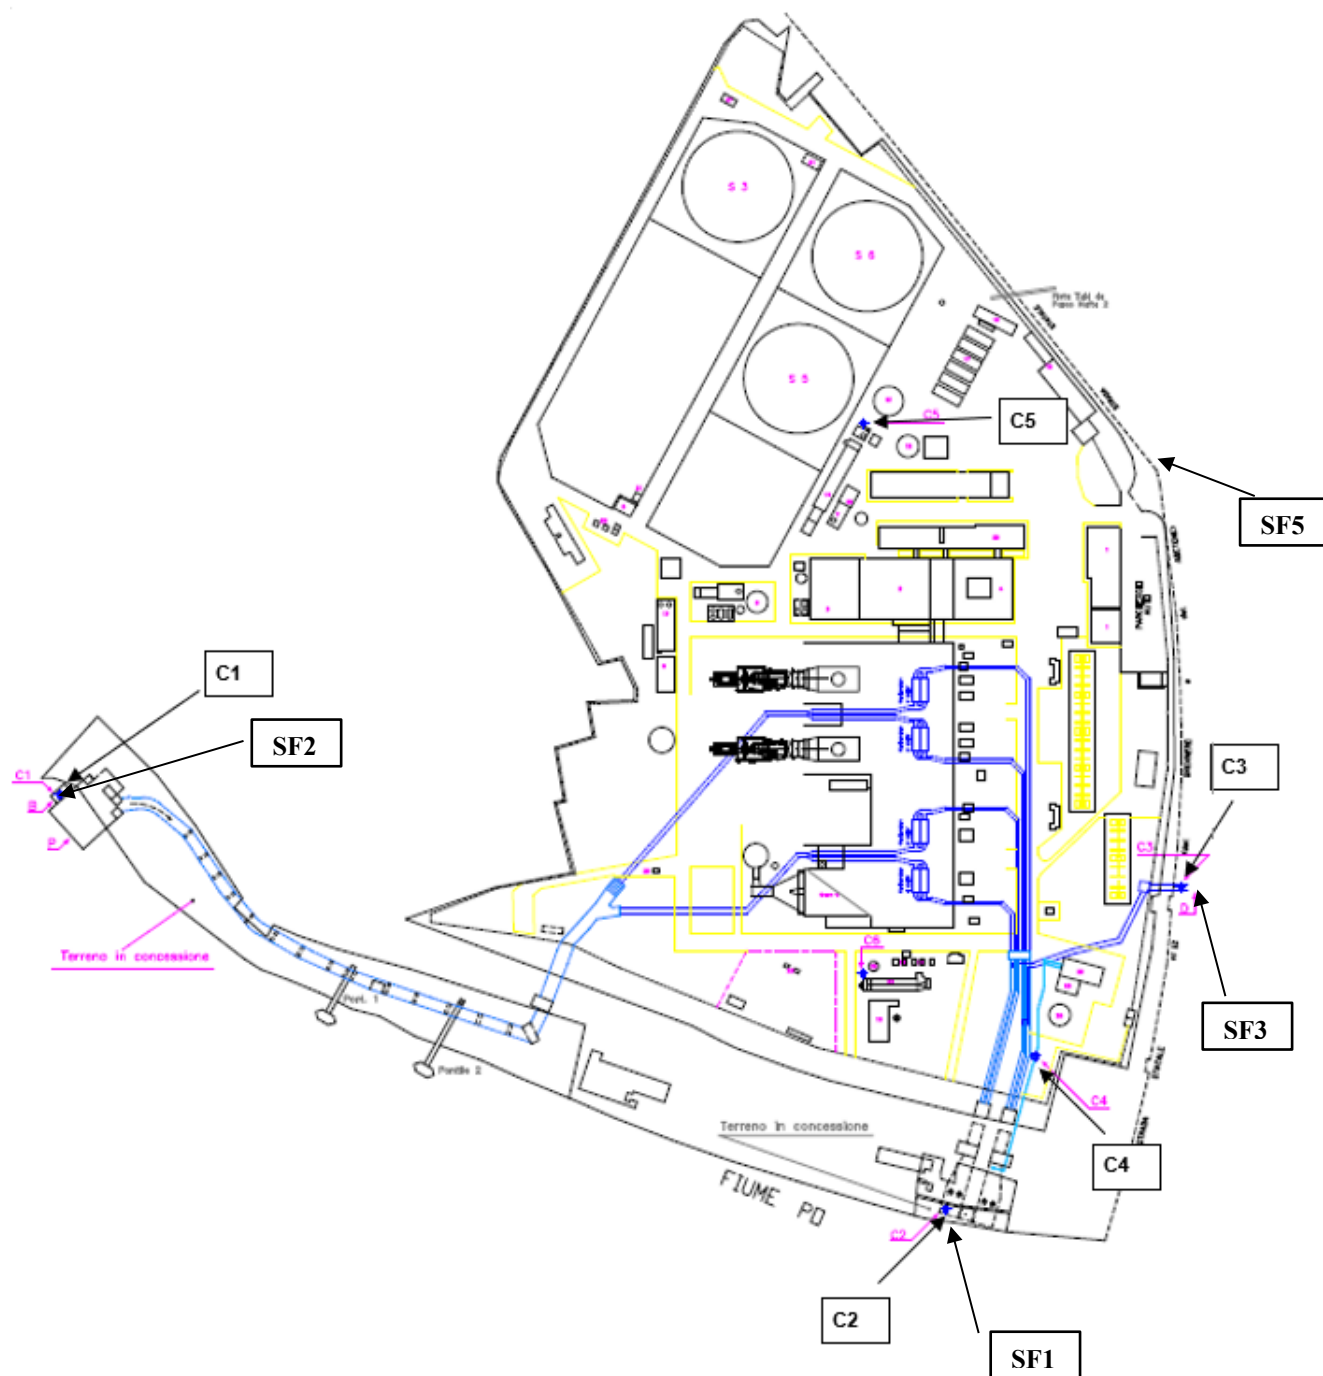

Scarico Finale	Coordinate WGS-UTM32	
	X	Y
SF 1	668.209 m	4.991.57 m
SF 2	667.873 m	4.992.08 m
SF 3	668.428 m	4.991.70 m
SF 5	668.433 m	4.992.25 m

Punto di controllo	Coordinate WGS-UTM32	
	X	Y
C 1	667.873 m	4.992.08 m
C 2	668.209 m	4.991.57 m
C 3	668.428 m	4.991.70 m
C 4	668.319 m	4.991.65 m
C 5	668.427 m	4.992.02 m