


LEGENDA

- Nuova posizione turbina reversibile
- Posizione originale turbina reversibile
- ▭ Centrale Idroelettrica
- Condotta forzata
- Pozzo piezometrico
- ⋯ Confini comunali

Note:
 (1) Allo stato attuale il territorio comunale di Ollolai non risulta coperto dall'aggiornamento cartografico del Database geotopografico alla scala 1:10.000 (DBGT 10K 2020)

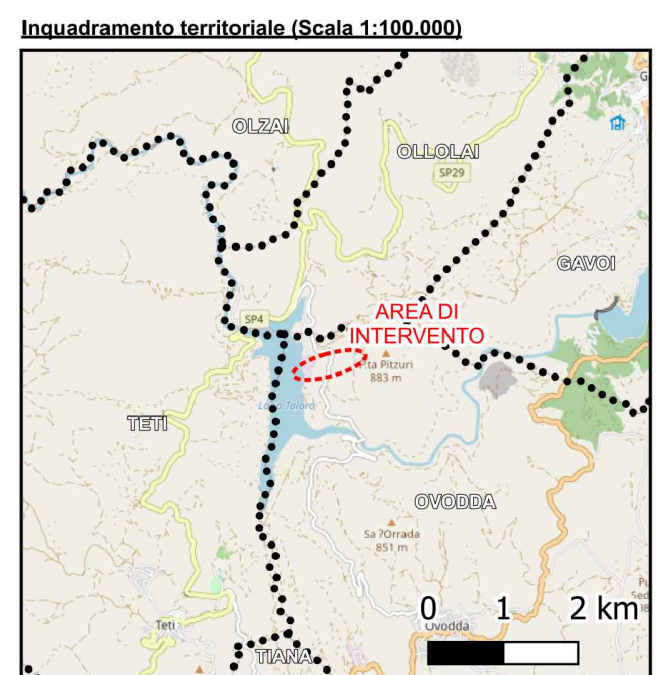

			CONTRACTOR'S LOGO			PROJECT: CUCCHINADORZA			enel			GRE VALIDATION			UTILIZATION SCOPE			TITLE:		
			studio TECHNE			FILE NAME: All.1 Localizz DBGT.pdf						VALIDATED by: Pezzolato			Valutazione preliminare art. 6 co. 9/9-bis DLgs 152/2006			Localizzazione su cartografia derivata dal Database geotopografico (DBGT 10K 2020) della Regione Sardegna		
			VNI PPI NARDI			CLASSIFICATION: Autorizzazione			Design & Execution			VERIFIED by: Munari			GRE CODE					
00 JUN 2024 for issue			PREPARED CHECKED APPROVED			FORMAT: A3 SCALE: grafica PLOT SCALE SHEET:						COLLABORATORS			GROUP FUNCTION TYPE ISSUER COUNTRY TEC. PLANT SYSTEM PROGRESSIVE REVISION					
															GRE EEC D 99 I T H 1 5 6 7 8 0 0 0 3 0 0 0					

This document is property of Enel Green Power SpA. It is strictly forbidden to reproduce this document, in whole or in part, and to provide to others any related information without the previous written consent by Enel Green Power SpA.