


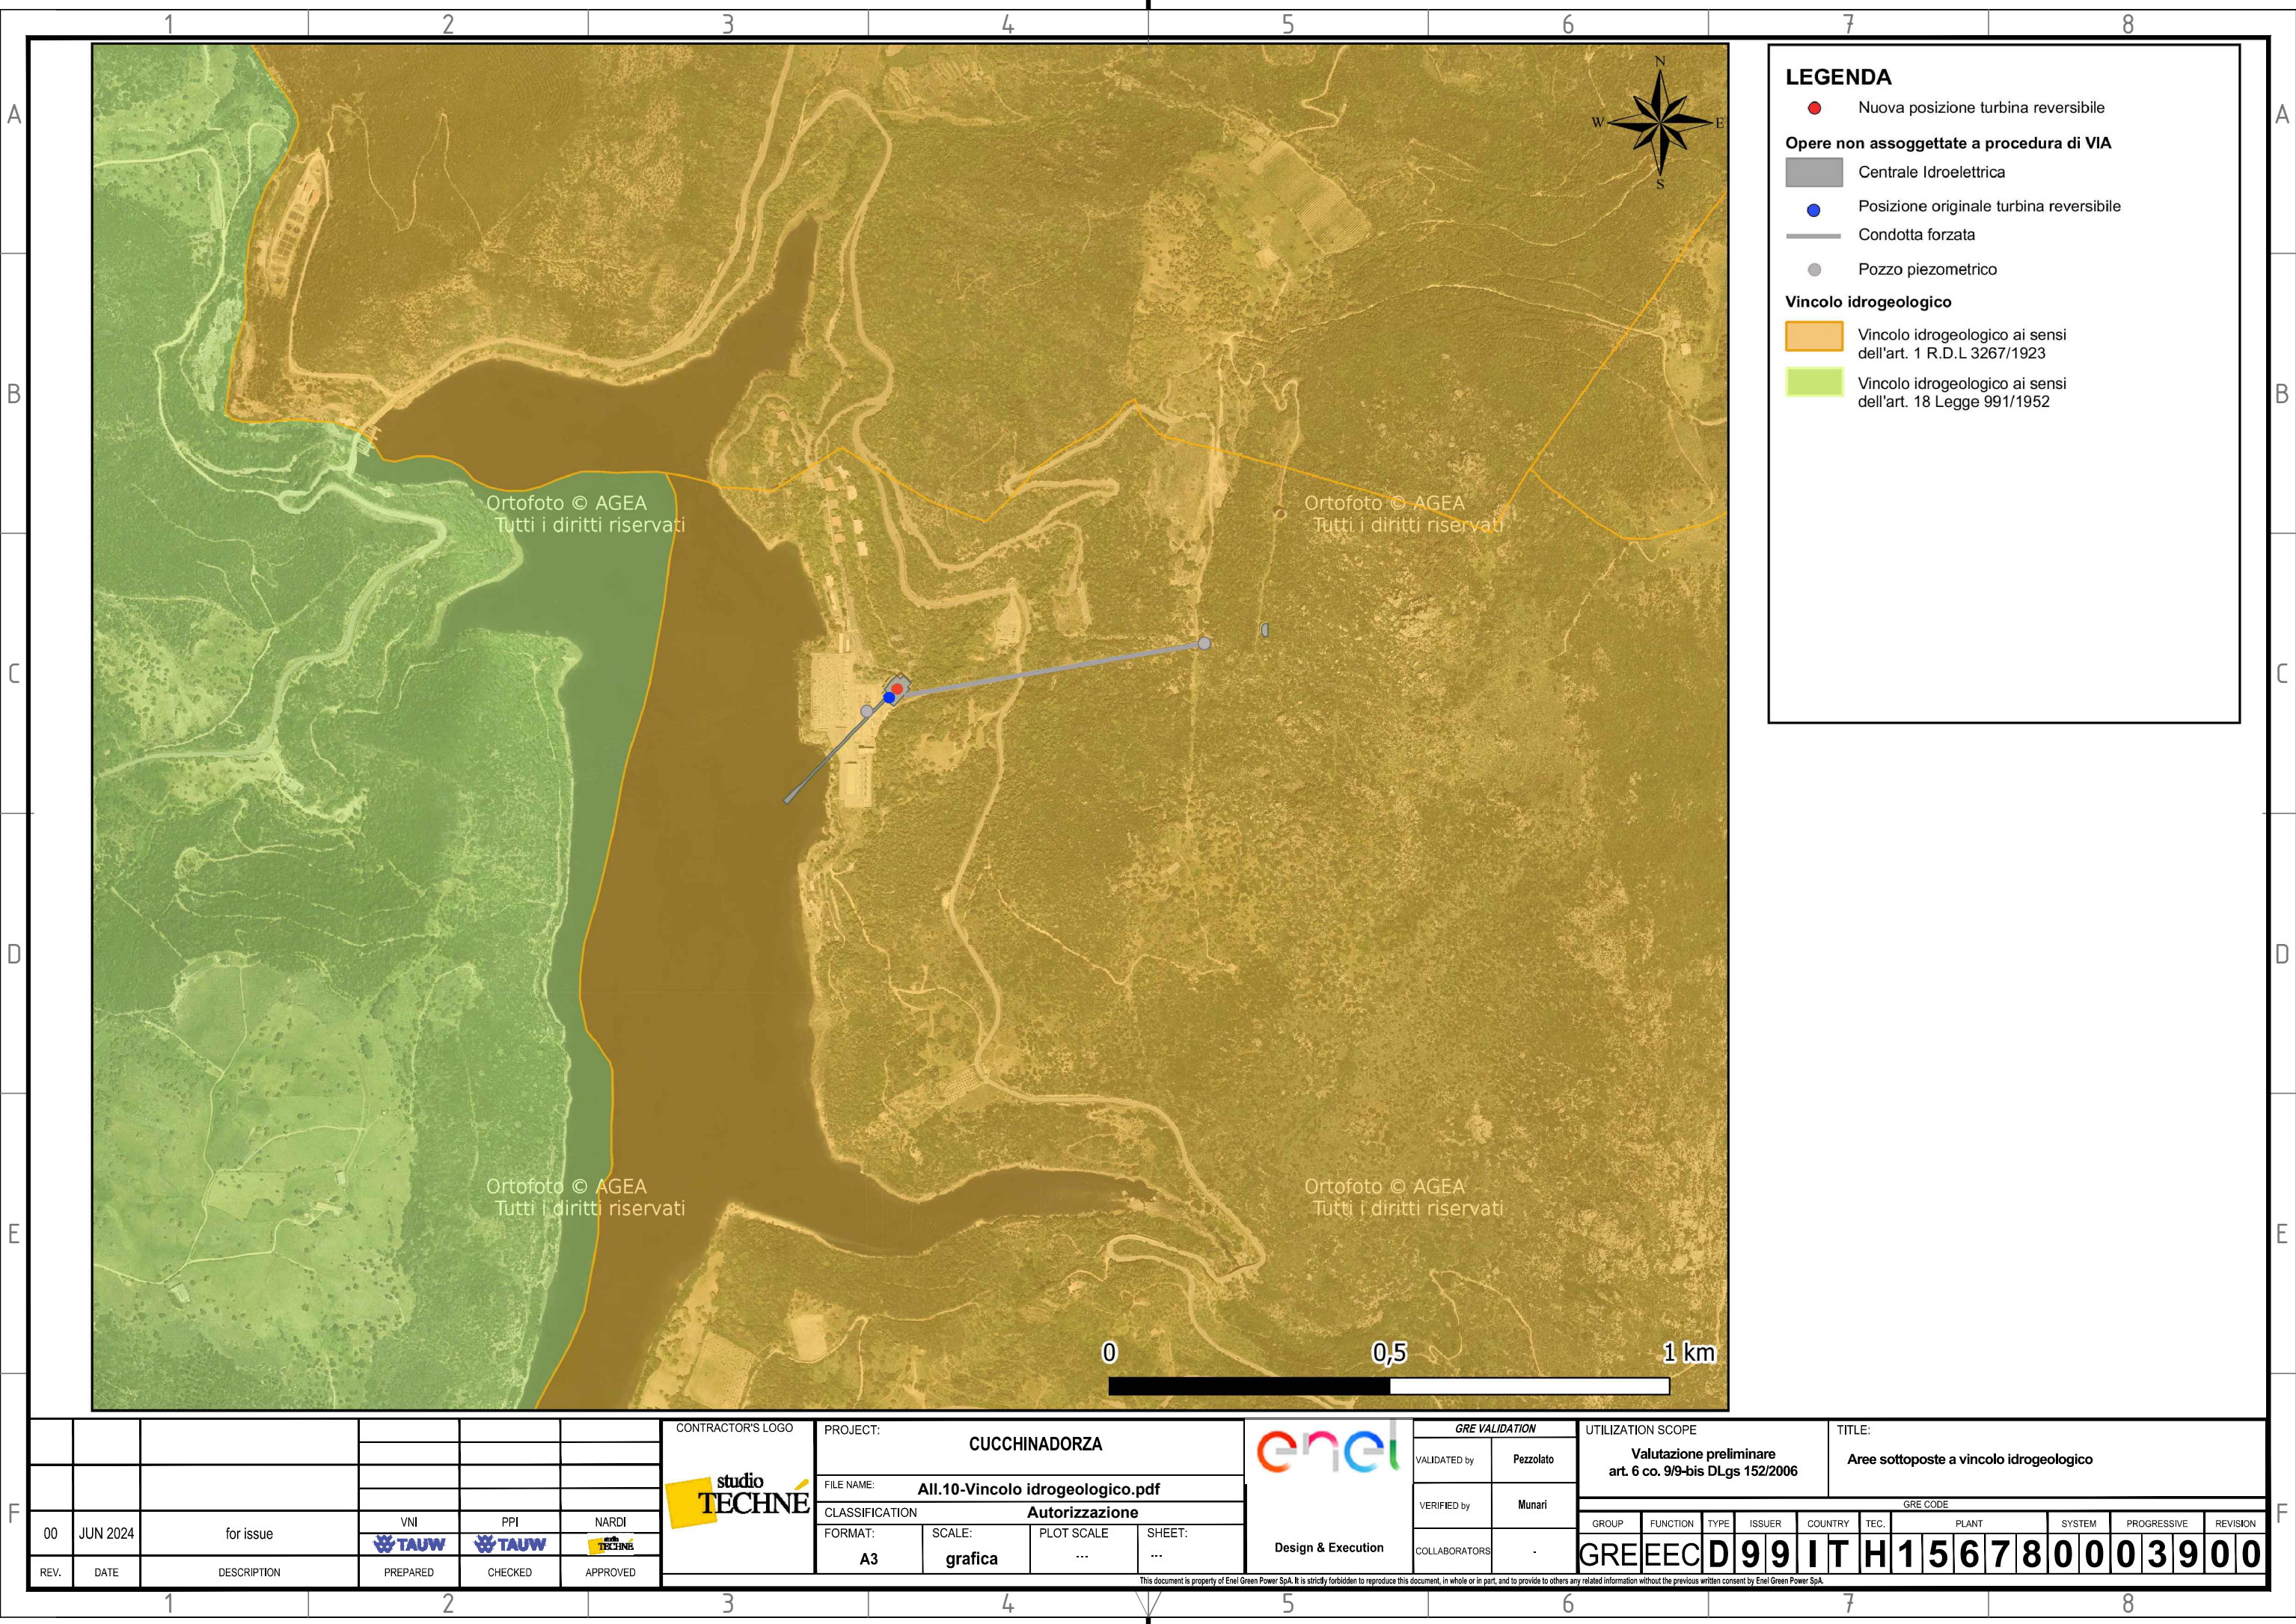

- LEGENDA**
- Nuova posizione turbina reversibile
 - Opere non assoggettate a procedura di VIA
 - Centrale Idroelettrica
 - Posizione originale turbina reversibile
 - Condotta forzata
 - Pozzo piezometrico
 - Vincolo idrogeologico
 - Vincolo idrogeologico ai sensi dell'art. 1 R.D.L 3267/1923
 - Vincolo idrogeologico ai sensi dell'art. 18 Legge 991/1952

						CONTRACTOR'S LOGO	PROJECT: CUCCHINADORZA					GRE VALIDATION		UTILIZATION SCOPE				TITLE:											
							FILE NAME: All.10-Vincolo idrogeologico.pdf					VALIDATED by	Pezzolato	Valutazione preliminare art. 6 co. 9/9-bis DLgs 152/2006				Aree sottoposte a vincolo idrogeologico											
							CLASSIFICATION Autorizzazione					VERIFIED by	Munari	GRE CODE															
00	JUN 2024	for issue	VNI	PPI	NARDI		FORMAT:	SCALE:	PLOT SCALE	SHEET:		Design & Execution	COLLABORATORS	-	GROUP	FUNCTION	TYPE	ISSUER	COUNTRY	TEC.	PLANT	SYSTEM	PROGRESSIVE	REVISION					
REV.	DATE	DESCRIPTION	PREPARED	CHECKED	APPROVED		A3	grafica	...	...			GRE	EEC	D	9	9	I	T	H	1	5	6	7	8	0	0	0	3

This document is property of Enel Green Power SpA. It is strictly forbidden to reproduce this document, in whole or in part, and to provide to others any related information without the previous written consent by Enel Green Power SpA.

This document is property of Enel Green Power SpA. It is strictly forbidden to reproduce this document, in whole or in part, and to provide to others any related information without the previous written consent by Enel Green Power SpA.