

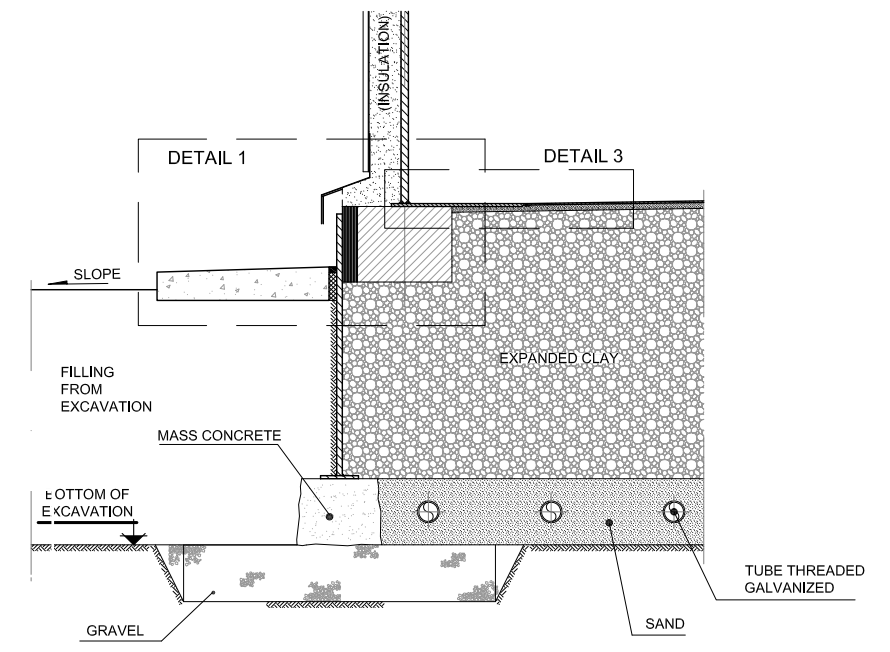
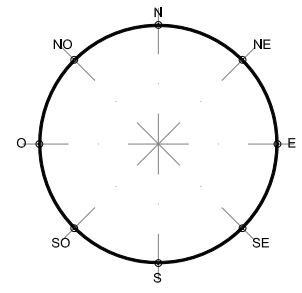
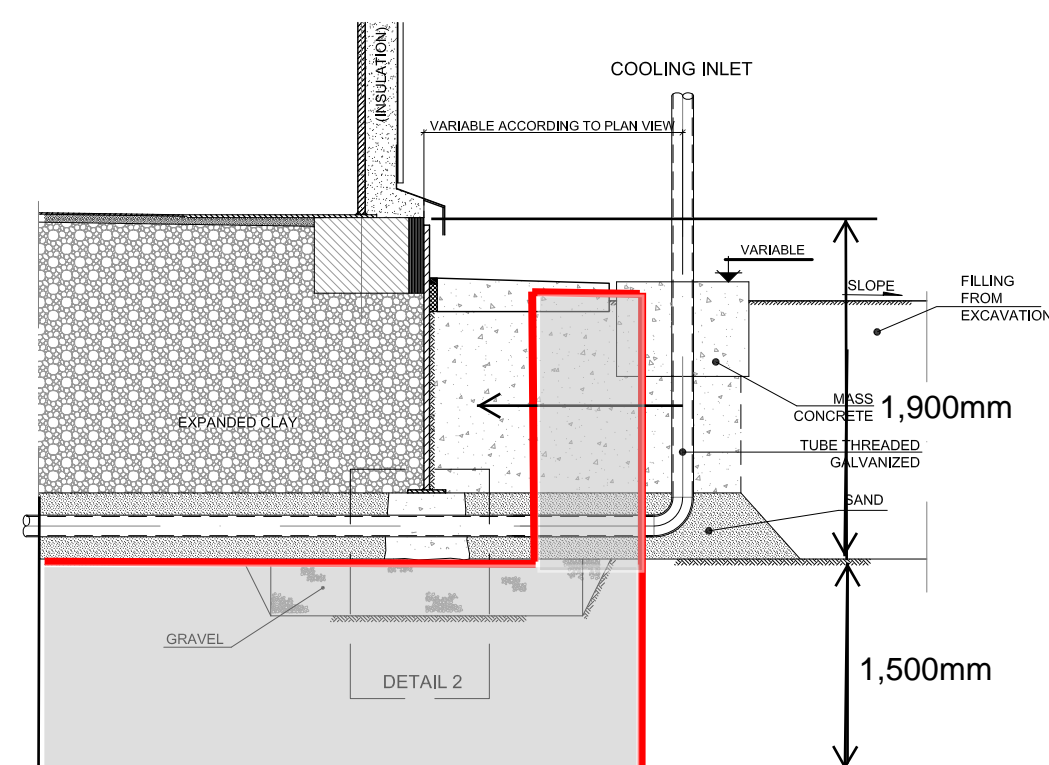
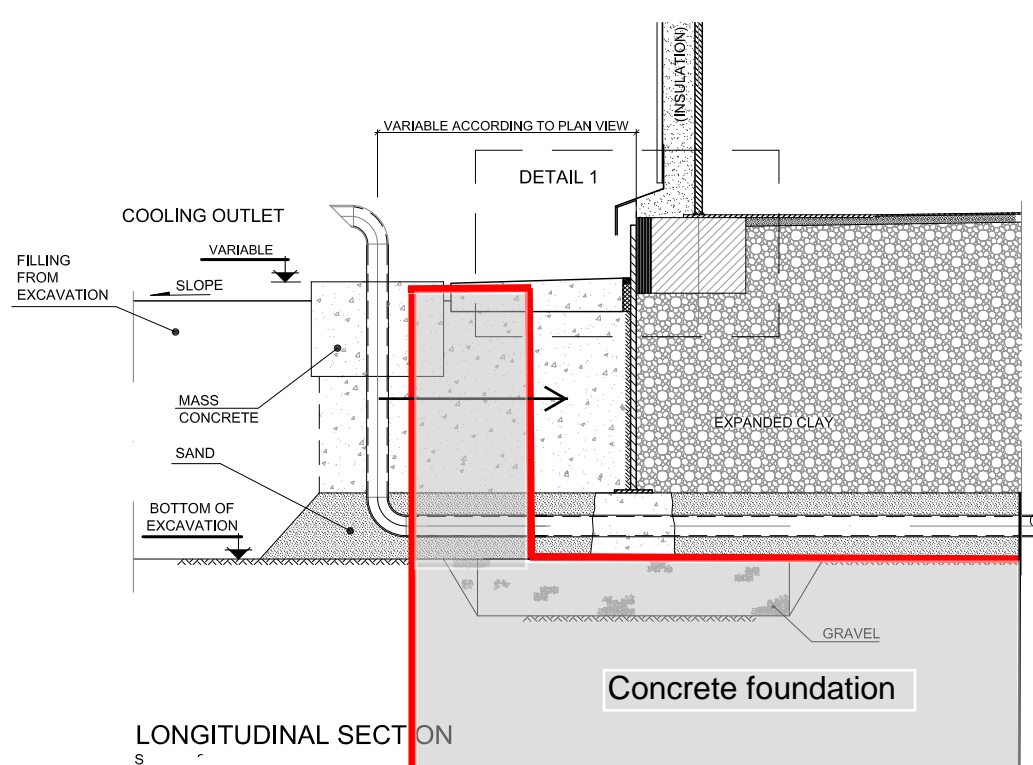
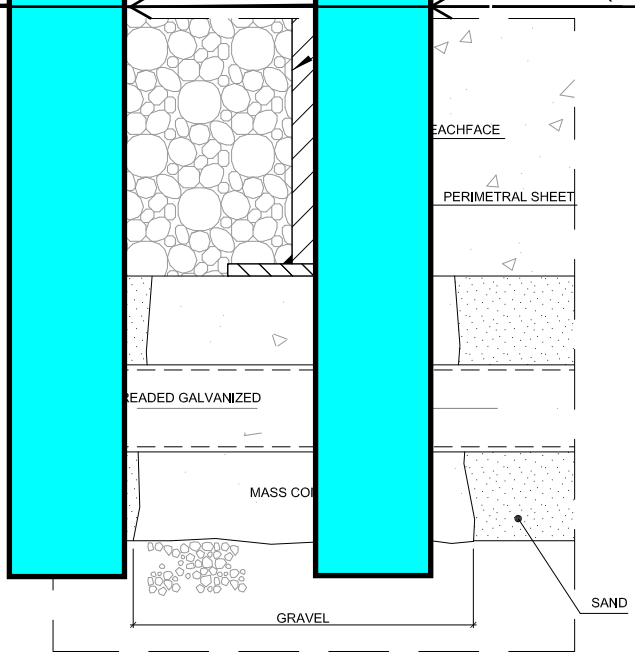
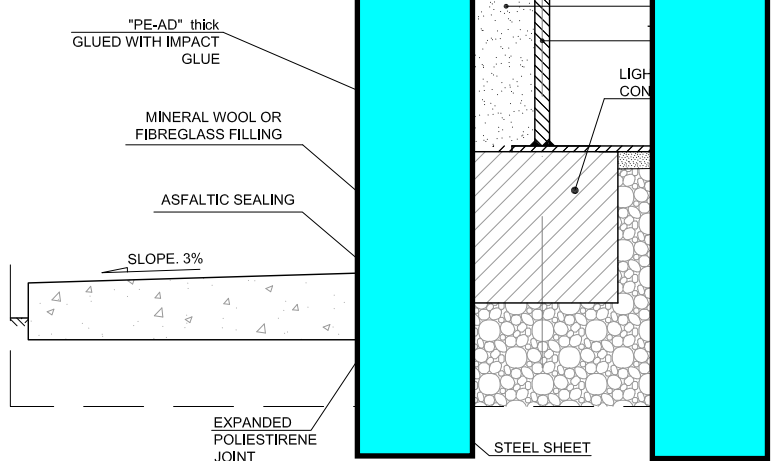


A  
B  
C  
D  
E  
F  
G  
H

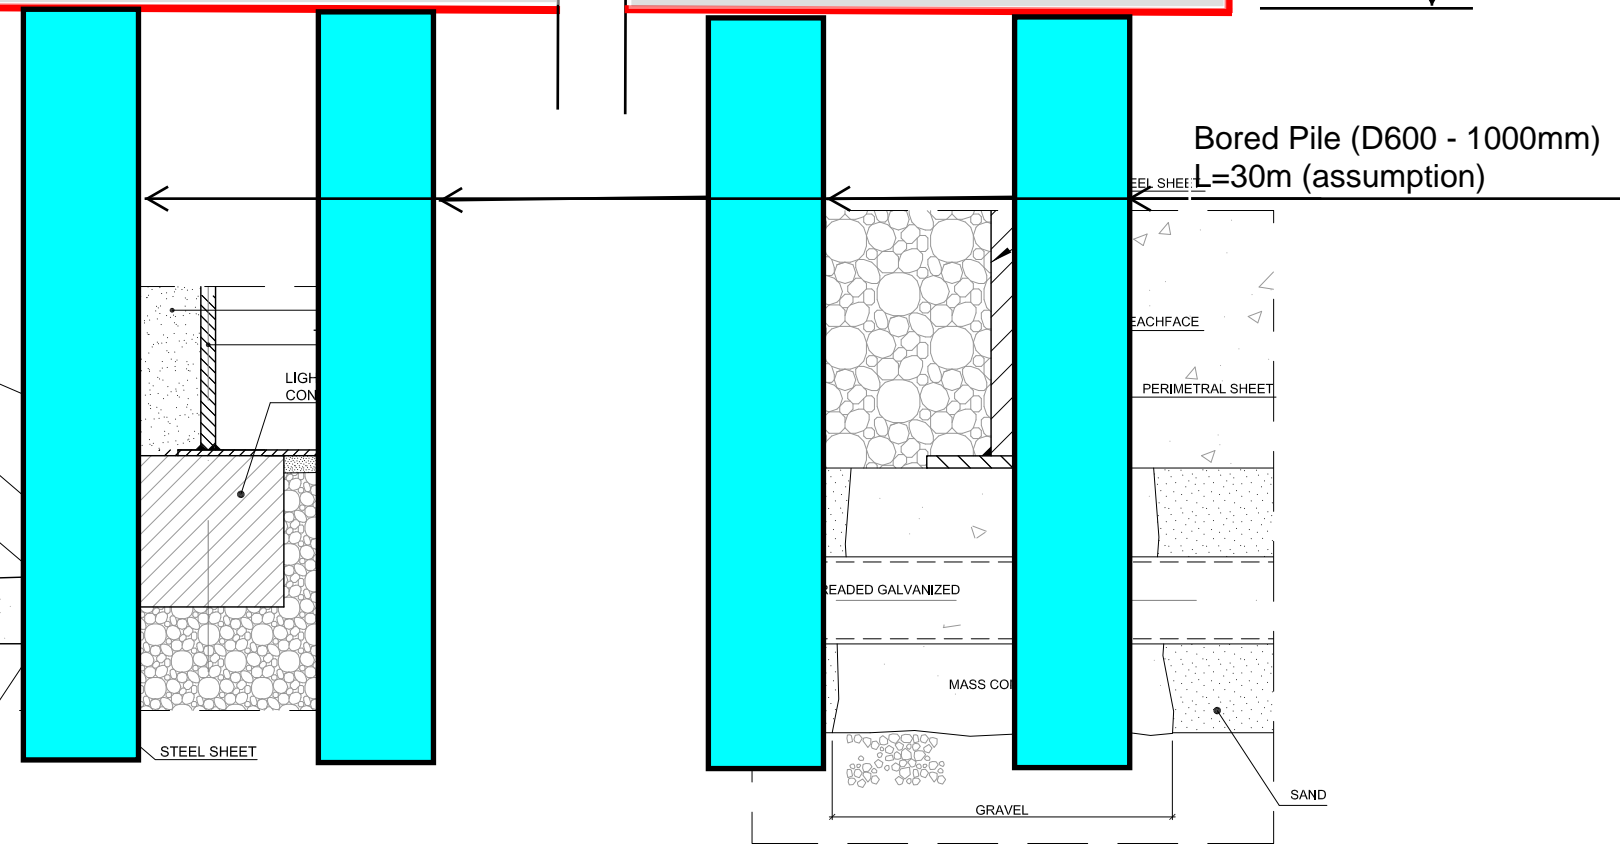

SCALE 1:20

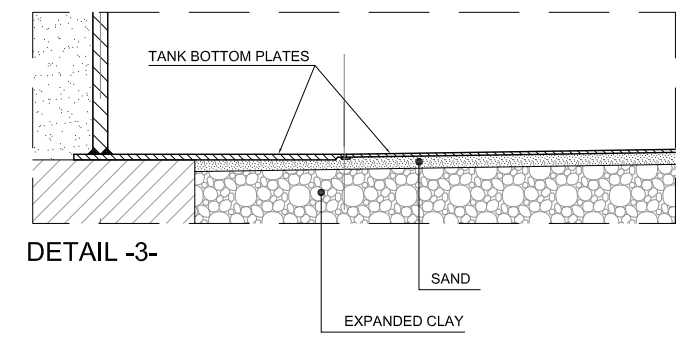

REV.	DESCRIPTION	DATE	DRAWN	CHECKED	APPROVED
A	FOR INFORMATION	12/09/13	D.M.	I.Z.	P.A.Z.

REVISIONS					
AUTHOR/OWNER:	ENGINEERING:	CONTRACTOR:	CUSTOMER:		
CAD FILE No:		PROJECT:			
CER-SRCA-PC-9002-02-Rev A		FLUMINNI MANU CSP PROJECT			
SCALE:		DRAWING TITLE:			
A/D		SALT TANK FOUNDATION DETAILS			
REFERENCE:		DRAWING No:			
C227A10		CER-SRCA-PC-9002			
ORIGINAL SIZE	CONFIGURATION ELEMENT	SHEET: 02			OF 02
A3	-				