

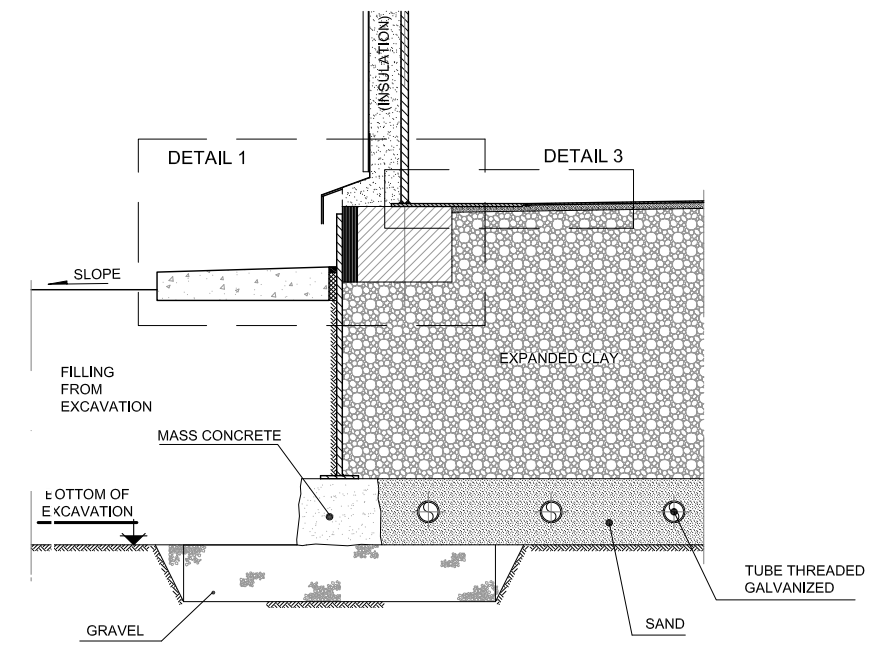
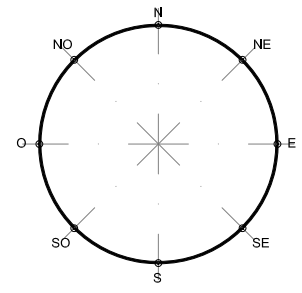
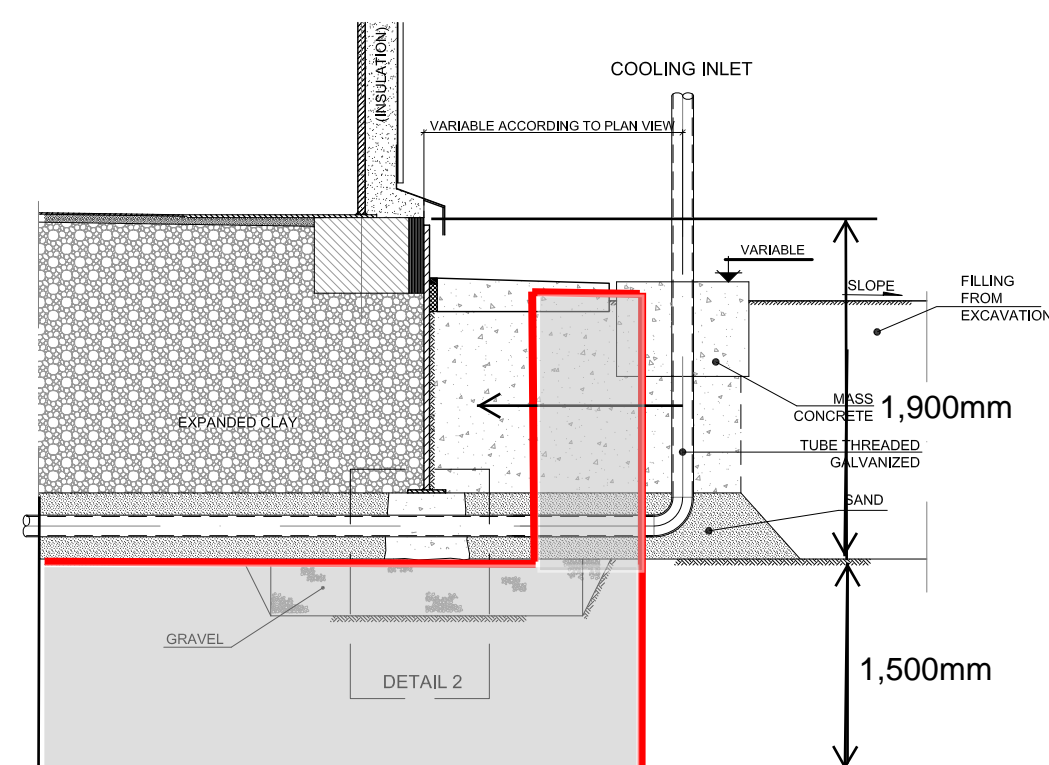




A
B
C
D
E
F
G
H

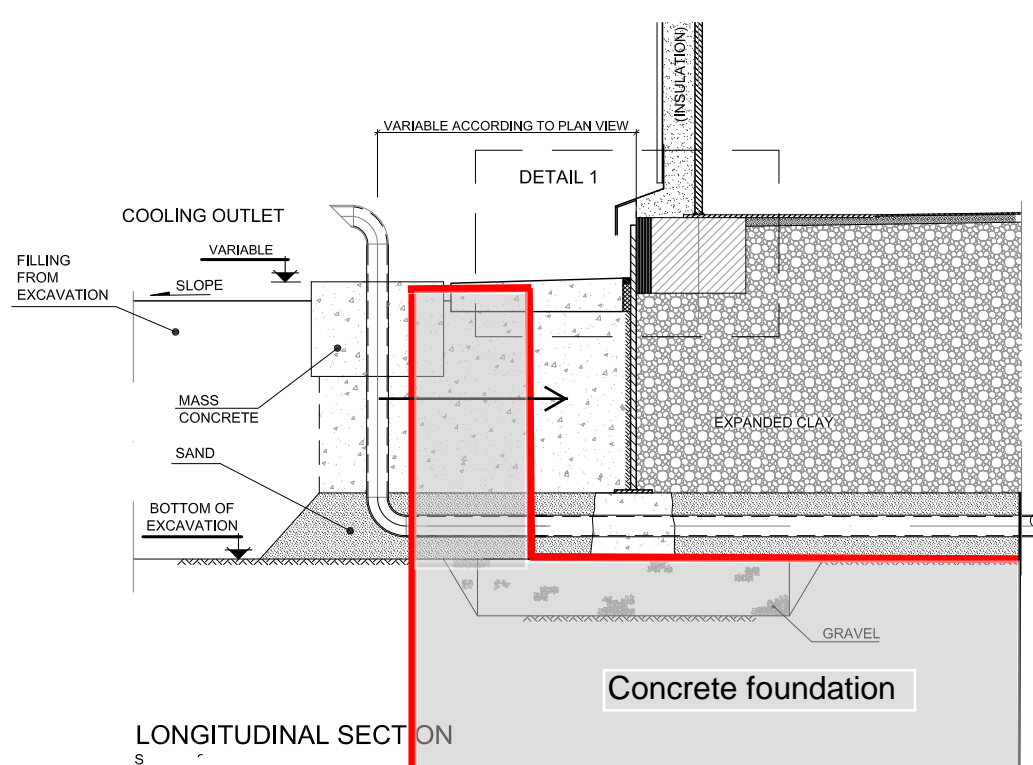

CROSS SECTION TO COOLING TUBES
SCALE 1:20

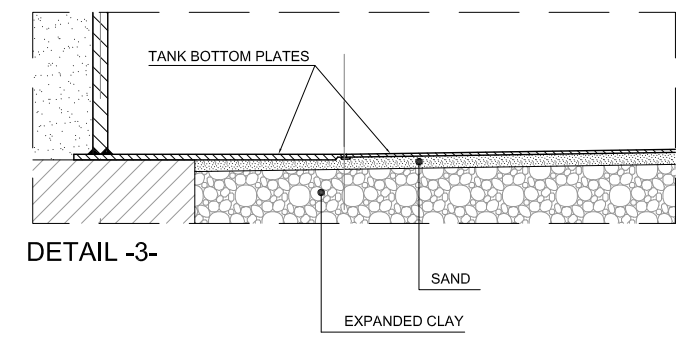

DETAIL -3-

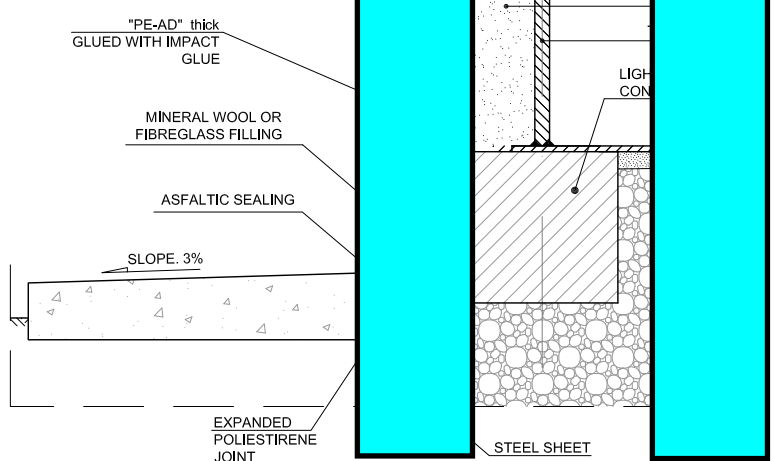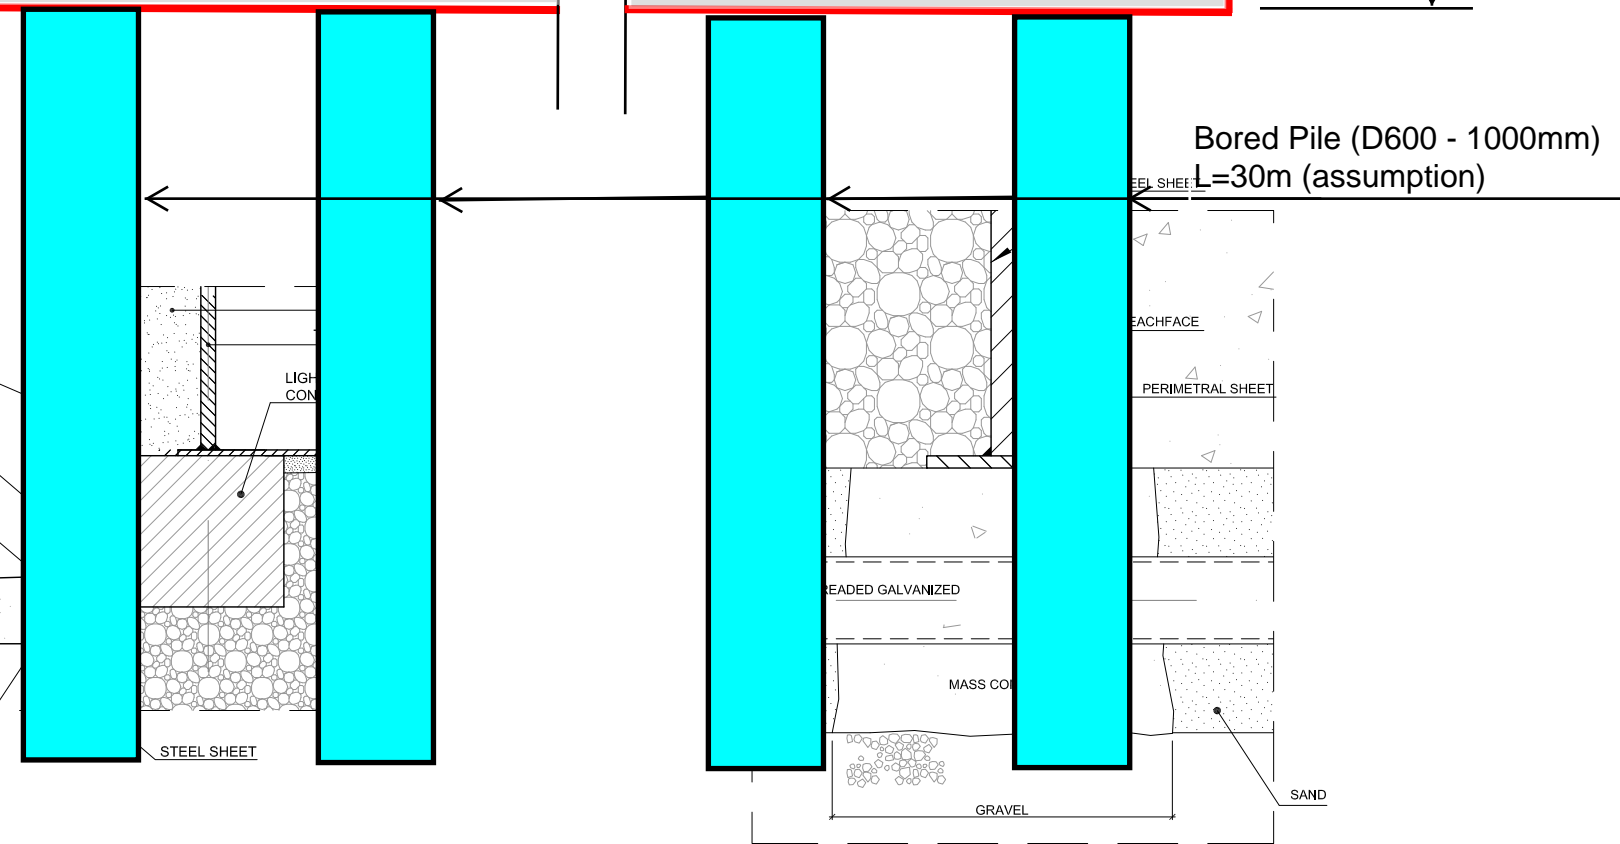

DETAIL 1

DETAIL 2

A	FOR INFORMATION	12/2014	D.M.	I.Z.	P.A.Z.
REV.	DESCRIPTION	DATE	DRAWN	CHECKED	APPROVED
REVISIONS					
AUTHOR/OWNER: 		ENGINEERING: 		CONTRACTOR: 	
<small>THE INFORMATION CONTAINED IN THIS DOCUMENT IS CONFIDENTIAL AND RESTRICTED AND IS TO BE USED ONLY FOR THE PURPOSES ESTABLISHED IN THE DOCUMENT. NO REPRODUCTION, COPIES, OR DISSEMINATION OF ANY KIND IS PERMITTED WITHOUT THE WRITTEN CONSENT OF SENER BUSINESS SYSTEMS S.A. SENER IS NOT RESPONSIBLE FOR ANY REPRODUCTION OR DISSEMINATION OF THIS DOCUMENT.</small>					
CAD FILE No: CER-SRCA-PC-9002-02-Rev A		PROJECT: GONNOSFANADIGA CSP PROJECT			
SCALE: A/D		DRAWING TITLE: SALT TANK FOUNDATION DETAILS			
REFERENCE: C227A10		DRAWING No: CER-SRCA-PC-9002		SHEET: 02 OF 02	
ORIGINAL SIZE A3	CONFIGURATION ELEMENT -				