
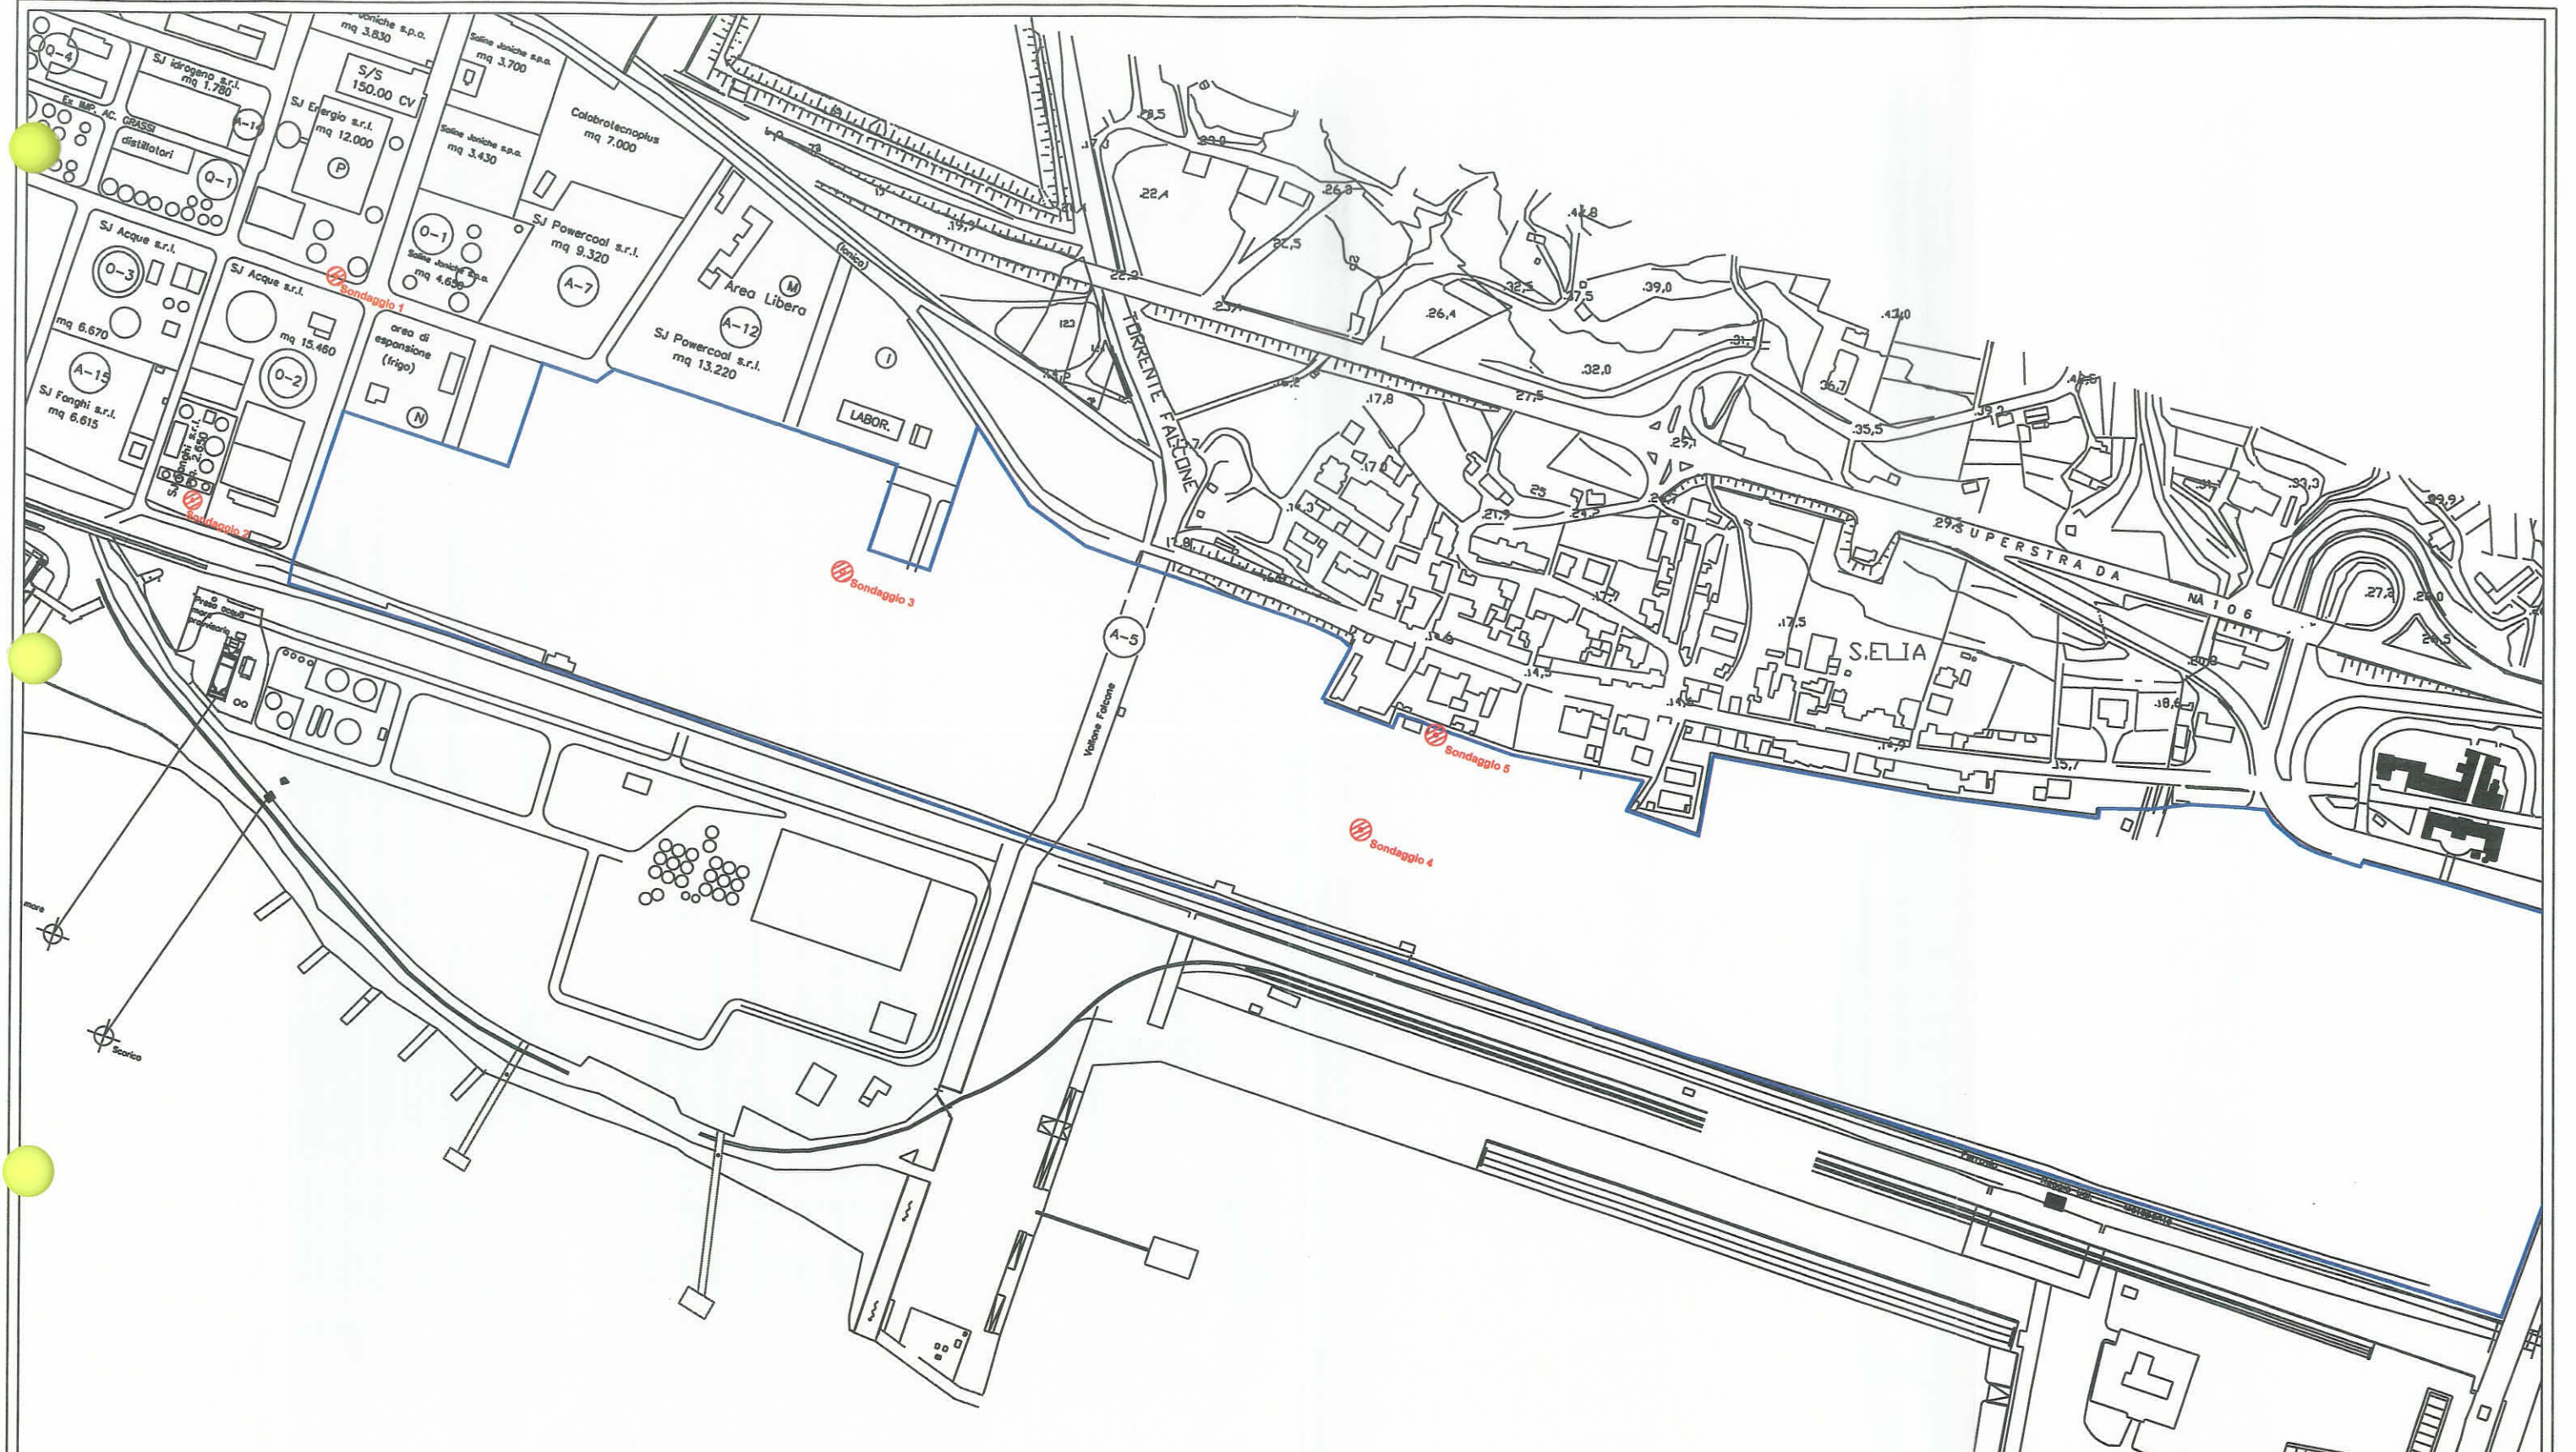



ALLEGATO 1 – Figure


BD0662A-0-01-001	Planimetria generale dell'area
BH0344-01-01	Planimetria rappresentante la situazione attuale
BH0344-01-02	Planimetria con ubicazione delle indagini eseguite nel 1999
BH0344-01-03	Planimetria con ubicazione dei sondaggi e dei piezometri realizzati
BH0344-01-04	Rilievo topografico
BH0344-01-05	Schema stratigrafico
BH0344-01-06	Planimetria con ubicazione dei saggi superficiali eseguiti
BH0344-01-07	Mappatura della potenziale contaminazione suoli-acque sotterranee



REV.	DATE	DESCRIPTION	M.C.	M.I.	D.A.
0	nov 07	PRIMA EMISSIONE			
REVISIONS			BY	CHD	APP.
SEI S.p.A. Montebello Jonico (RC), Loc. Saline					
Planimetria rappresentante la situazione attuale			ORDER N°		
			SUPPLIER		
			CONTRACT N°1-BH-0344A		
			FRAME N°		
FOSTER WHEELER ITALIANA SpA ENVIRONMENTAL DIVISION			THIS DWG.SUPERSEDED BY	SCALE	
THIS DRAWING IS THE PROPERTY OF FOSTER WHEELER ITALIANA AND IS LOANED WITHOUT CONSIDERATION OTHER THAN THE BORROWER'S AGREEMENT THAT IT SHALL NOT BE REPRODUCED COPIED LOANED OR DISPOSED OF DIRECTLY OR INDIRECTLY AND USED FOR ANY PURPOSE OTHER THAN THAT FOR WHICH IT IS SPECIFICALLY FURNISHED. THE APPLICABLE SHOW IN THE DRAWING IS COVERED BY PATENTS.			THIS DWG.SUPERSEDES	1:4000	
			DWG N°	REV.	
			BH0344-01-01	0	



0	REV. BY	PRIMA EMISSIONE	M.C.	M.I.	D.A.
REV.	DATE	DESCRIPTION	BY	CHKD	APP.
REVISIONS					
SEI S.p.A. Montebello Jonico (RC), Loc. Saline			ORDER N° SUPPLIER CONTRACT N°1-BH-0344A		
Planimetria del sito con ubicazione delle indagini realizzate nel 1999			FRAME N° THIS DWG.SUPERSEDED BY SCALE THIS DWG.SUPERSEDES 1:4000 DWG N° REV. BH0344-01-02		
 FOSTER WHEELER ITALIANA S.p.A. ENVIRONMENTAL DIVISION THIS DRAWING IS THE PROPERTY OF FOSTER WHEELER ITALIANA AND IS LOANED WITHOUT COMPENSATION UNDER THE CONDITION THAT IT SHALL NOT BE REPRODUCED, COPIED, LOANED OR RESPONDED BY DIRECTLY OR INDIRECTLY FOR ANY PURPOSE OTHER THAN THAT FOR WHICH IT IS SPECIFICALLY FURNISHED. THE APPROPRIATE SIGNATURE IS COVERED BY PATENTS.					


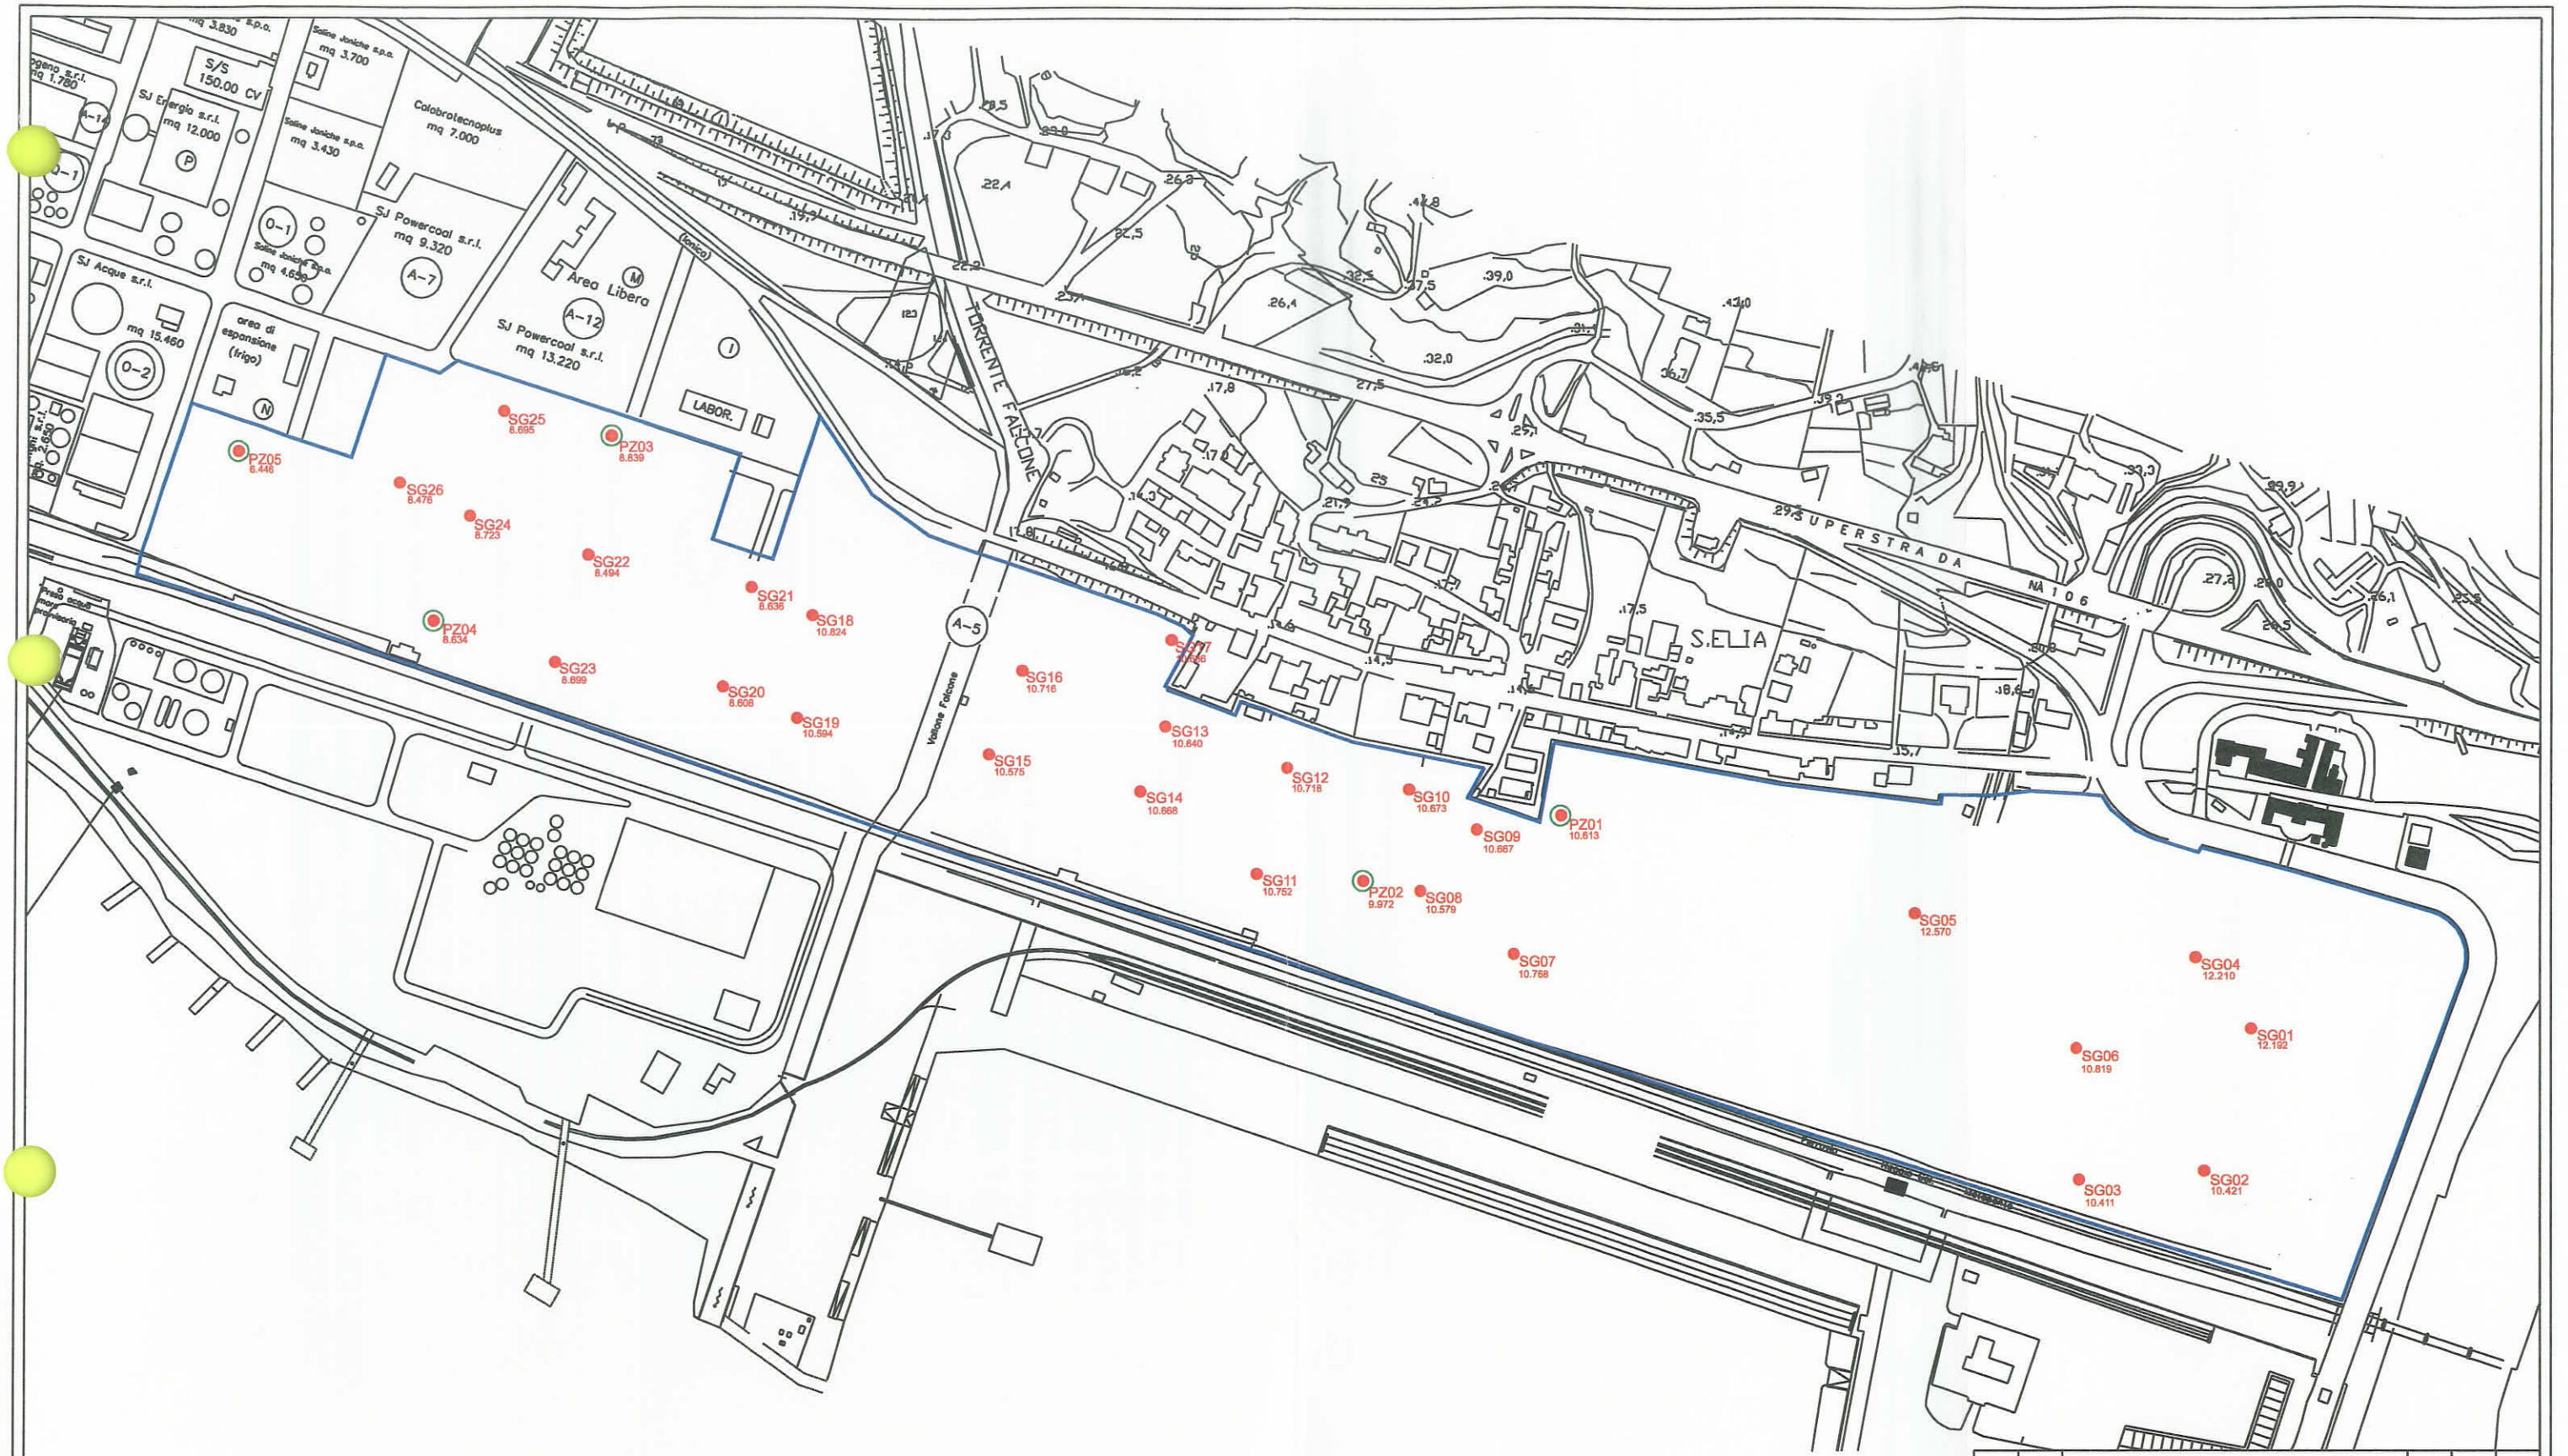


LEGENDA

- Sondaggi a carotaggio continuo
- Sondaggi attrezzati a piezometro da 4"
- 10.668 Quota sondaggio/piezometro (m s.l.m.)



0	nov 07	PRIMA EMISSIONE	M.C.	M.I.	D.A.
REV.	DATE	DESCRIPTION	BY	CHK	APP.
REVISIONS					
SEI S.p.A. Montebello Jonico (RC), Loc. Saline			ORDER N°		
Planimetria del sito con ubicazione dei sondaggi e piezometri realizzati			SUPPLIER		
			CONTRACT N°1-BH-0344A		
			FRAME N°		
FOSTER WHEELER ITALIANA S.p.A. ENVIRONMENTAL DIVISION			THIS DWG. SUPERSEDED BY		
THIS DRAWING IS THE PROPERTY OF FOSTER WHEELER ITALIANA AND IS LOANED WITHOUT COMMITMENT OTHER THAN THE BONDOWNER'S AGREEMENT THAT IT SHALL NOT BE REPRODUCED, COPIED, LOANED OR OTHERWISE USED DIRECTLY OR INDIRECTLY, AND USED FOR ANY PURPOSE OTHER THAN THAT FOR WHICH IT IS SPECIFICALLY FURNISHED. THE APPLICABLE DRAWING IN THE DRAWING IS COVERED BY PATENTS.			SCALE		
THIS DWG. SUPERSEDES			1:4000		
DWG N°			REV.		
BH0344-01-03			0		

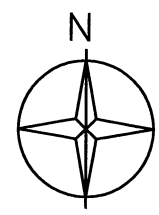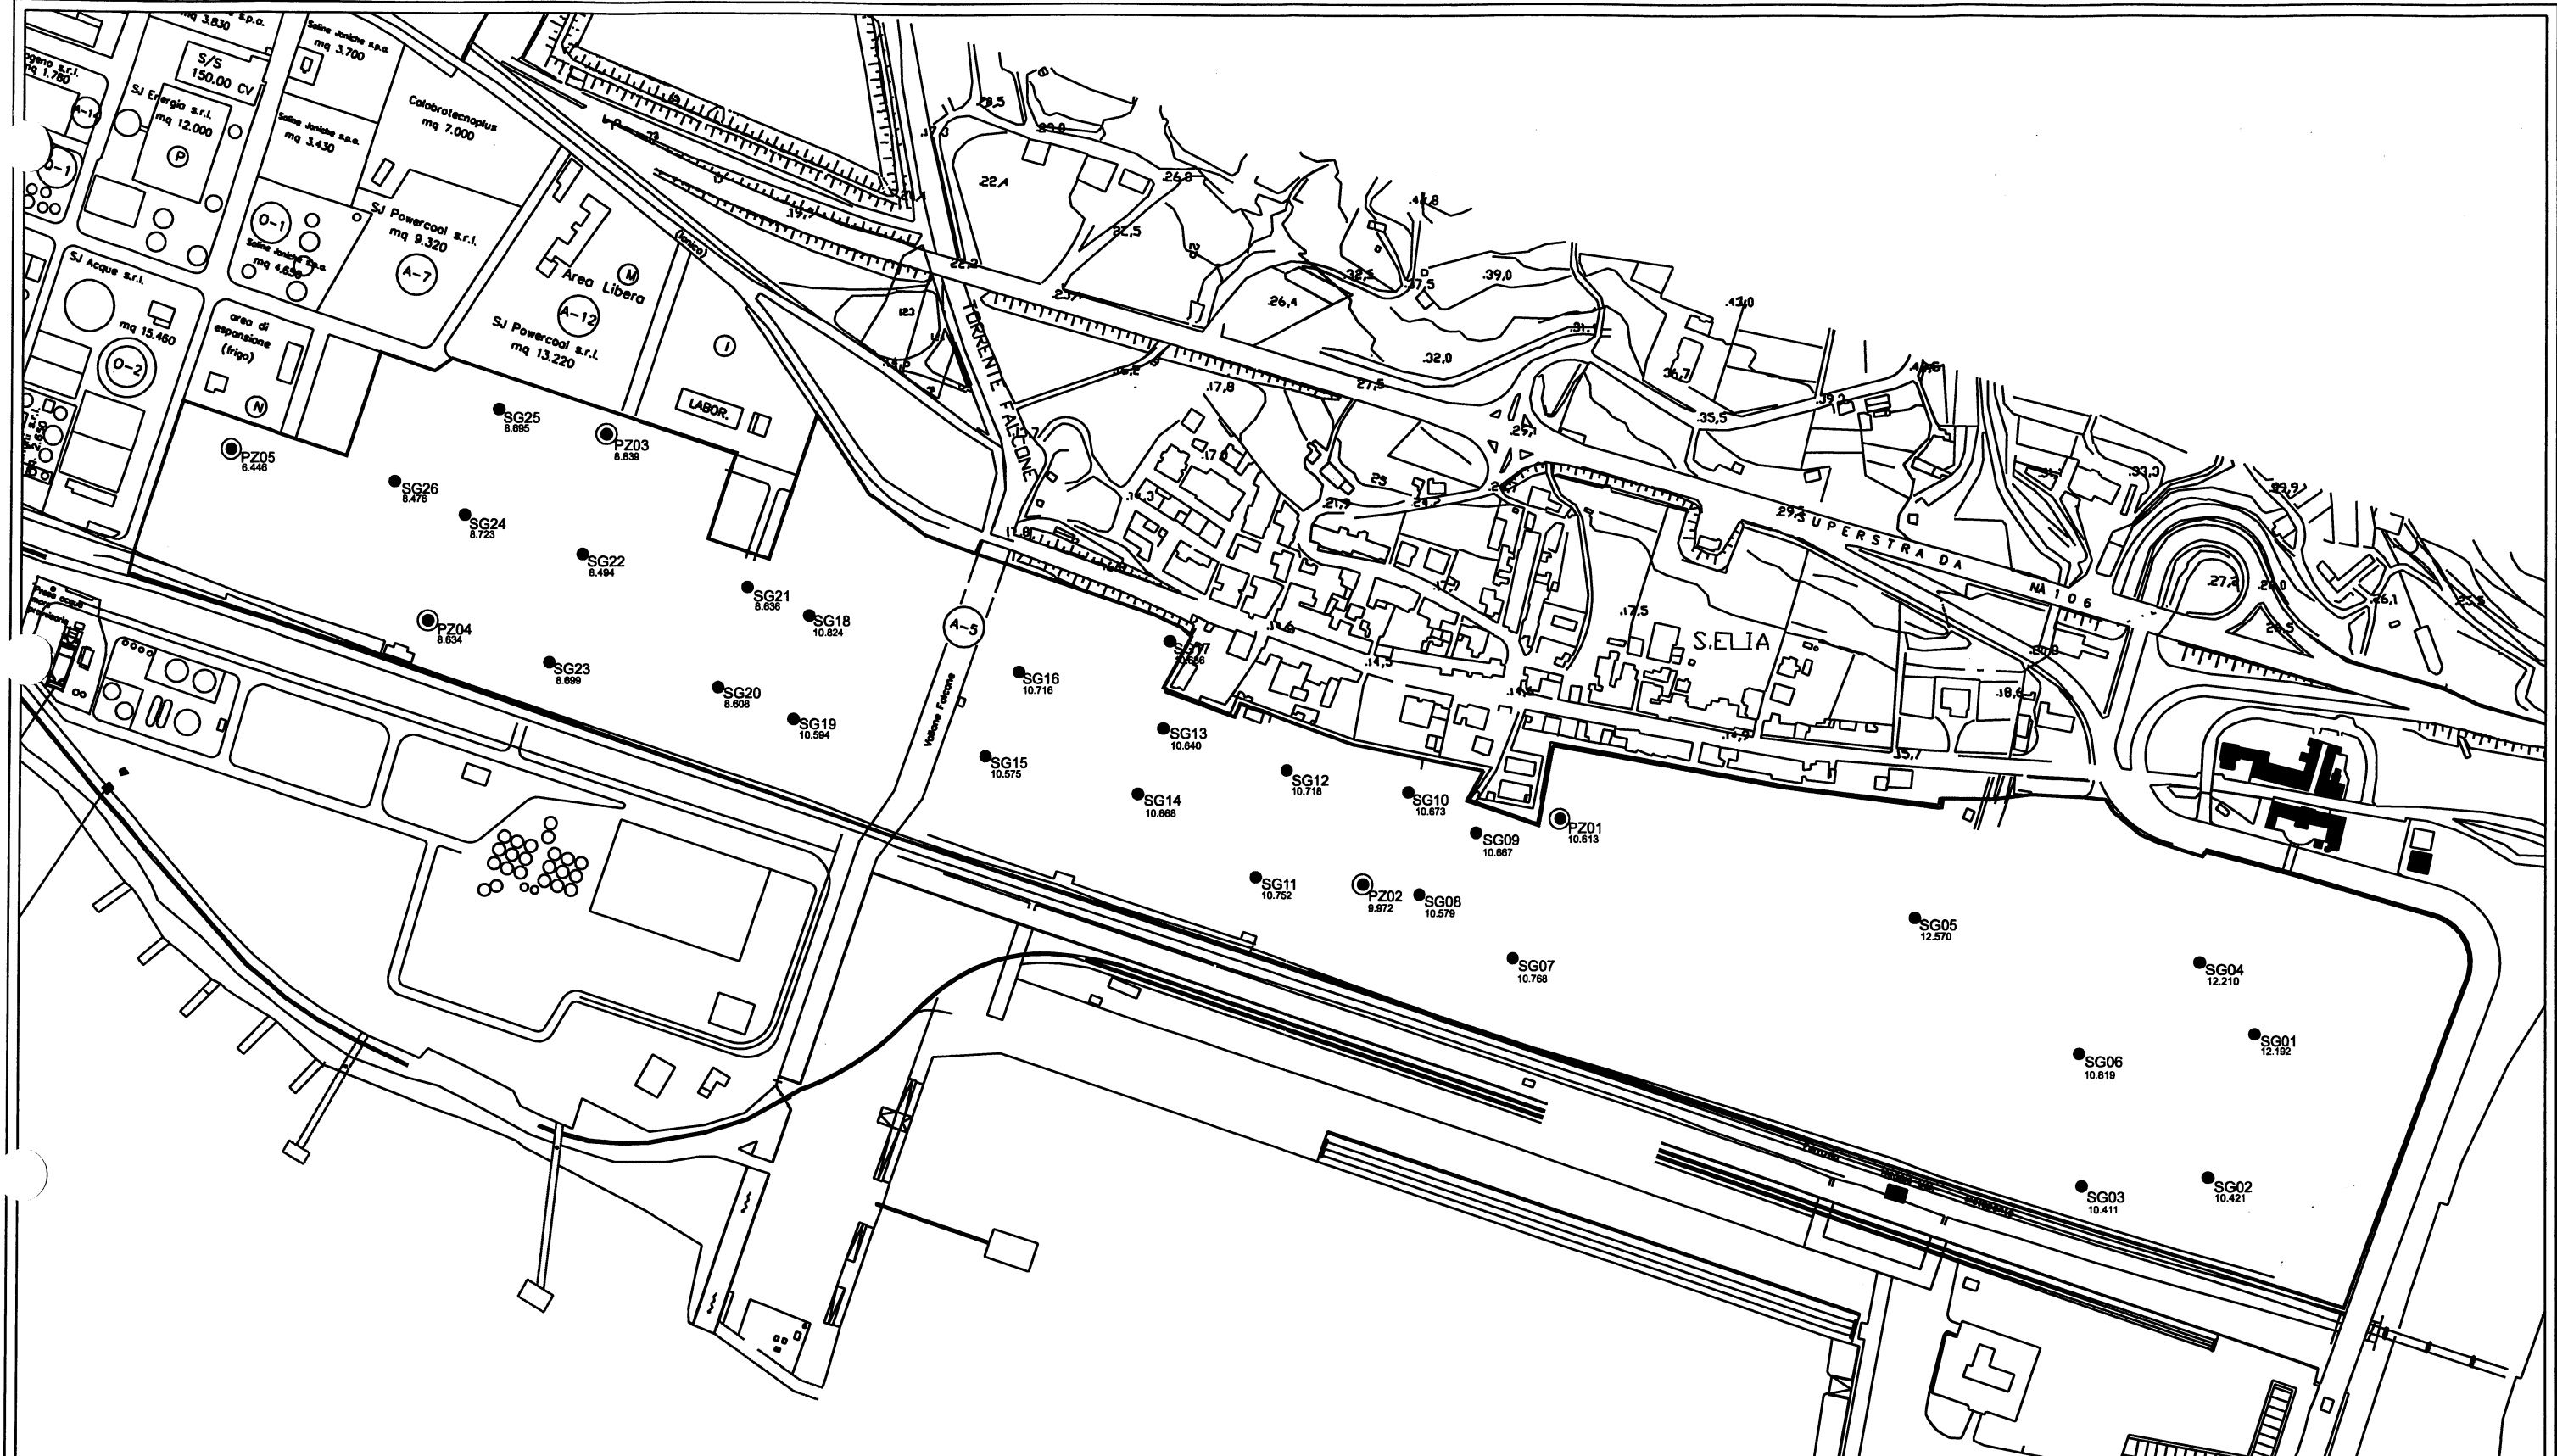


LEGENDA

- Sondaggi a carotaggio continuo
- ⊙ Sondaggi attrezzati a piezometro da 4"
- 10.668 Quota sondaggio/piezometro (m s.l.m.)

REV.	NOV. DATE	PRIMA EMISSIONE DESCRIPTION	M.C. BY	M.I. CHD	D.A. APP.
SEI S.p.A. Montebello Jonico (RC), Loc. Saline					
Planimetria del sito con ubicazione dei sondaggi e piezometri realizzati			ORDER N°	SUPPLIER	
			CONTRACT N°1-BH-0344A		
			FRAME N°	THIS DWG.SUPERSEDED BY	
			THIS DWG.SUPERSEDES		SCALE
			DWG N°		REV.
			BH0344-01-03		0




FOSTER WHEELER ITALIANA S.p.A.
ENVIRONMENTAL DIVISION
THIS DRAWING IS THE PROPERTY OF FOSTER WHEELER ITALIANA AND IS LOANED TO YOU WITHOUT CONSIDERATION SINCE FROM THE SIGNATURE AGREEMENT THAT IT SHALL NOT BE REPRODUCED COPIED LOANED OR DISPOSED OF DIRECTLY OR INDIRECTLY FOR ANY PURPOSE OTHER THAN THAT FOR WHICH IT IS SPECIFICALLY FURNISHED. THE APPLICABLE DESIGN BY THE DRAWING IS CONTROLLED BY FOSTER WHEELER.

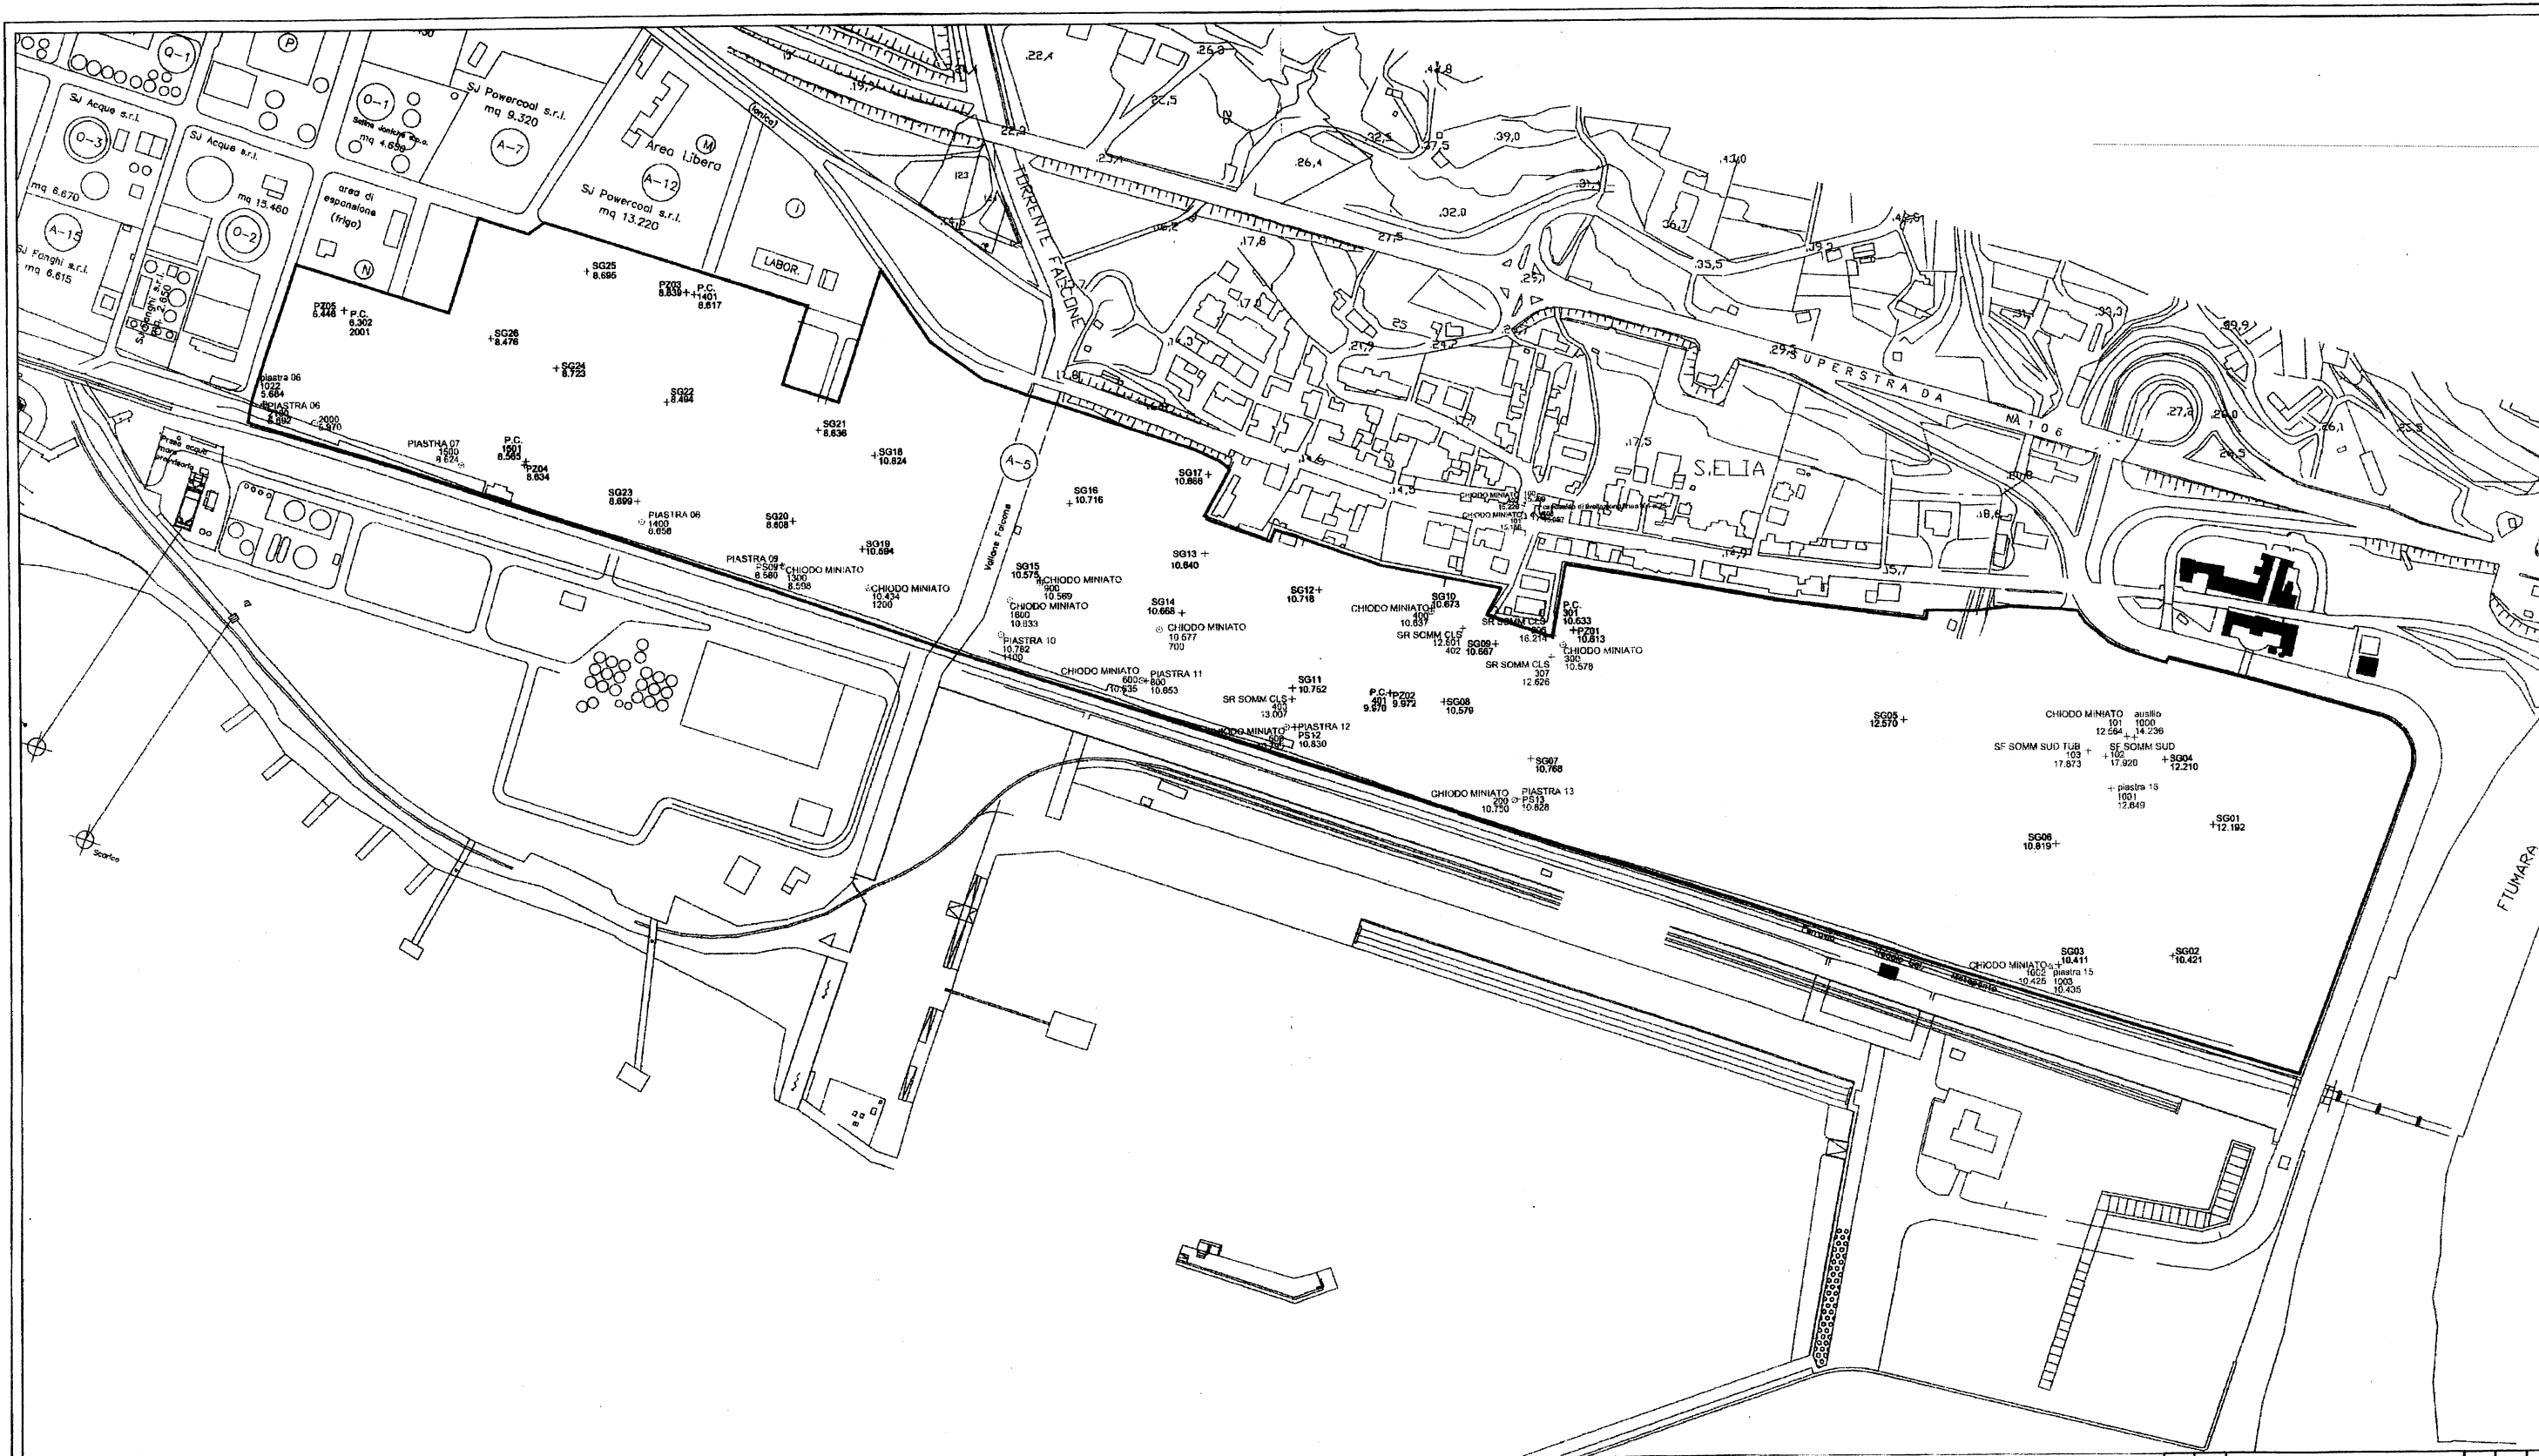

LEGENDA

- + Sondaggi/Piezometri
- ⊕ Punti di stazioneamento
- SG23 Sigla punto
- 8.699 Quota (m s.l.m.)

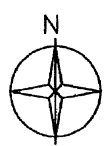

I.E. 8/ PRIMA EMISSIONE REV. DATA DESCRIZIONE REVISIONI	MC ML BA DT CH I APP.
SEI Sp.A. Montebello Janico (RC), Loc. Salne	
Rilievo Topografico	
	810344-01-04

13 m
12 m
11 m
10 m
9 m
8 m
7 m
6 m
5 m
4 m
3 m
2 m
1 m
0 m
-1 m
-2 m
-3 m
-4 m
-5 m
-6 m

1

PZ05

6.302

2


PZ04

8.565

3

PZ02

9.970

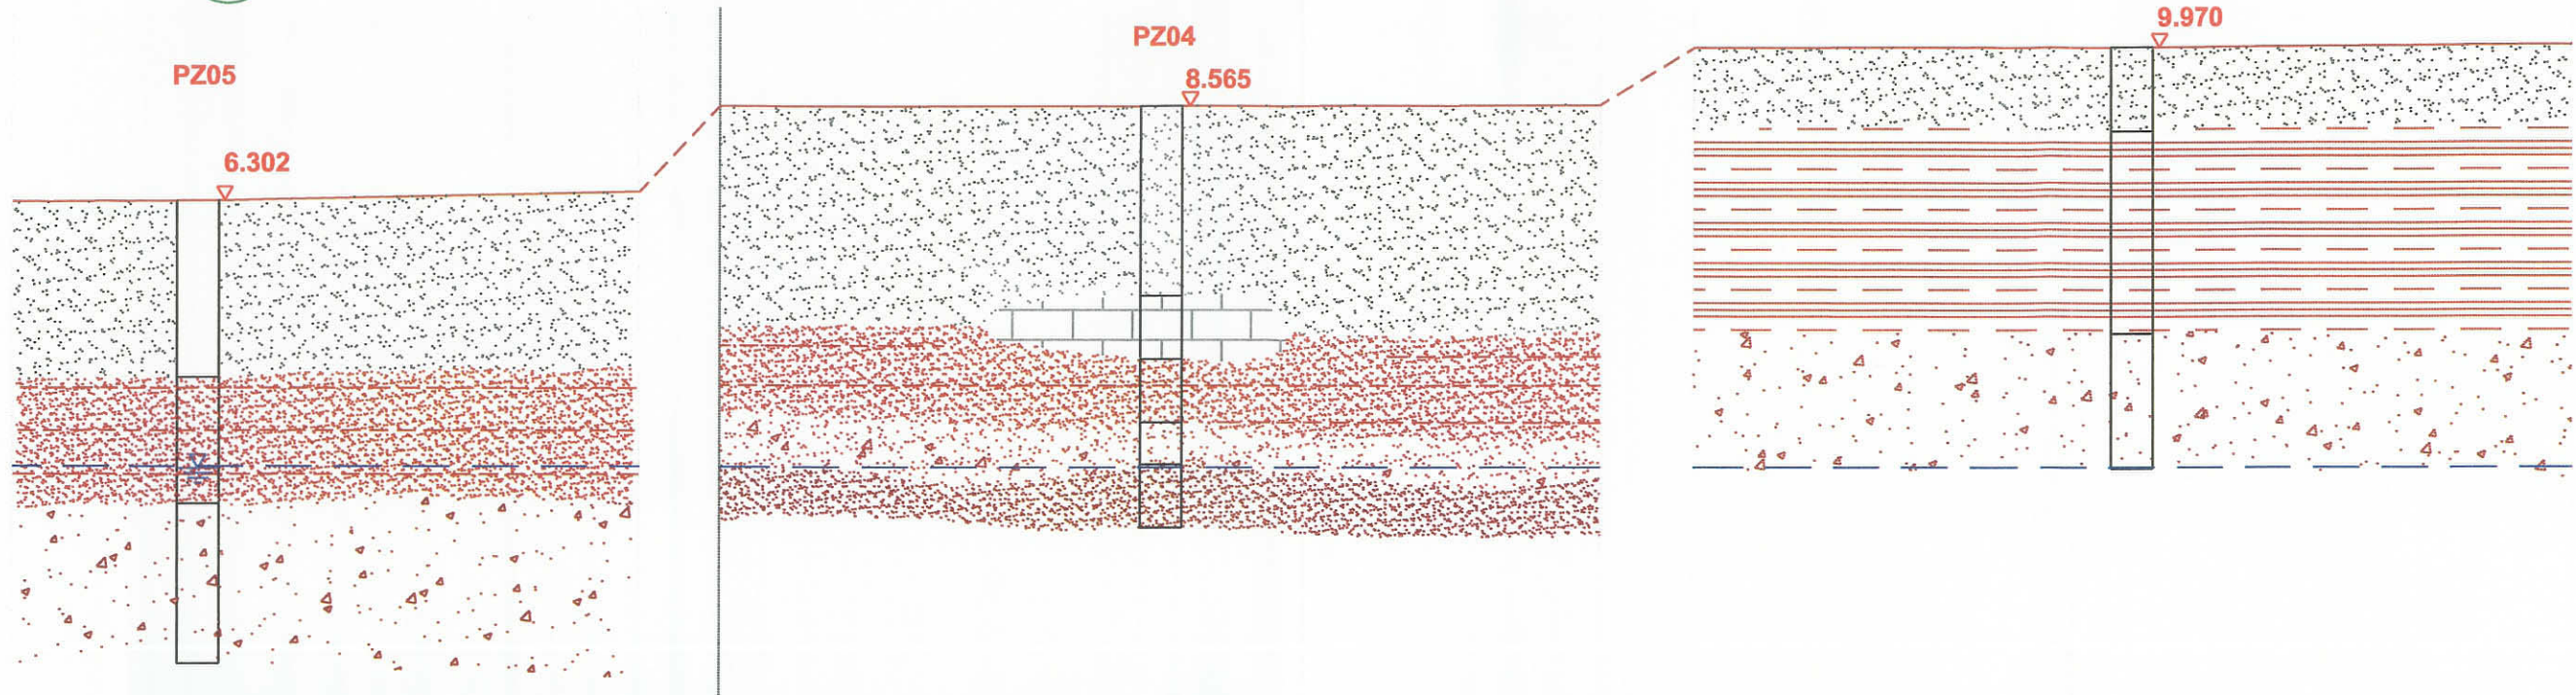

LEGENDA


- Terreno superficiale costituito da sabbie con ciottoli e breccie
- Megabreccie frammiste in matrice sabbosa
- Sabbie limose
- Argilla con limo sabbiosa
- Sabbia frammista a breccie e ciottoli
- Sabbia grossolana sciolta omogenea
- Livello di falda
- 0,0 m s.l.m.



0	nov 07	PRIMA EMISSIONE	M.C.	M.I.	D.A.
REV.	DATE	DESCRIPTION	BY	CHK	APP.
REVISIONS					
SEI Sp.A. Montebello Jonico (RC), Loc. Saline					
Schema stratigrafico			ORDER N°		
			SUPPLIER		
			CONTRACT N°1-BH-0344A		
			FRAME N°		
			THIS DWG.SUPERSEDES BY SCALE		
			THIS DWG.SUPERSEDES		
			DWG N°		
			REV.		
			BH0344-01-05		
			0		



FOSTER WHEELER ITALIANA S.p.A.
ENVIRONMENTAL DIVISION
THIS DRAWING IS THE PROPERTY OF FOSTER WHEELER ITALIANA AND IS LOANED WITHOUT GUARANTEE TO THE BORROWER'S AGENCY. IT SHALL NOT BE REPRODUCED, COPIED, LOANED OR OTHERWISE USED IN ANY MANNER FOR ANY PURPOSE, OTHER THAN THAT FOR WHICH IT IS SPECIFICALLY FORWARDED. THE APPLICABLE SIGNS IN THE DRAWING IS COVERED BY PATENTS.

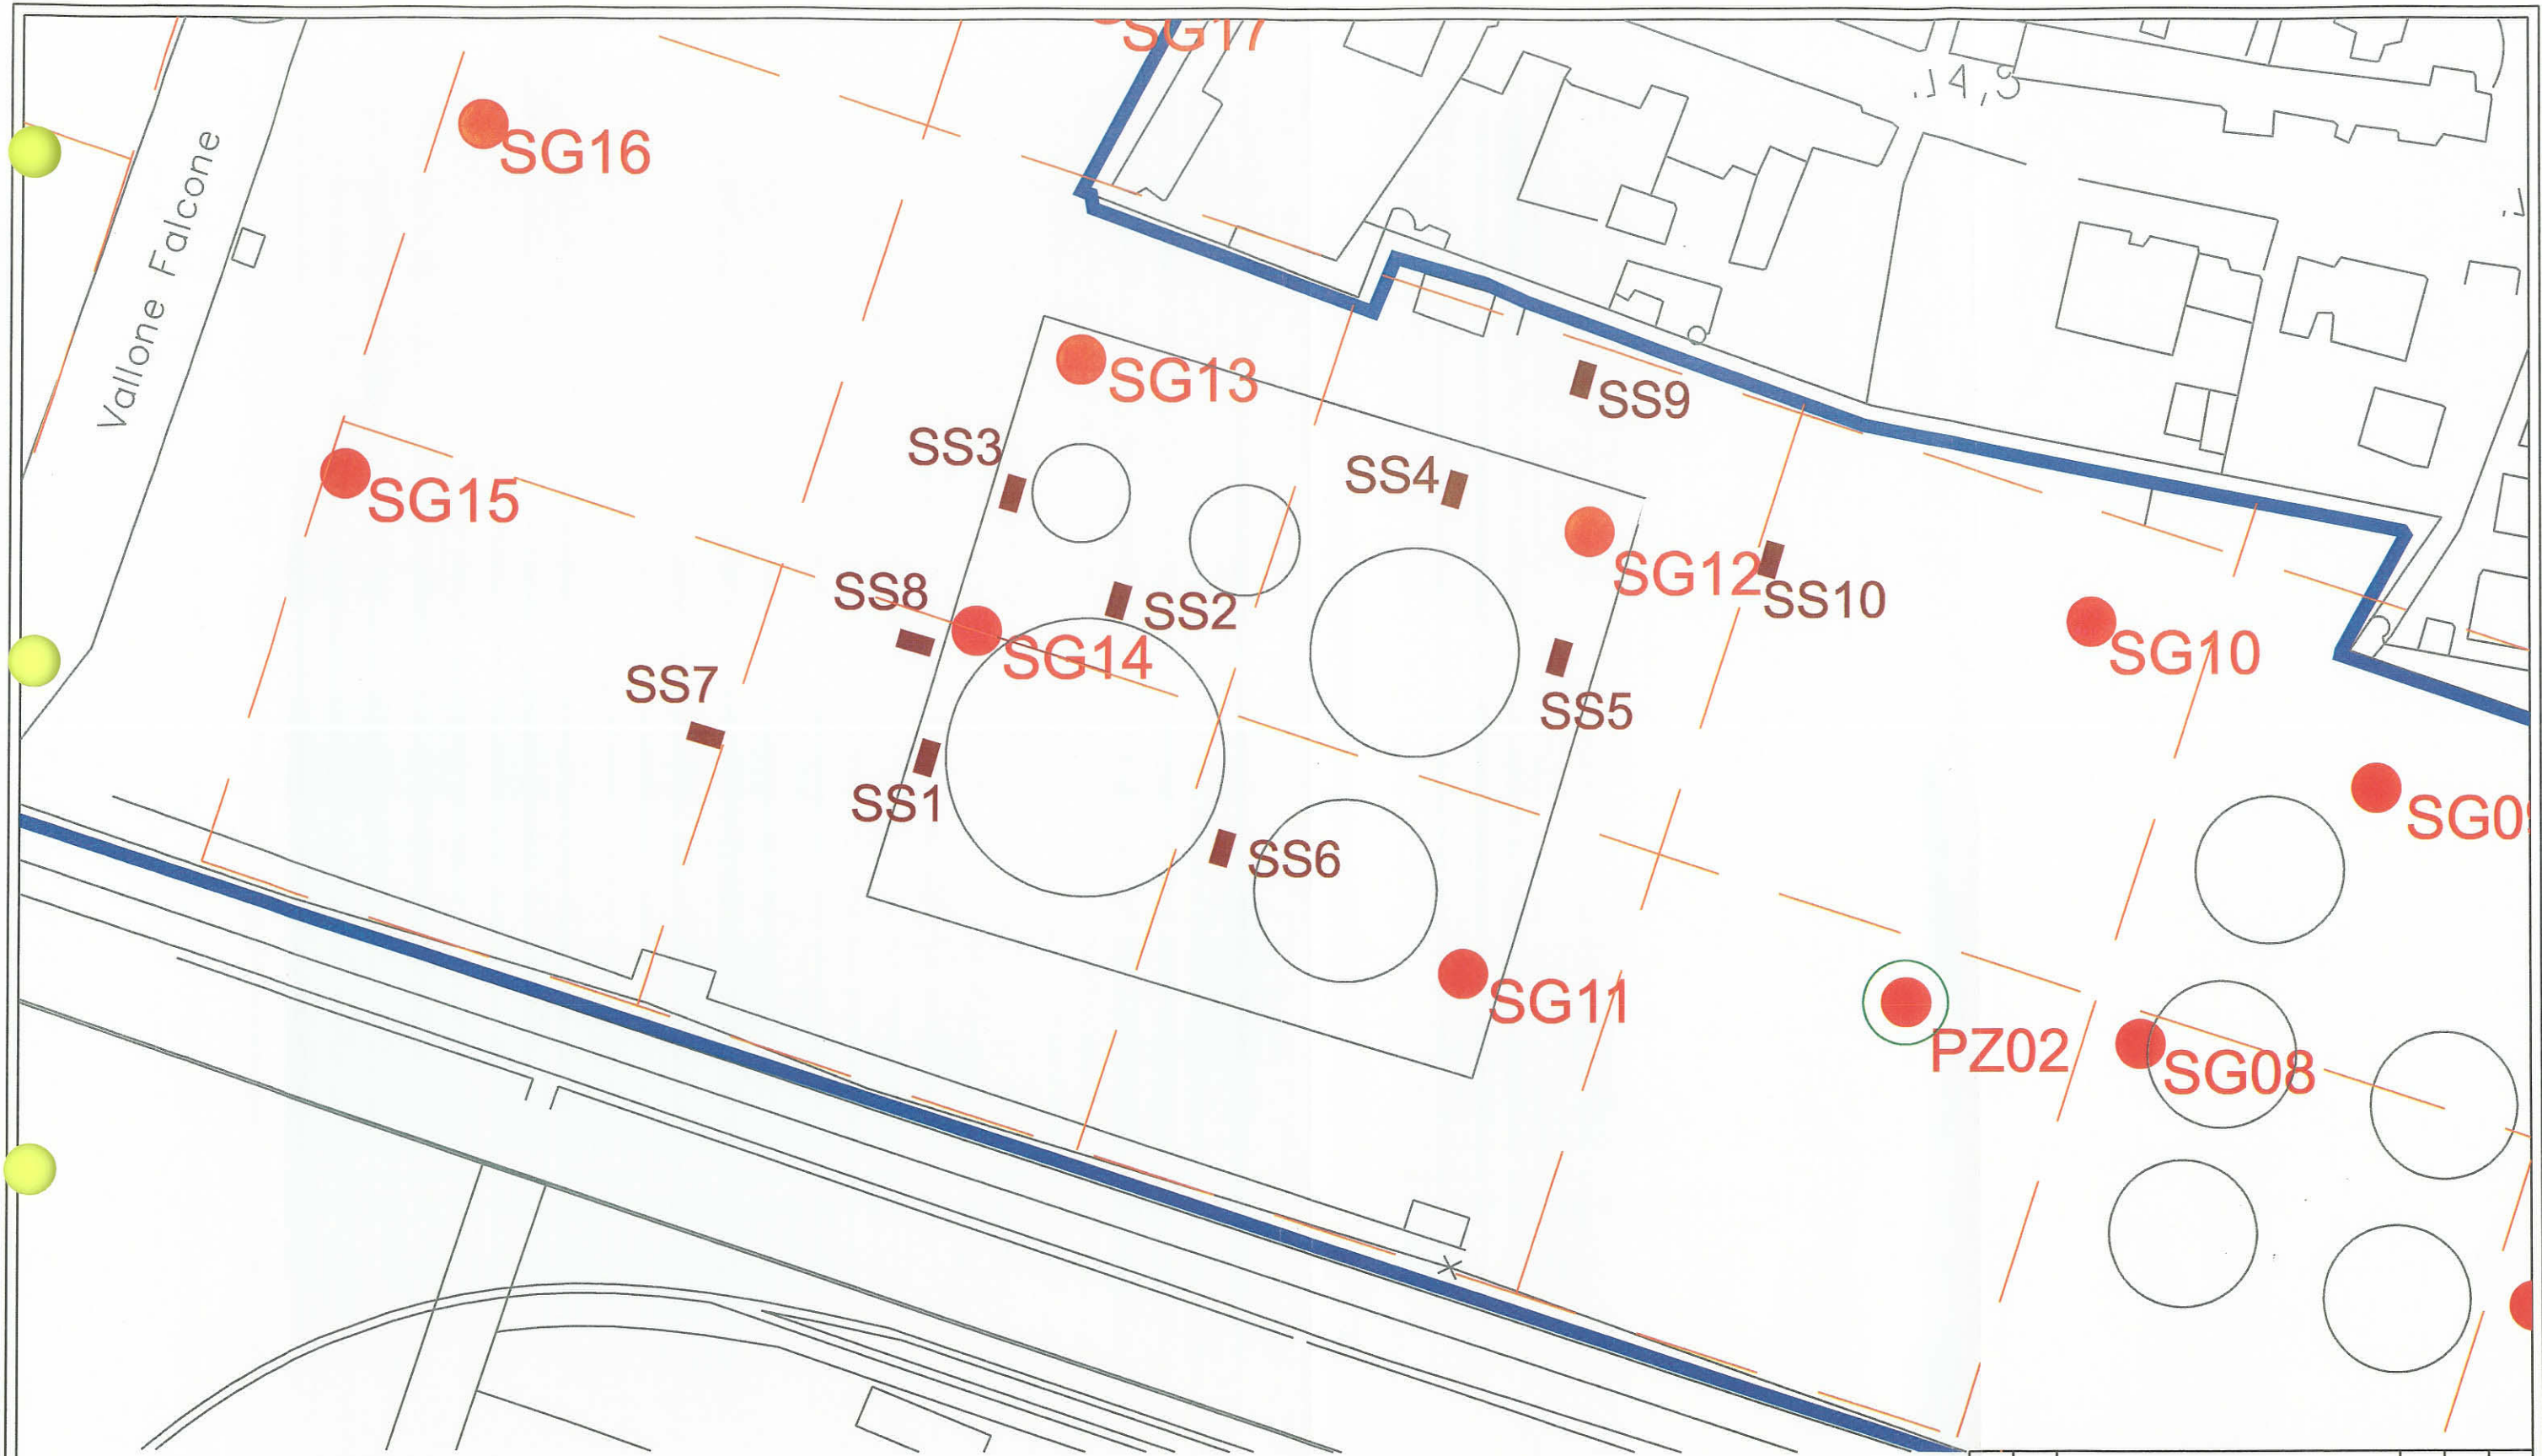


LEGENDA

- Sondaggi/Piezometri realizzati
- Saggi superficiali realizzati




REV.	DATE	DESCRIPTION	M.C.	M.I.	D.A.
0	07	PRIMA EMISSIONE			
REVISIONS					
SEI S.p.A. Montebello Jonico (RC), Loc. Saline			ORDER N°		
Ubicazione saggi superficiali realizzati all'interno del bacino serbatoi Oli combustibili			SUPPLIER		
			CONTRACT N°1-BH-0344A		
			FRAME N°		
FOSTER WHEELER ITALIANA S.p.A. ENVIRONMENTAL DIVISION			THIS DWG. SUPERSEDES BY SCALE		
<small>THIS DRAWING IS THE PROPERTY OF FOSTER WHEELER ITALIANA AND IS LOANED WITHOUT COMPENSATION OTHER THAN THE DRAWING'S AGREEMENT THAT IT SHALL NOT BE REPRODUCED, COPIED, LOANED OR DISPOSED OF DIRECTLY OR INDIRECTLY, NOR USED FOR ANY PURPOSE OTHER THAN THAT FOR WHICH IT IS SPECIFICALLY FURNISHED. THE APPLICABLE DESIGN IN THE DRAWING IS COVERED BY PATENTS.</small>			THIS DWG. SUPERSEDES		
			DWG N°		
			REV. 0		
			BH-0344A-01-06		

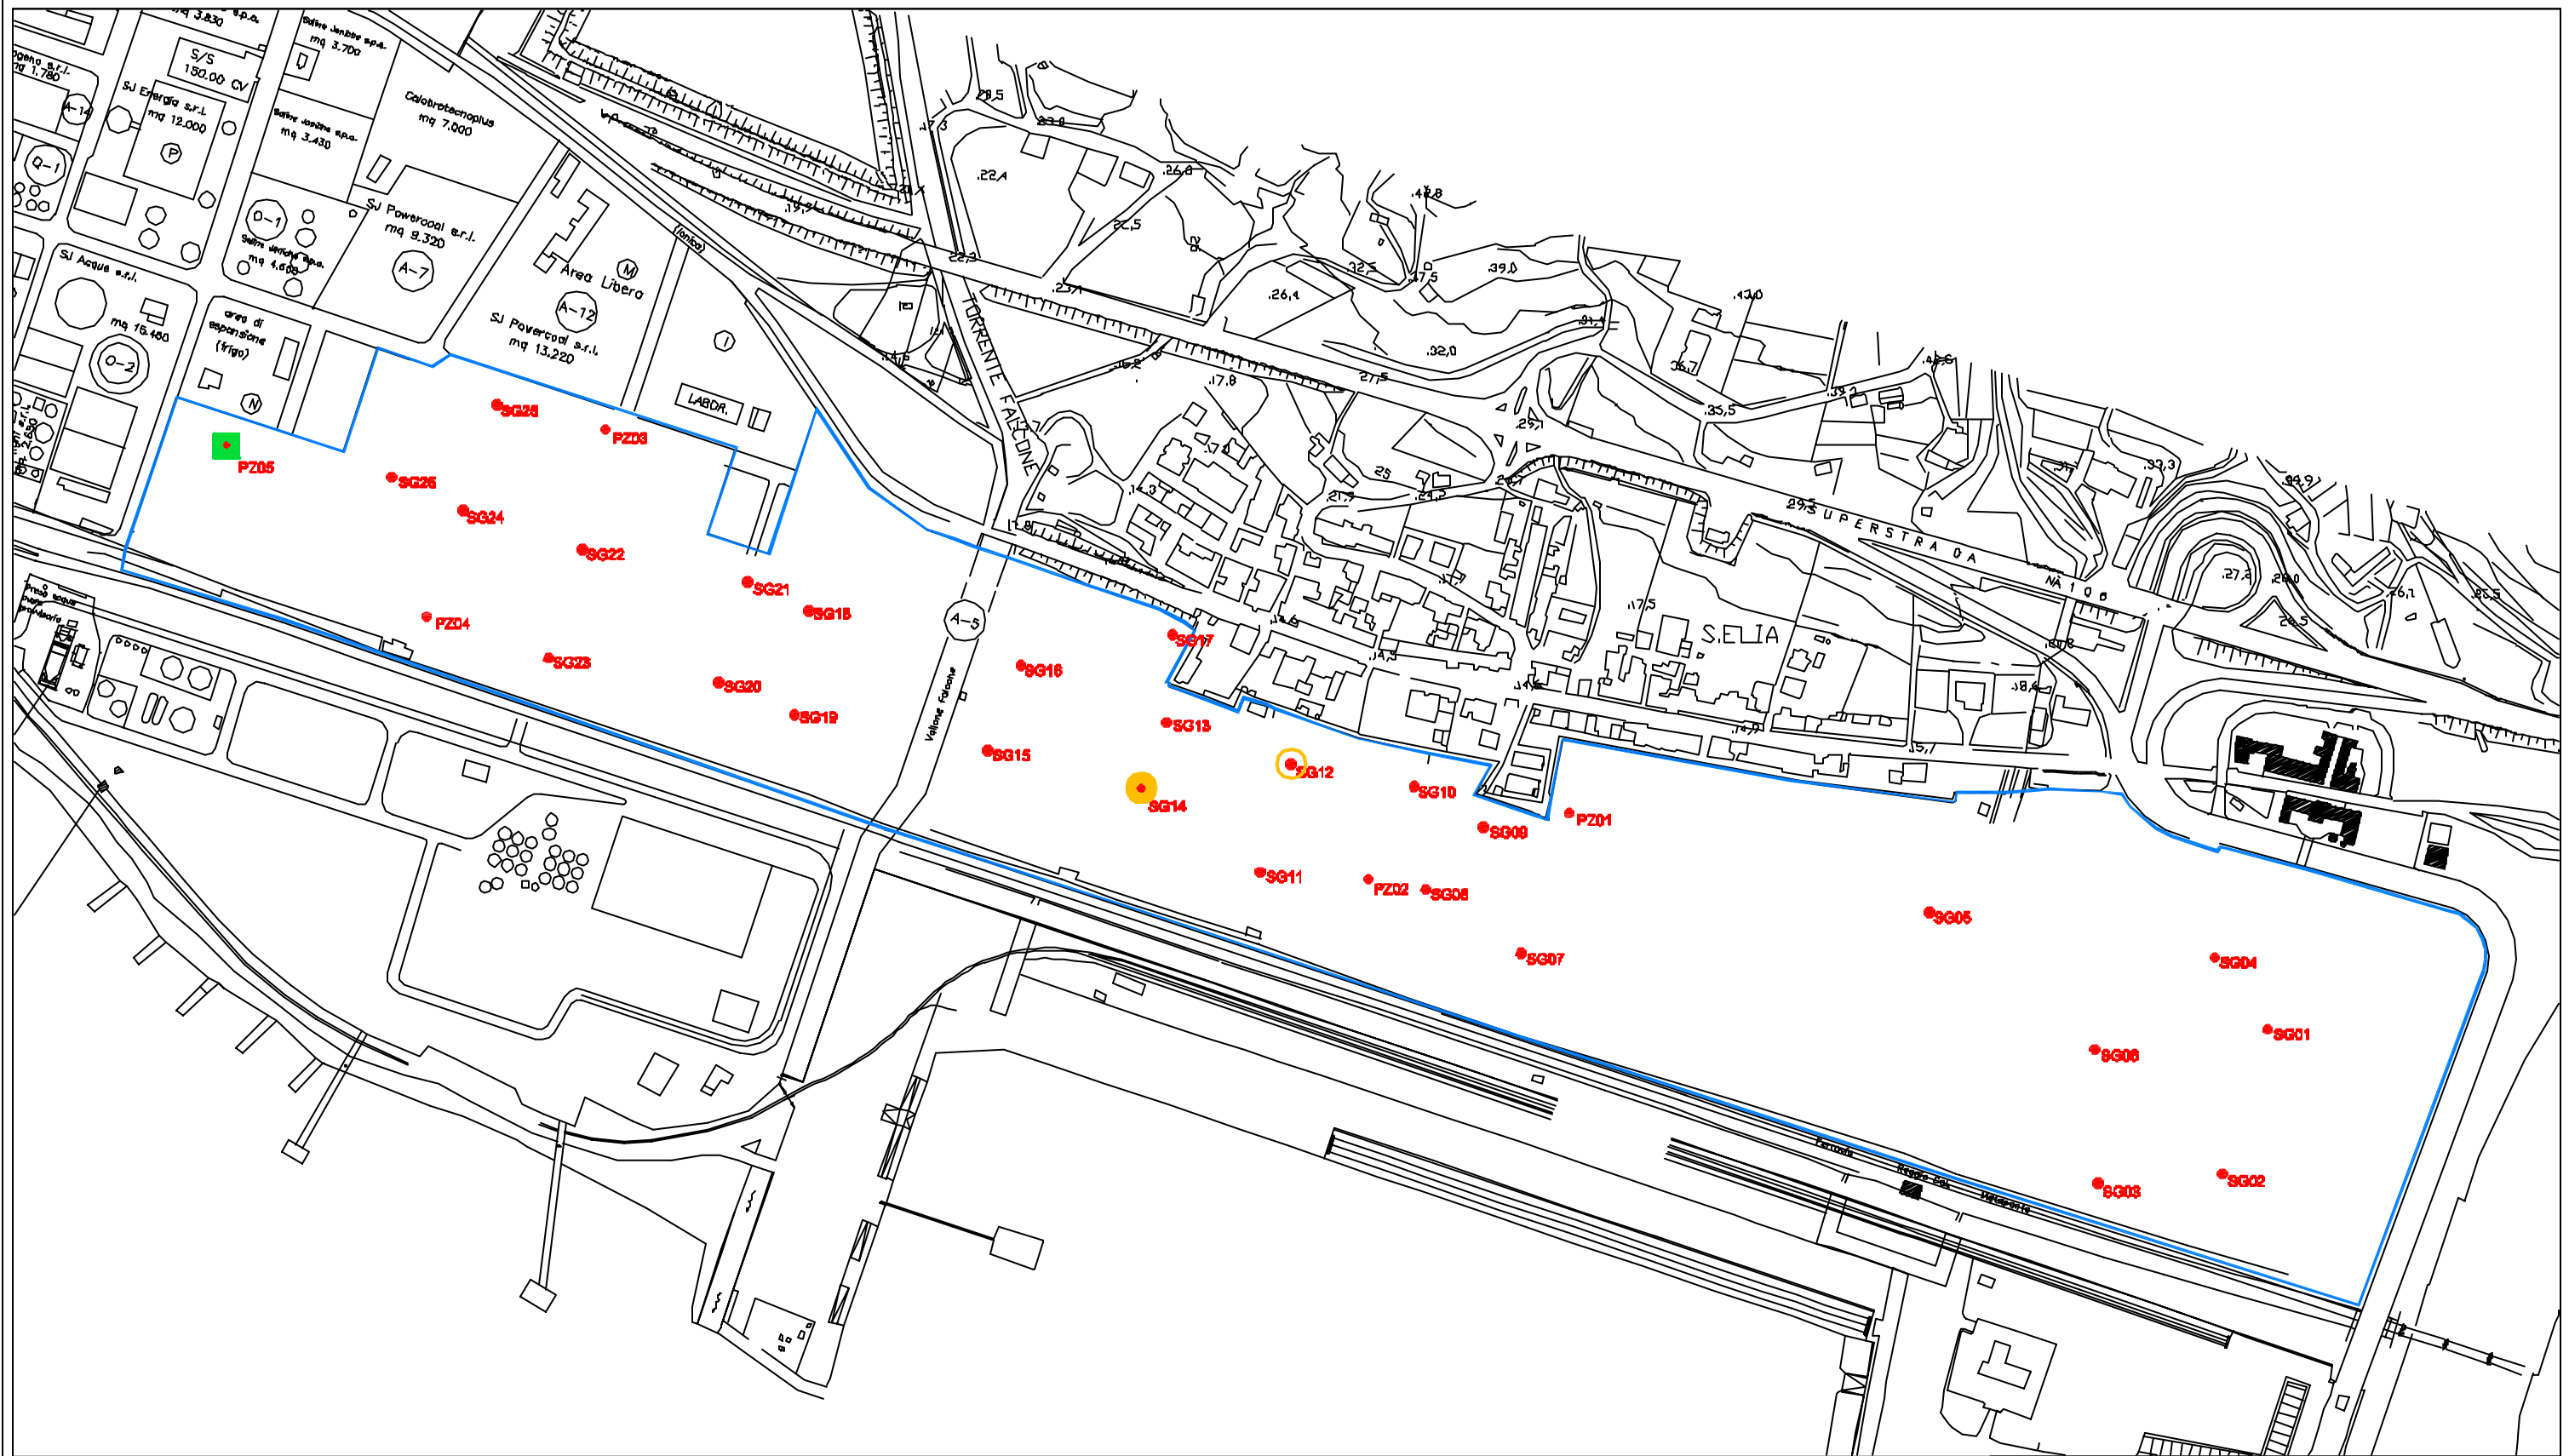

LEGENDA

- Sondaggi/Piezometri
- Eccedenze suoli per il parametro Arsenico
- Eccedenze suoli per il parametro Arsenico, non confermate in seguito a verifica analitica
- Eccedenze acque (parametri Ferro, Manganese, Solfati)

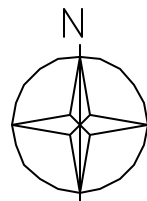

REV.	DATE	DESCRIPTION	BY	CHK	APP.
0	07/07	PRIMA EMISSIONE			
SEI S.p.A. Montebello Jonico (RC), Loc. Saline					
Mappatura della potenziale contaminazione			ORDER N°		
			SUPPLIER		
			CONTRACT N°1-BH-0344A		
			FRAME N°		
			THIS DWG SUPERSEDES	SCALE	
			THIS DWG SUPERSEDES	1:4000	
			DWG N°	REV.	
			BH0344-01-07	0	



FOSTER WHEELER ITALIANA S.p.A.
ENVIRONMENTAL DIVISION
THIS DRAWING IS THE PROPERTY OF FOSTER WHEELER ITALIANA AND IS LOAN
WITHOUT INDENTIFICATION OTHER THAN THE DRAWING'S AGREEMENT THAT IT SHALL
NOT BE REPRODUCED, COPIED, LOANED, OR OTHERWISE USED IN ANY MANNER
FOR ANY PURPOSE OTHER THAN THAT FOR WHICH IT IS SPECIFICALLY
PREPARED. THE APPLICABLE SYMBOLS IN THE DRAWING IS COVERED BY PATENTS.