
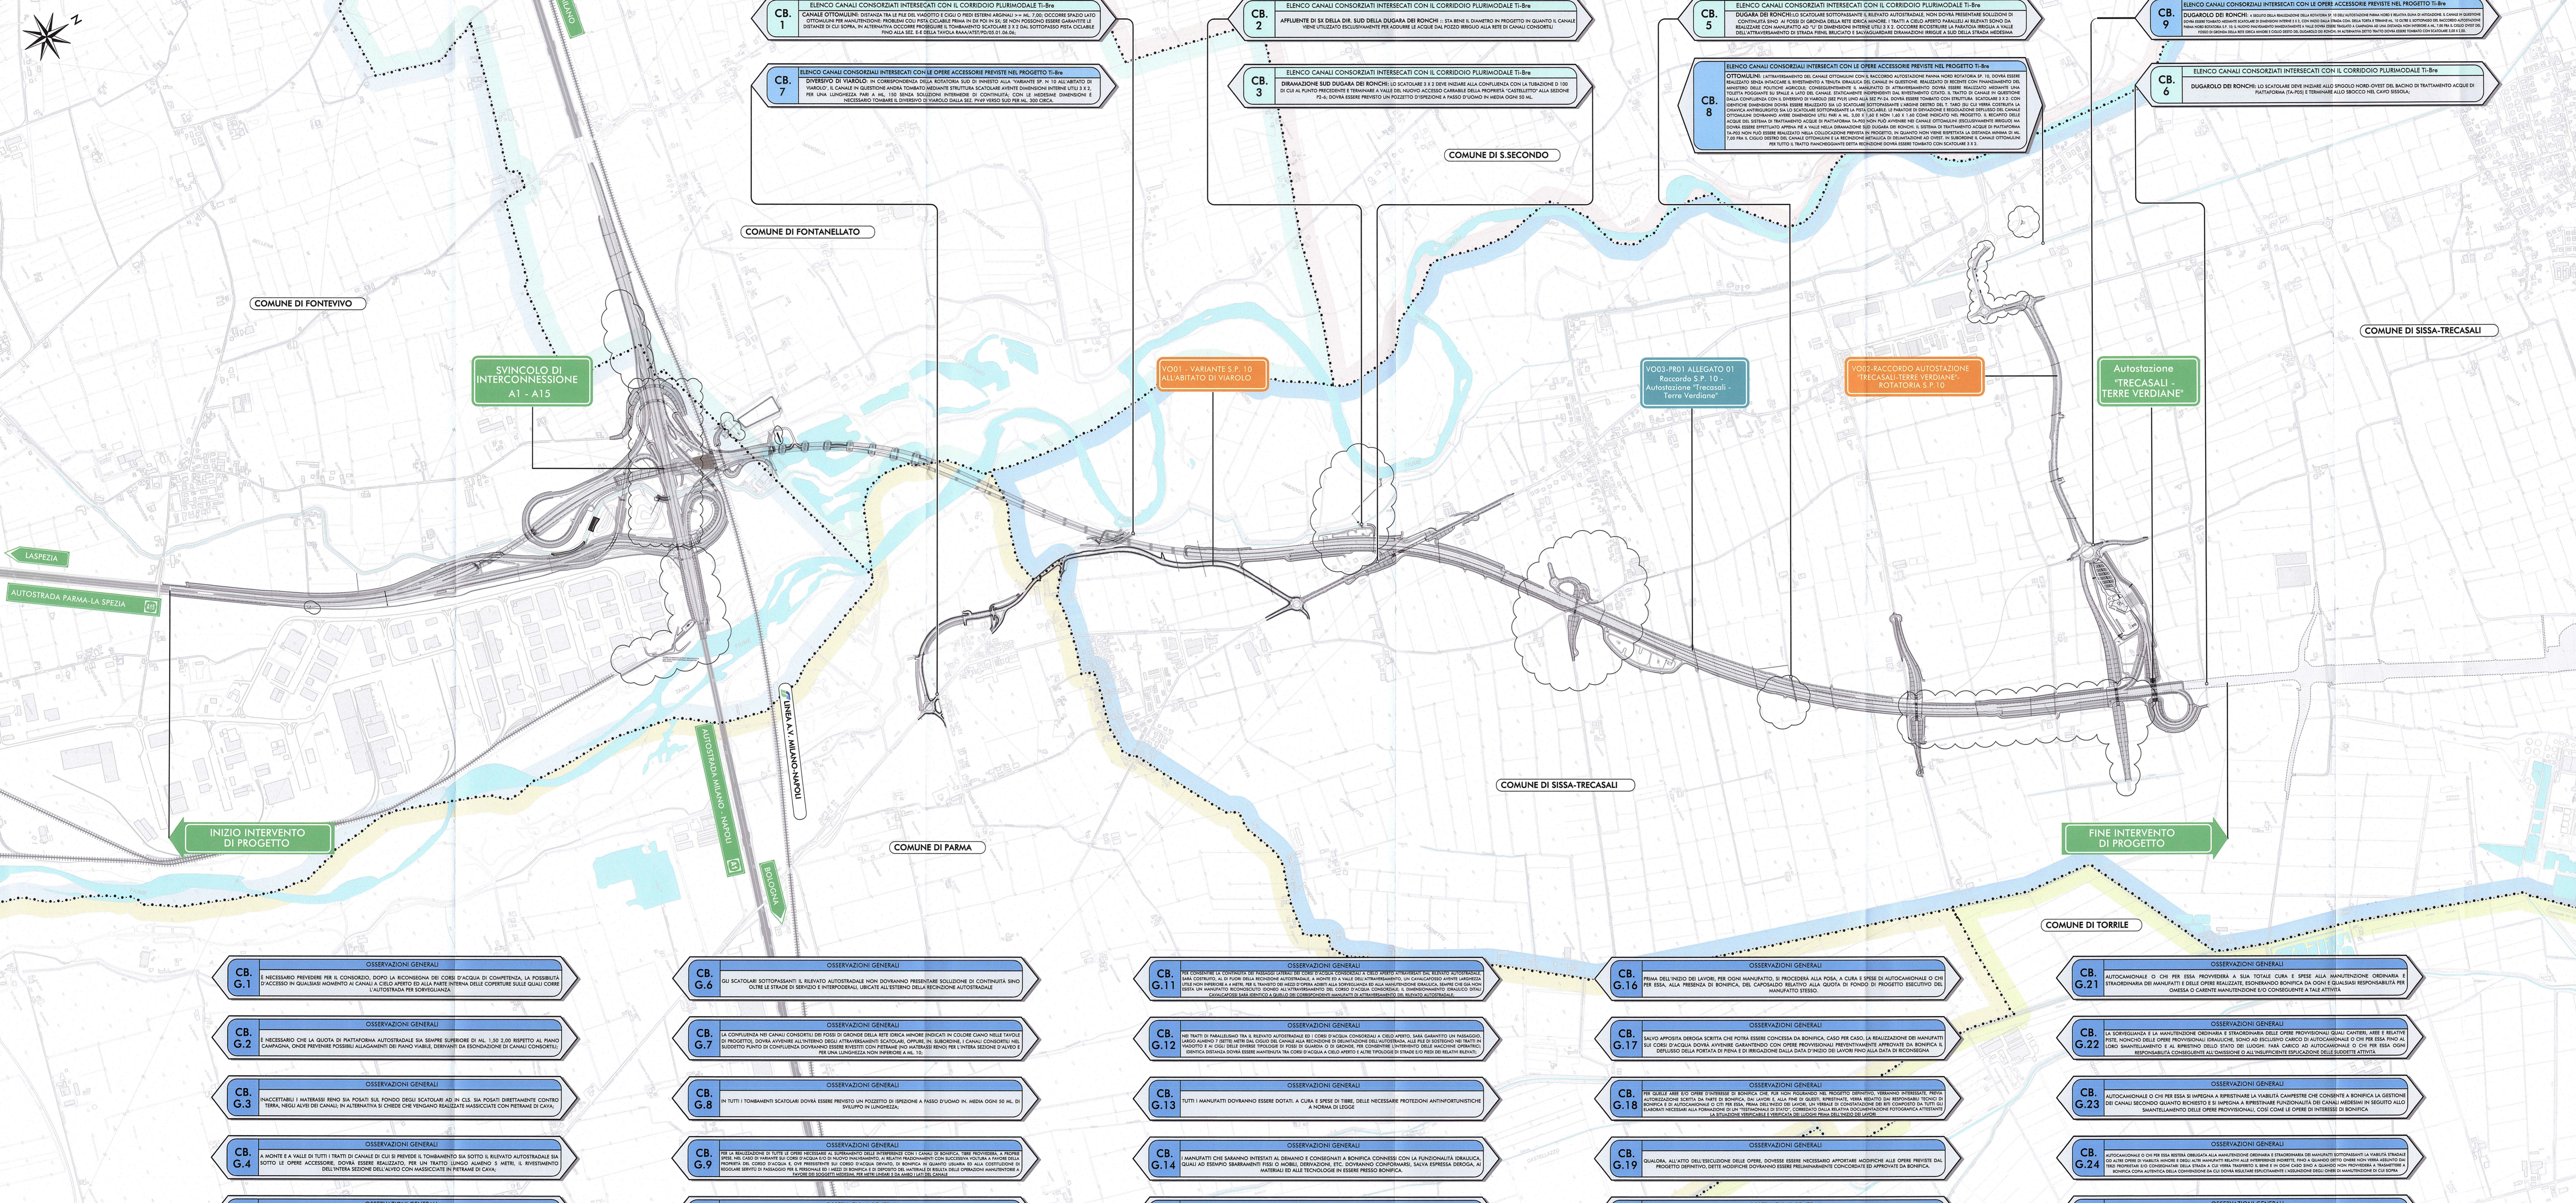



MODIFICHE PROGETTUALI DERIVANTI DALL'OTTEMPERANZA DEI QUADRI PRESCRITTIVI

Table with 2 columns: ID and Description. It lists various technical specifications and project details, including structural requirements, material specifications, and safety measures.

PLANIMETRIA DI PROGETTO  
SCALA 1:10000

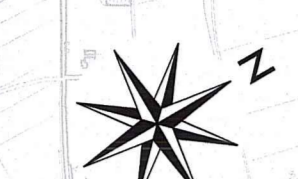

- List of 25 numbered observations (CB. 1 to CB. 25) in a grid format. Each entry includes a title (e.g., 'Osservazioni Generali') and a detailed description of the issue or recommendation related to the project's compliance with regulatory requirements.

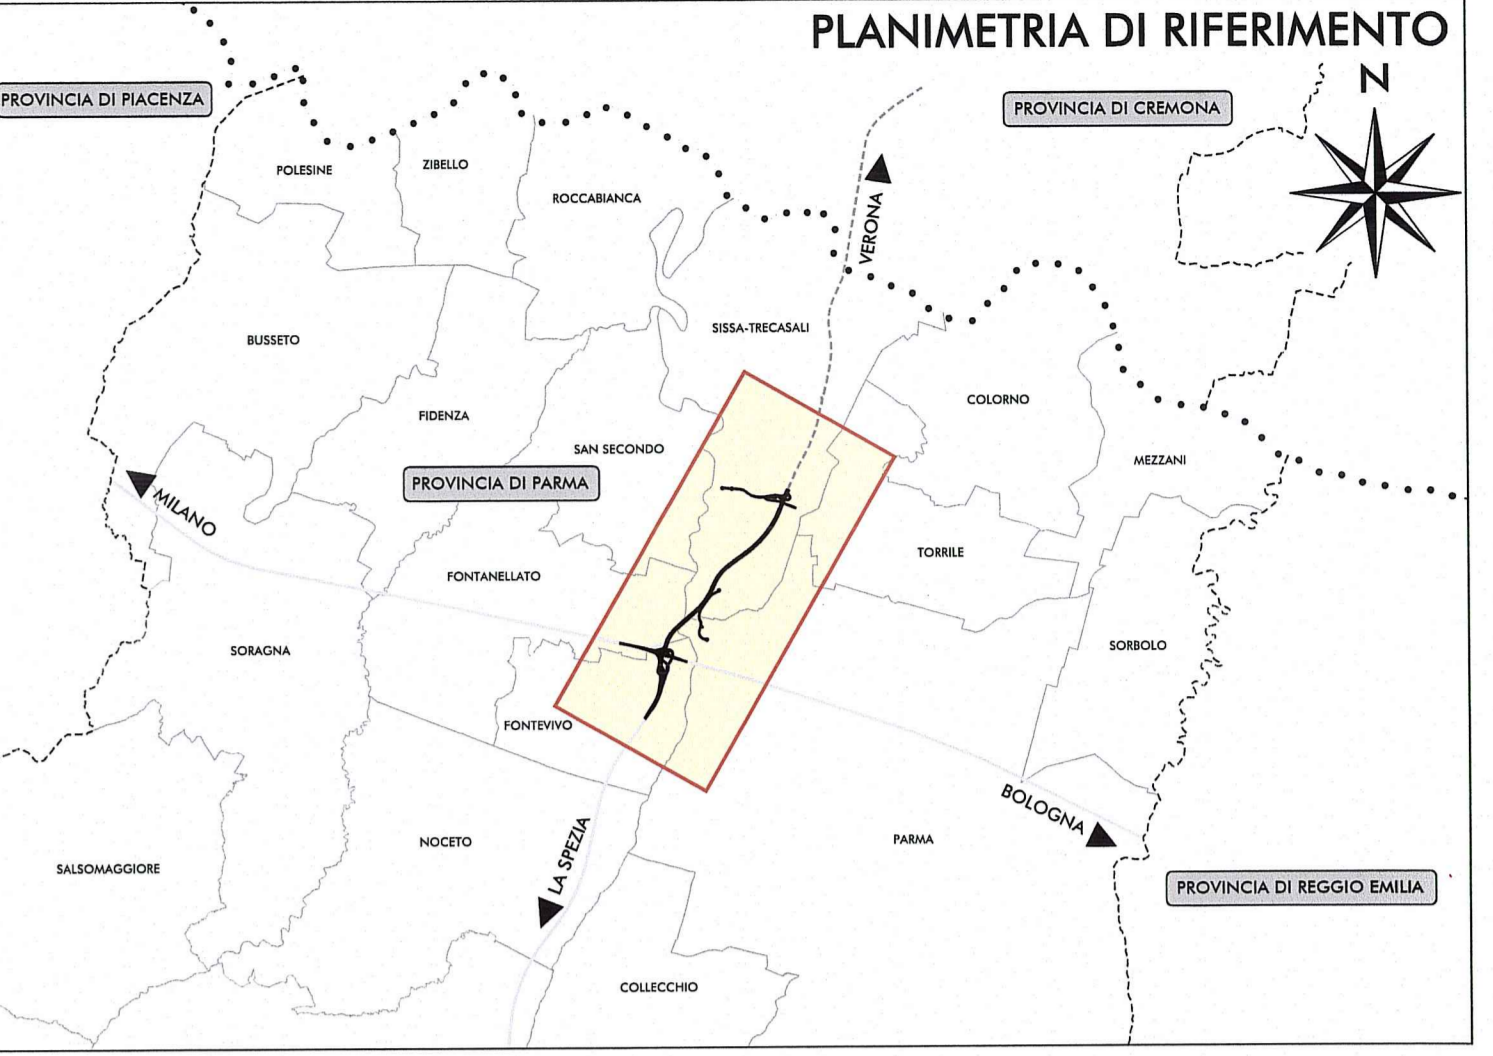

Legend (Legenda) and Prescriptions (Quadro prescrittivo) section. It defines symbols for territorial boundaries, infrastructure types, and project phases. It also includes a table of prescriptions for the project's execution and a description of the modifications made to the planimetric drawing.

Project information and administrative details. It includes the project name 'Autocamionale della CISA S.p.A.', the client 'Pizzarotti', the project location 'Via Combaora 26/A - Frazione Ponte Taro - 43015 Noceto (PR)', and the project number 'C.U.P. G618040006008'. It also lists the project manager, technical staff, and the date of the project's approval.