

Table with columns for Semistampella lato PARMA, Semistampella lato VERONA, and Semistampella lato PARMA. Rows include coordinates (C7-C14) and various data points for different sections.

Table with columns for Semistampella lato PARMA, Semistampella lato VERONA, and Semistampella lato PARMA. Rows include coordinates (C1-C14) and various data points for different sections.

Table with columns for Semistampella lato VERONA, Semistampella lato PARMA, and Semistampella lato VERONA. Rows include coordinates (C1-C14) and various data points for different sections.


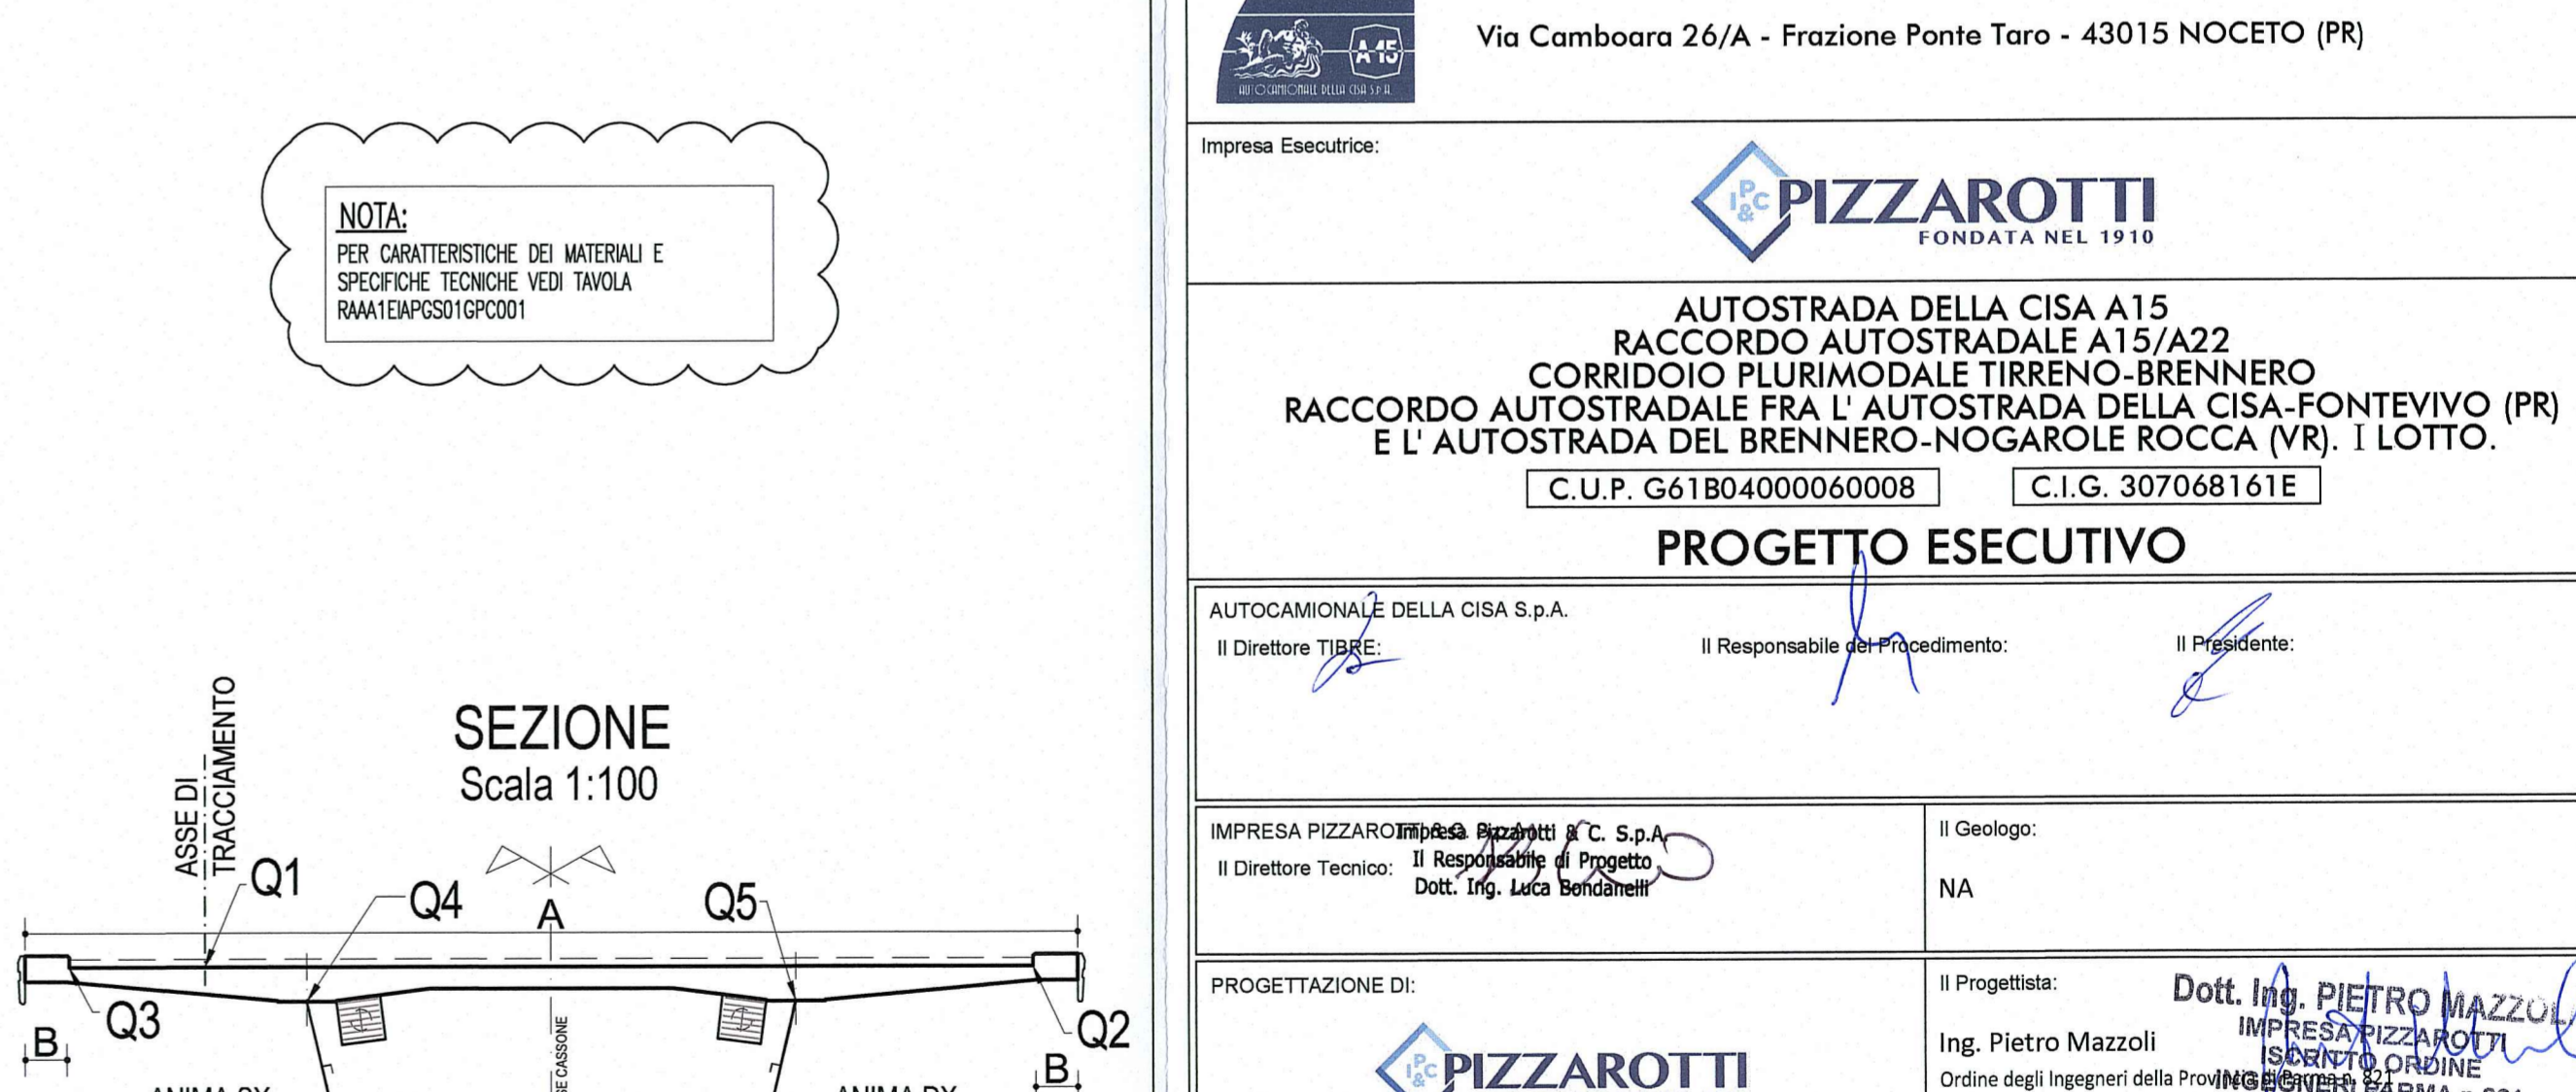


Table with columns for Semistampella lato VERONA, Semistampella lato PARMA, and Semistampella lato VERONA. Rows include coordinates (C1-C14) and various data points for different sections.

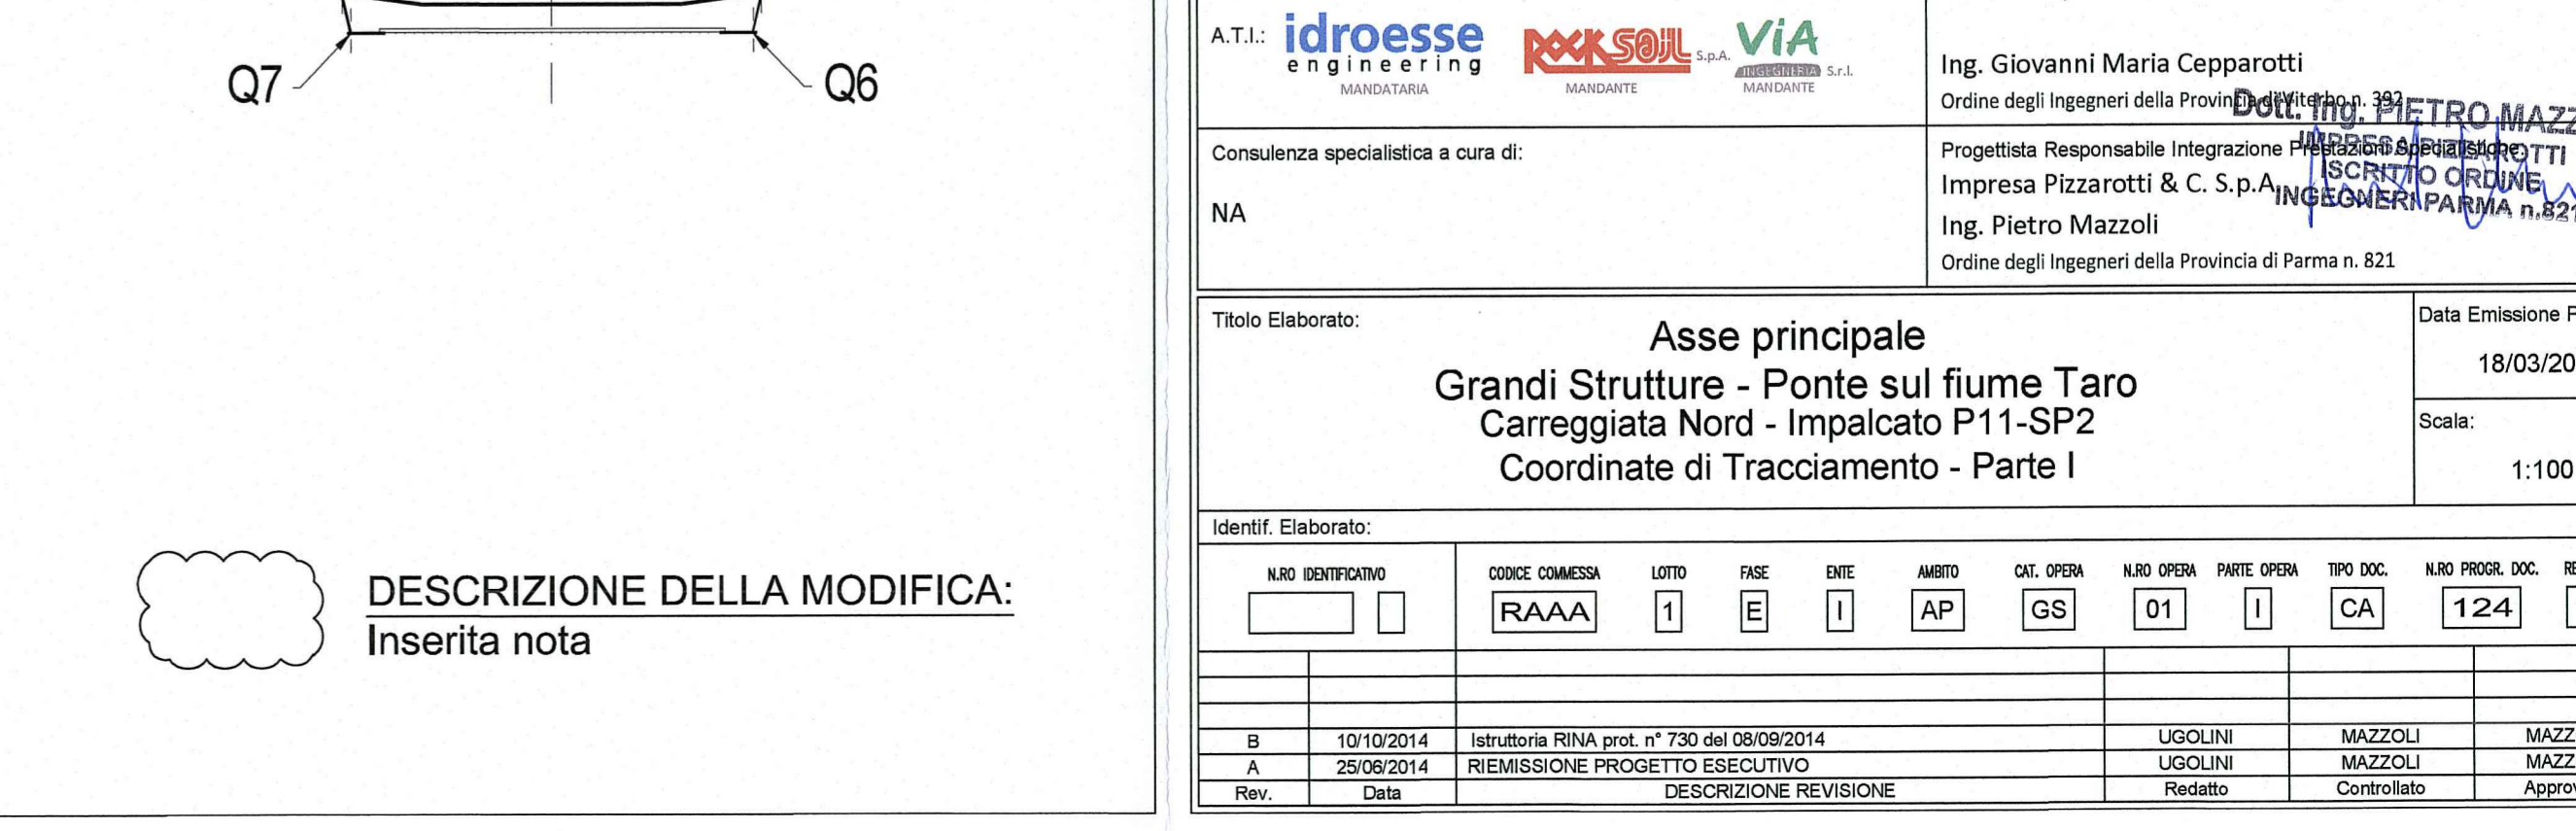

Project information including: Autocomionale della CISA S.p.A., Impresa Esecutrice: Impresa Pizzarotti S.p.A., Progetto Esecutivo, and various technical details and signatures.