



GROUND FLOOR PLAN

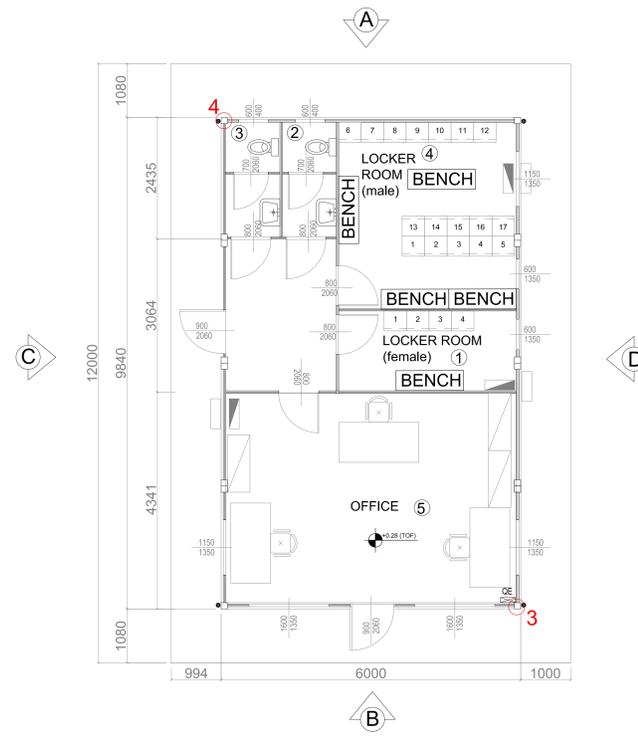







ROOF PLAN

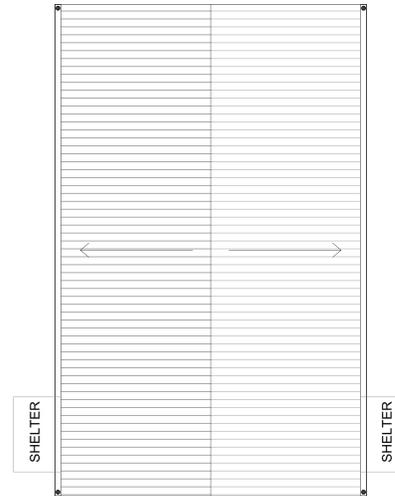


FURNITURE AND EQUIPMENT		
ITEM	DESCRIPTION	Q.TY
	SCRIVANIA cm 160x80 CON CASSETTIERA DESK cm 160x80 WITH DRAWERS	1
	POLTRONCINA GIREVOLE CON BRACCIOI SWIVEL ARMCHAIR	1
	CONDIZIONATORE SPLIT SYSTEM A POMPA DI CALORE SPLIT-SYSTEM AIR CONDITIONING HEAT PUMP	4
	APPENDI ABITI HANGER	1
	ARMADIO METALLICO cm 120x45 h 150 ANTE SCORREVOLI METALLIC CUPBOARD cm 120x45 h 150 SLIDING WINGS	1
	ARMADIO LOCKER	21

AERIAL/LIGHTING SURFACE RATIO

ROOM	SURFACE	RULE SURFACE	PROJECT SURFACE
<b>GROUND FLOOR</b>			
1 Lockers	mq. 5.70	1/8	mq. 0.71
2 Female wc	mq. 2.50	1/12	mq. 0.21
3 Male wc	mq. 2.50	1/12	mq. 0.21
4 Lockers	mq. 13.30	1/8	mq. 1.66
5 Office	mq. 24.40	1/8	mq. 3.05

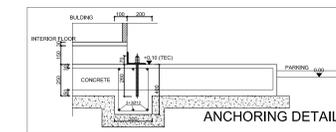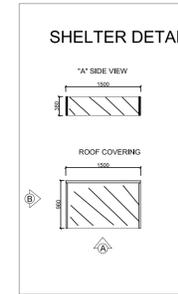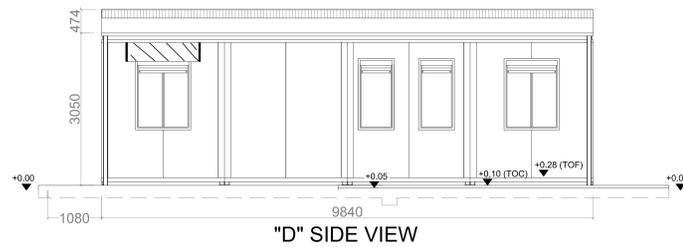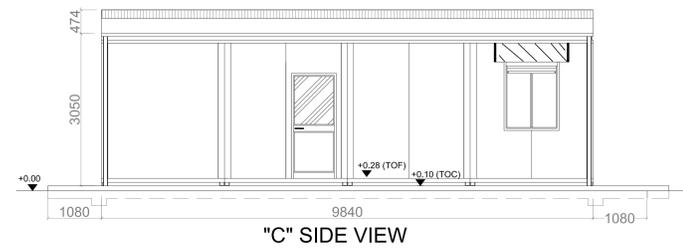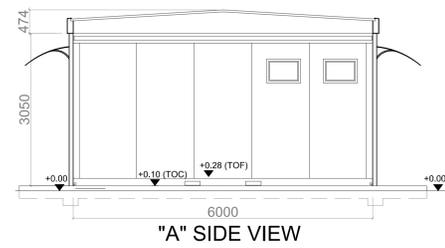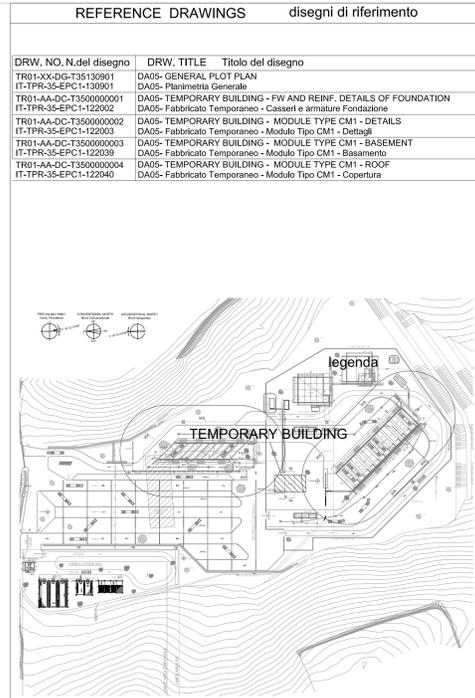

NOTE  
All dimensions in the plans  
are external and in mm.

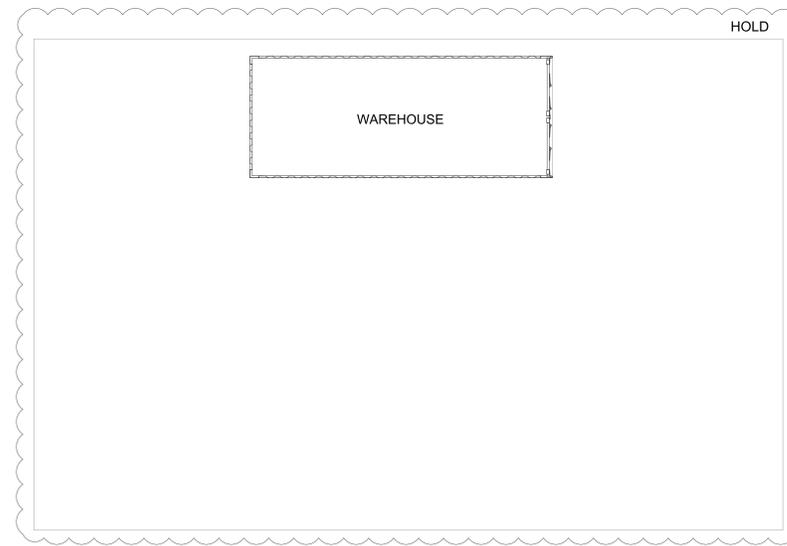

- HOLD LIST in sospeso
- HOLD 01:  
- WAREHOUSE  
- TECHNICAL BUILDING
- In sospeso 01:  
- Magazzino  
- Edificio tecnico



Rev	Date	Status	Revision Memo	Issued by	Checked by	Approved by
01	06-Mar-2017	IFC	REVISION	S.IANNACE	F.DE BLASIO	F. DE BLASIO
00	20-Jan-2017	IFC	FIRST ISSUE	S.IANNACE	F.DE BLASIO	F.DE BLASIO



This Document is the property of TOTAL and shall not be disclosed to third parties or reproduced without permission of the owner. This document has been generated by an Electronic Document Management System. When printed it is considered as a for information only copy. The controlled copy is the screen version and it is the holder's responsibility that he/she holds the latest valid version.

DA5 - CRUDE OIL LOADING AREA / Area di carico		TEMPORARY BUILDING - ARCHITECTURAL PROJECT	
Fabbricato Temporaneo - Progetto Architettonico			
Doc type: DRW	Syst. / S-Syst.: 00	Discipline: CIV	Electronic Filename: IT-TPR-35-EPC1-123004_rev01.dwg
COMPANY Document N°	IT-TPR-35-EPC1-123004	REV. 01	Scale: 1:50 Class: 2
CONTRACTOR Document N°	TR01-AW-DA-T350000002	Format: A0	Folio: 1 of 1



This document is the property of TOTAL. Information contained herein shall not be used, copied, communicated or disclosed in whole or in part WITHOUT PRIOR WRITTEN AGREEMENT.