


Allegato 4.3C

Stratigrafie e Schede di Rilevamento Pozzi SEA

SCHEDA RILEVAMENTO PIEZOMETRICO

POZZO:	L	UTILIZZO:	Potabile
COMUNE:	Lonate P.	FOGLIO:	2
COORDINATE	1477906 X	5051289 Y	MAPPALE: 3929
			45°36'50" N

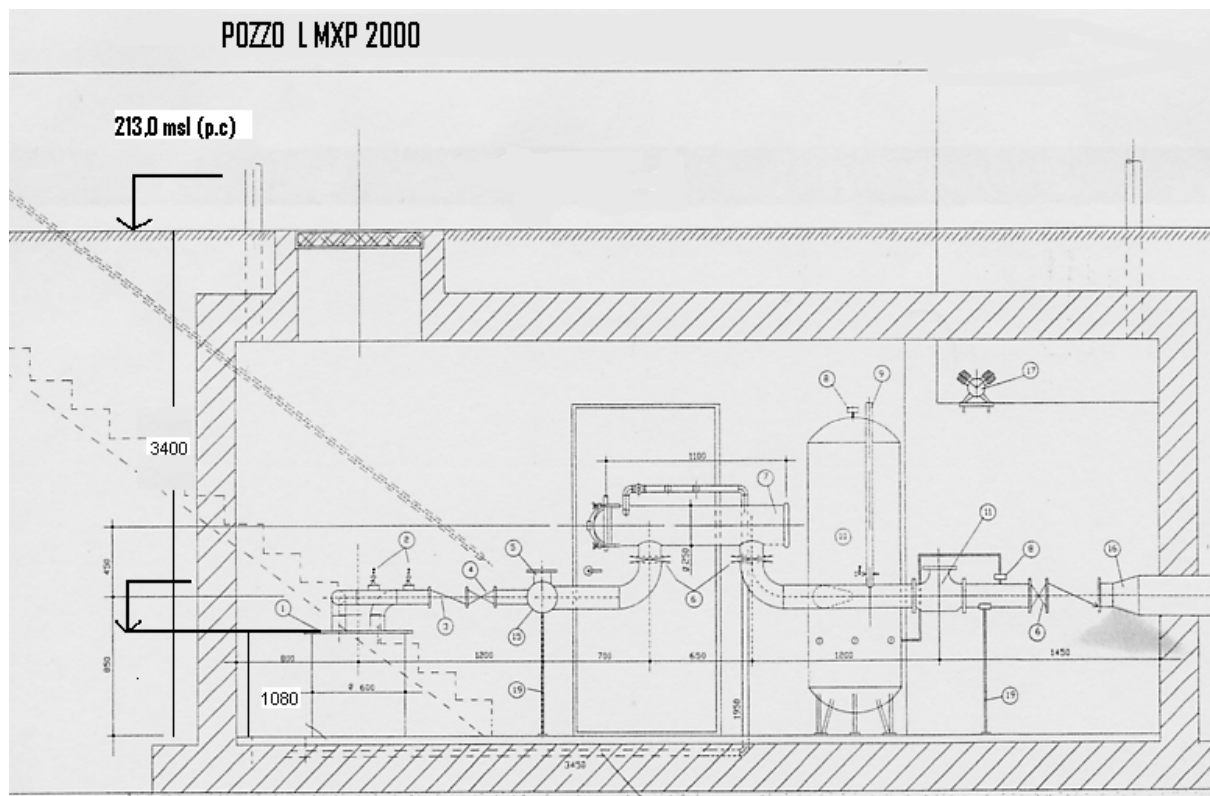

Data	Q piano campagna (m.s.l.m.)	Quota bocca pozzo (m.s.l.m.)	Livello falda (m)	Soggiacenza (m)
21/02/2006	213,0	211,28	161,78	49,50
07/03/2006	213,0	211,28	161,08	50,20
08/05/2006	213,0	211,28	160,98	50,30
12/07/2006	213,0	211,28	156,28	55,00
19/09/2006	213,0	211,28	160,78	50,50
21/11/2006	231,0	211,28	160,68	50,60
15/01/2007	231,0	211,28	156,28	55,00