



# ENI S.p.A - Refining & Marketing Stabilimento di Produzione Olii e Grassi (STAP)

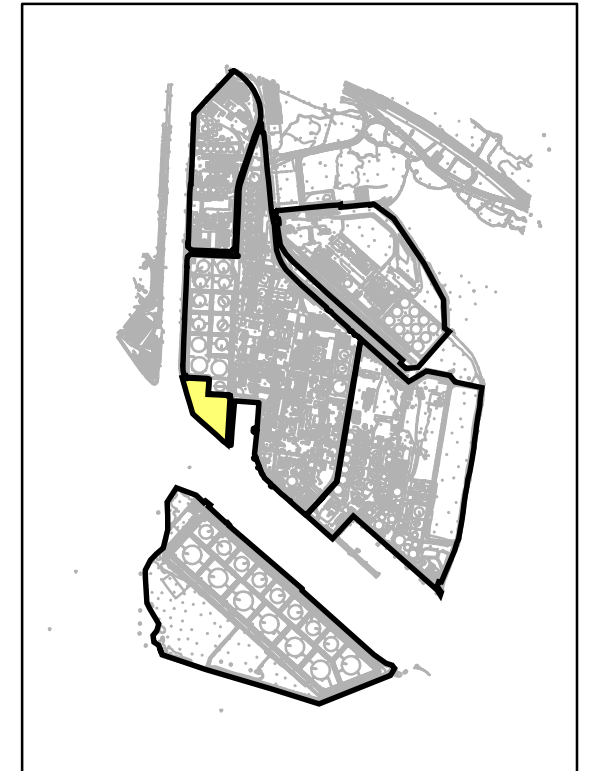

1:1.000

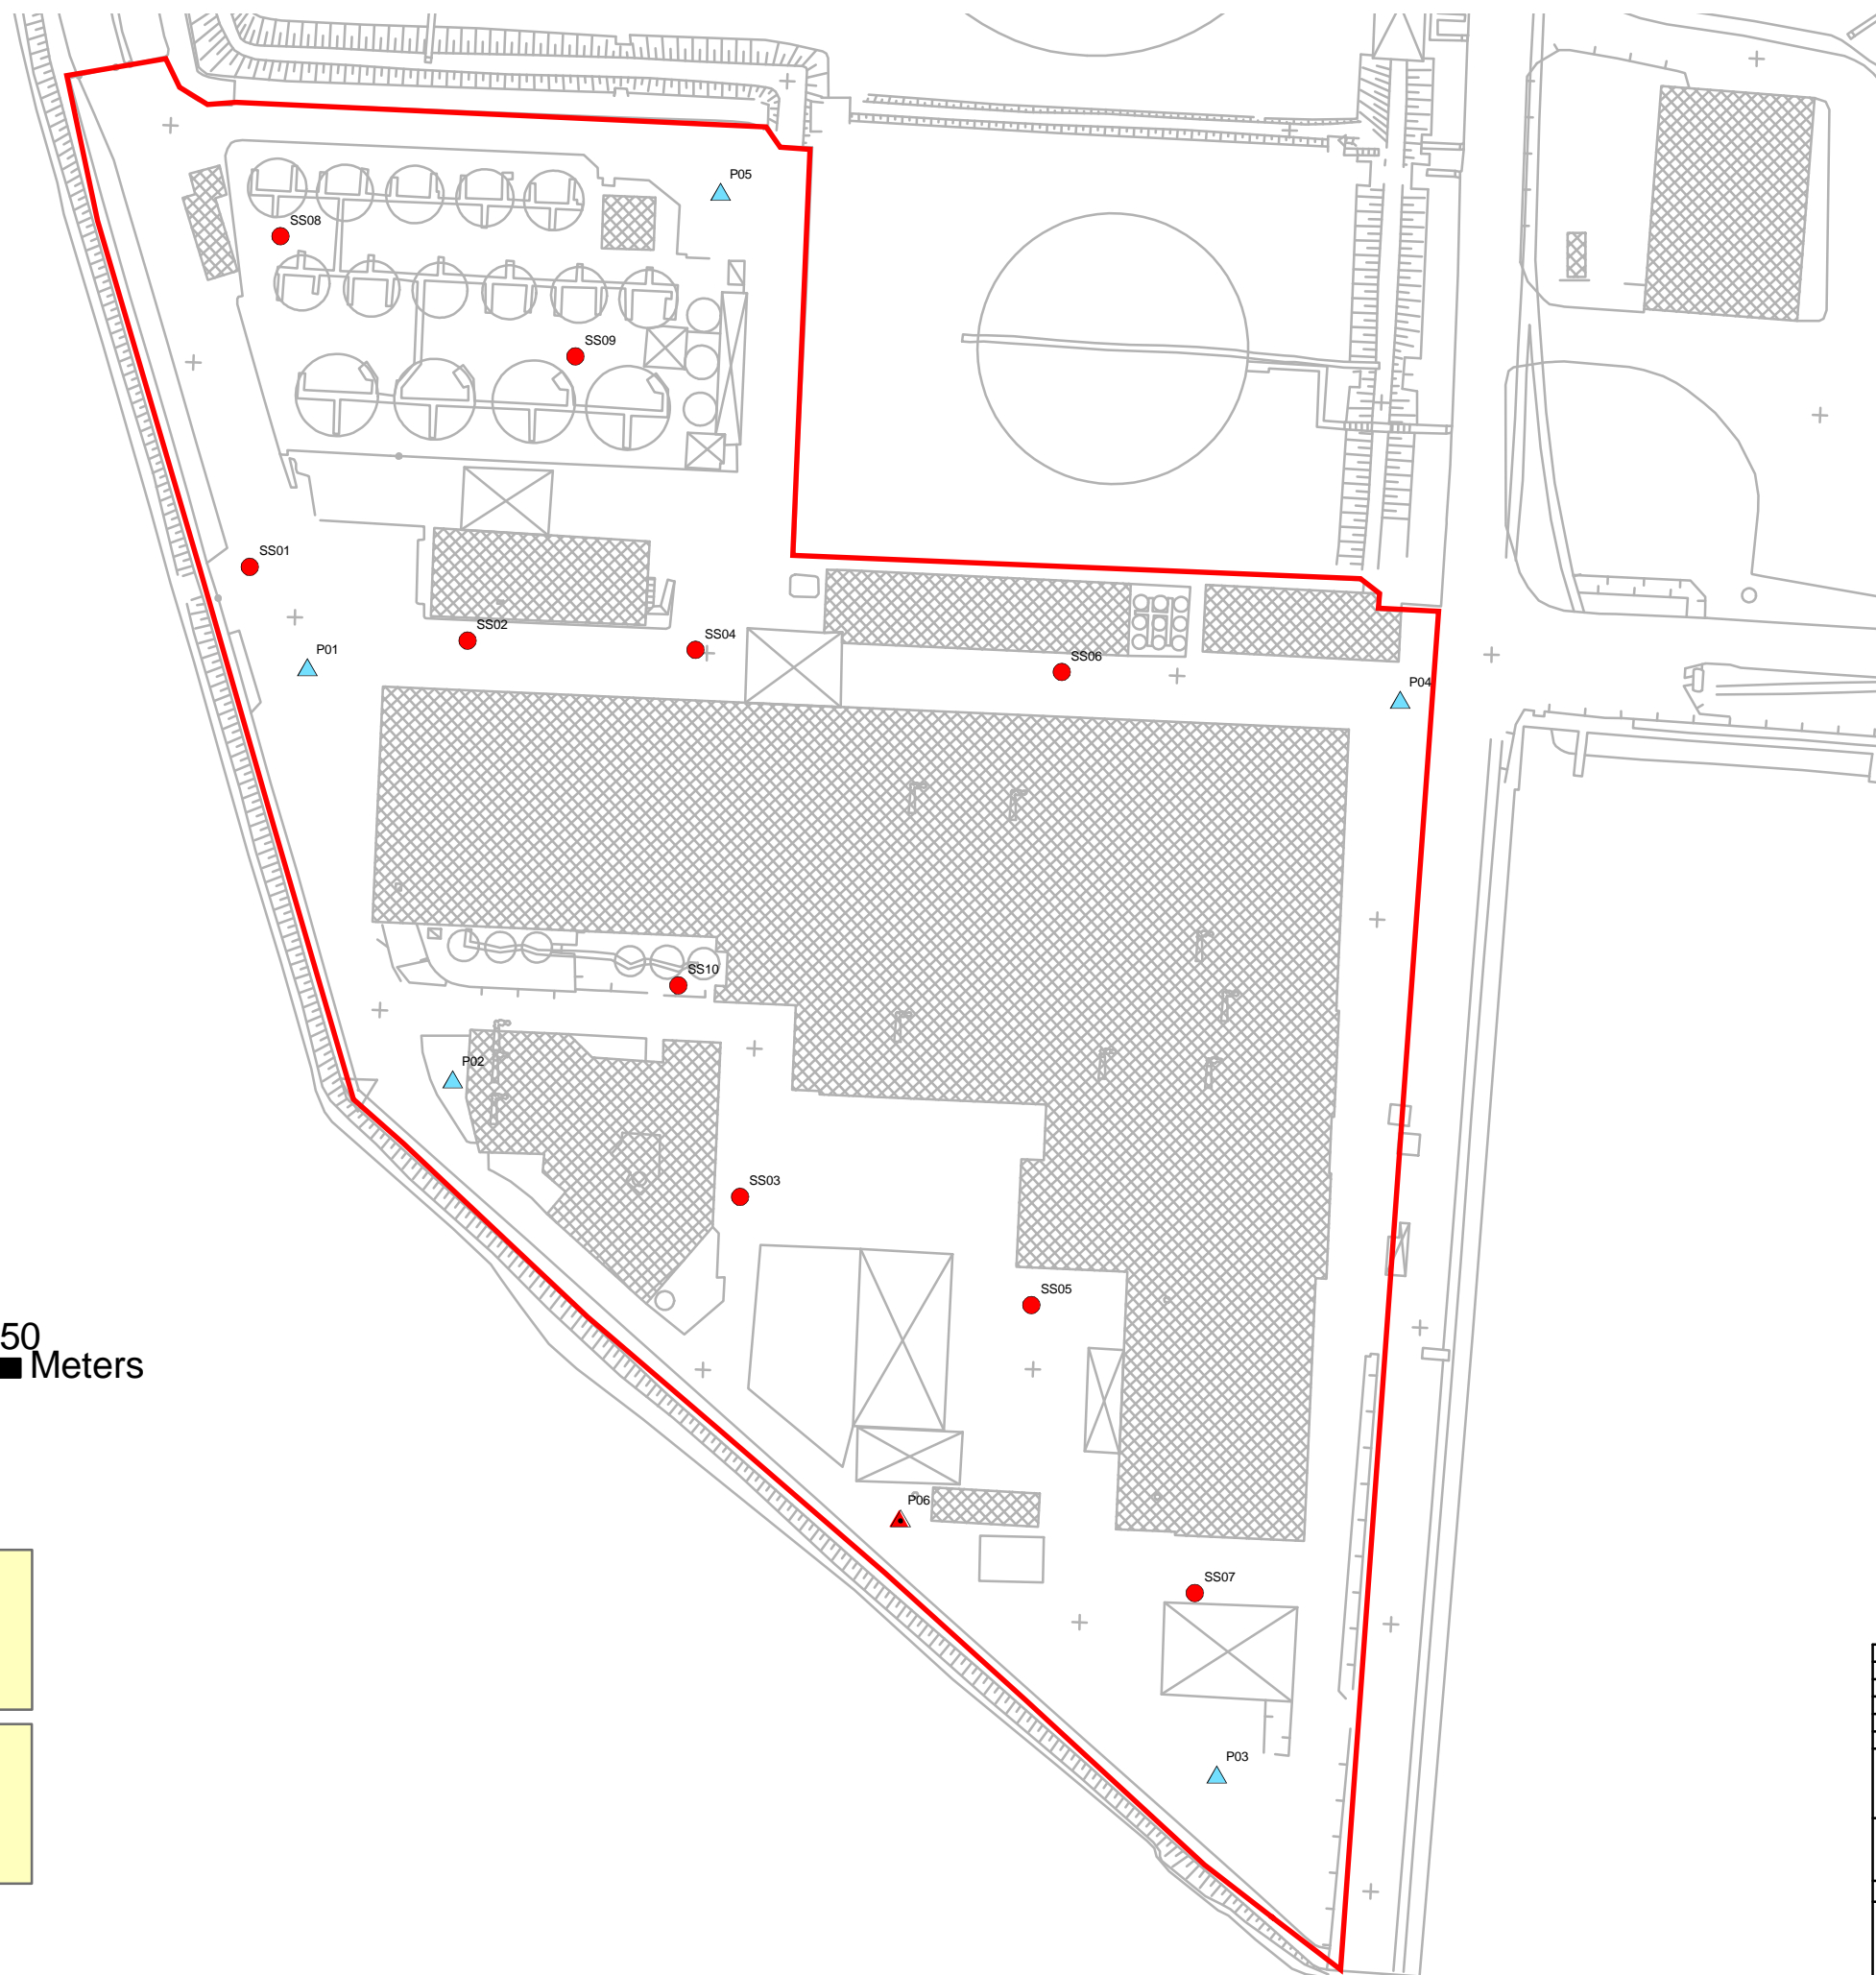

**Legenda**

**Investigazioni Foster Wheeler 2004**

- ▲ Piezometro di riporto
- ▲ Piezometro 1° falda
- Sondaggio

**Investigazioni progresse**

- ▲ Piezometro di riporto
- ▲ Piezometro 1° falda

Confine Area STAP

— Base Cartografica

REV.	DATE	DESCRIPTION	DRAW	BY	CHK	APP.
0	20.12.04	prima emissione	A.C.	A.C.	M.B.	D.A.

<b>Eni S.p.A. - Divisione Refining &amp; Marketing Stabilimento di Produzione - Olii e Grassi (STAP)</b>		APPROVED FOR CONSTRUCTION	
SIGNATURE		DATE	
ORDER N. *		CONTRACT N. *	
SUPPLIER		1-BH-0220	
FRAME N. *		SCALE	
FOSTER WHEELER ITALIANA S.p.A. ENVIRONMENTAL DIVISION		1:1000	
LAYOUT #		REV.	
Fig. 1		0	

**FOSTER WHEELER ITALIANA S.p.A.**  
ENVIRONMENTAL DIVISION

THIS DRAWING IS THE PROPERTY OF FOSTER WHEELER ITALIANA AND IS LENT WITH  
OUT CONSIDERATION OTHER THAN THE BORROWER'S AGREEMENT THAT IT SHALL  
NOT BE REPRODUCED, COPIED, LENT OR DISPOSED OF DIRECTLY OR INDIRECTLY,  
HOW USED FOR ANY PURPOSE OTHER THAN THAT FOR WHICH IT IS SPECIFICALLY  
FURNISHED THE APPARATUS SHOWN IN THE DRAWING IS COVERED BY PATENTS.