
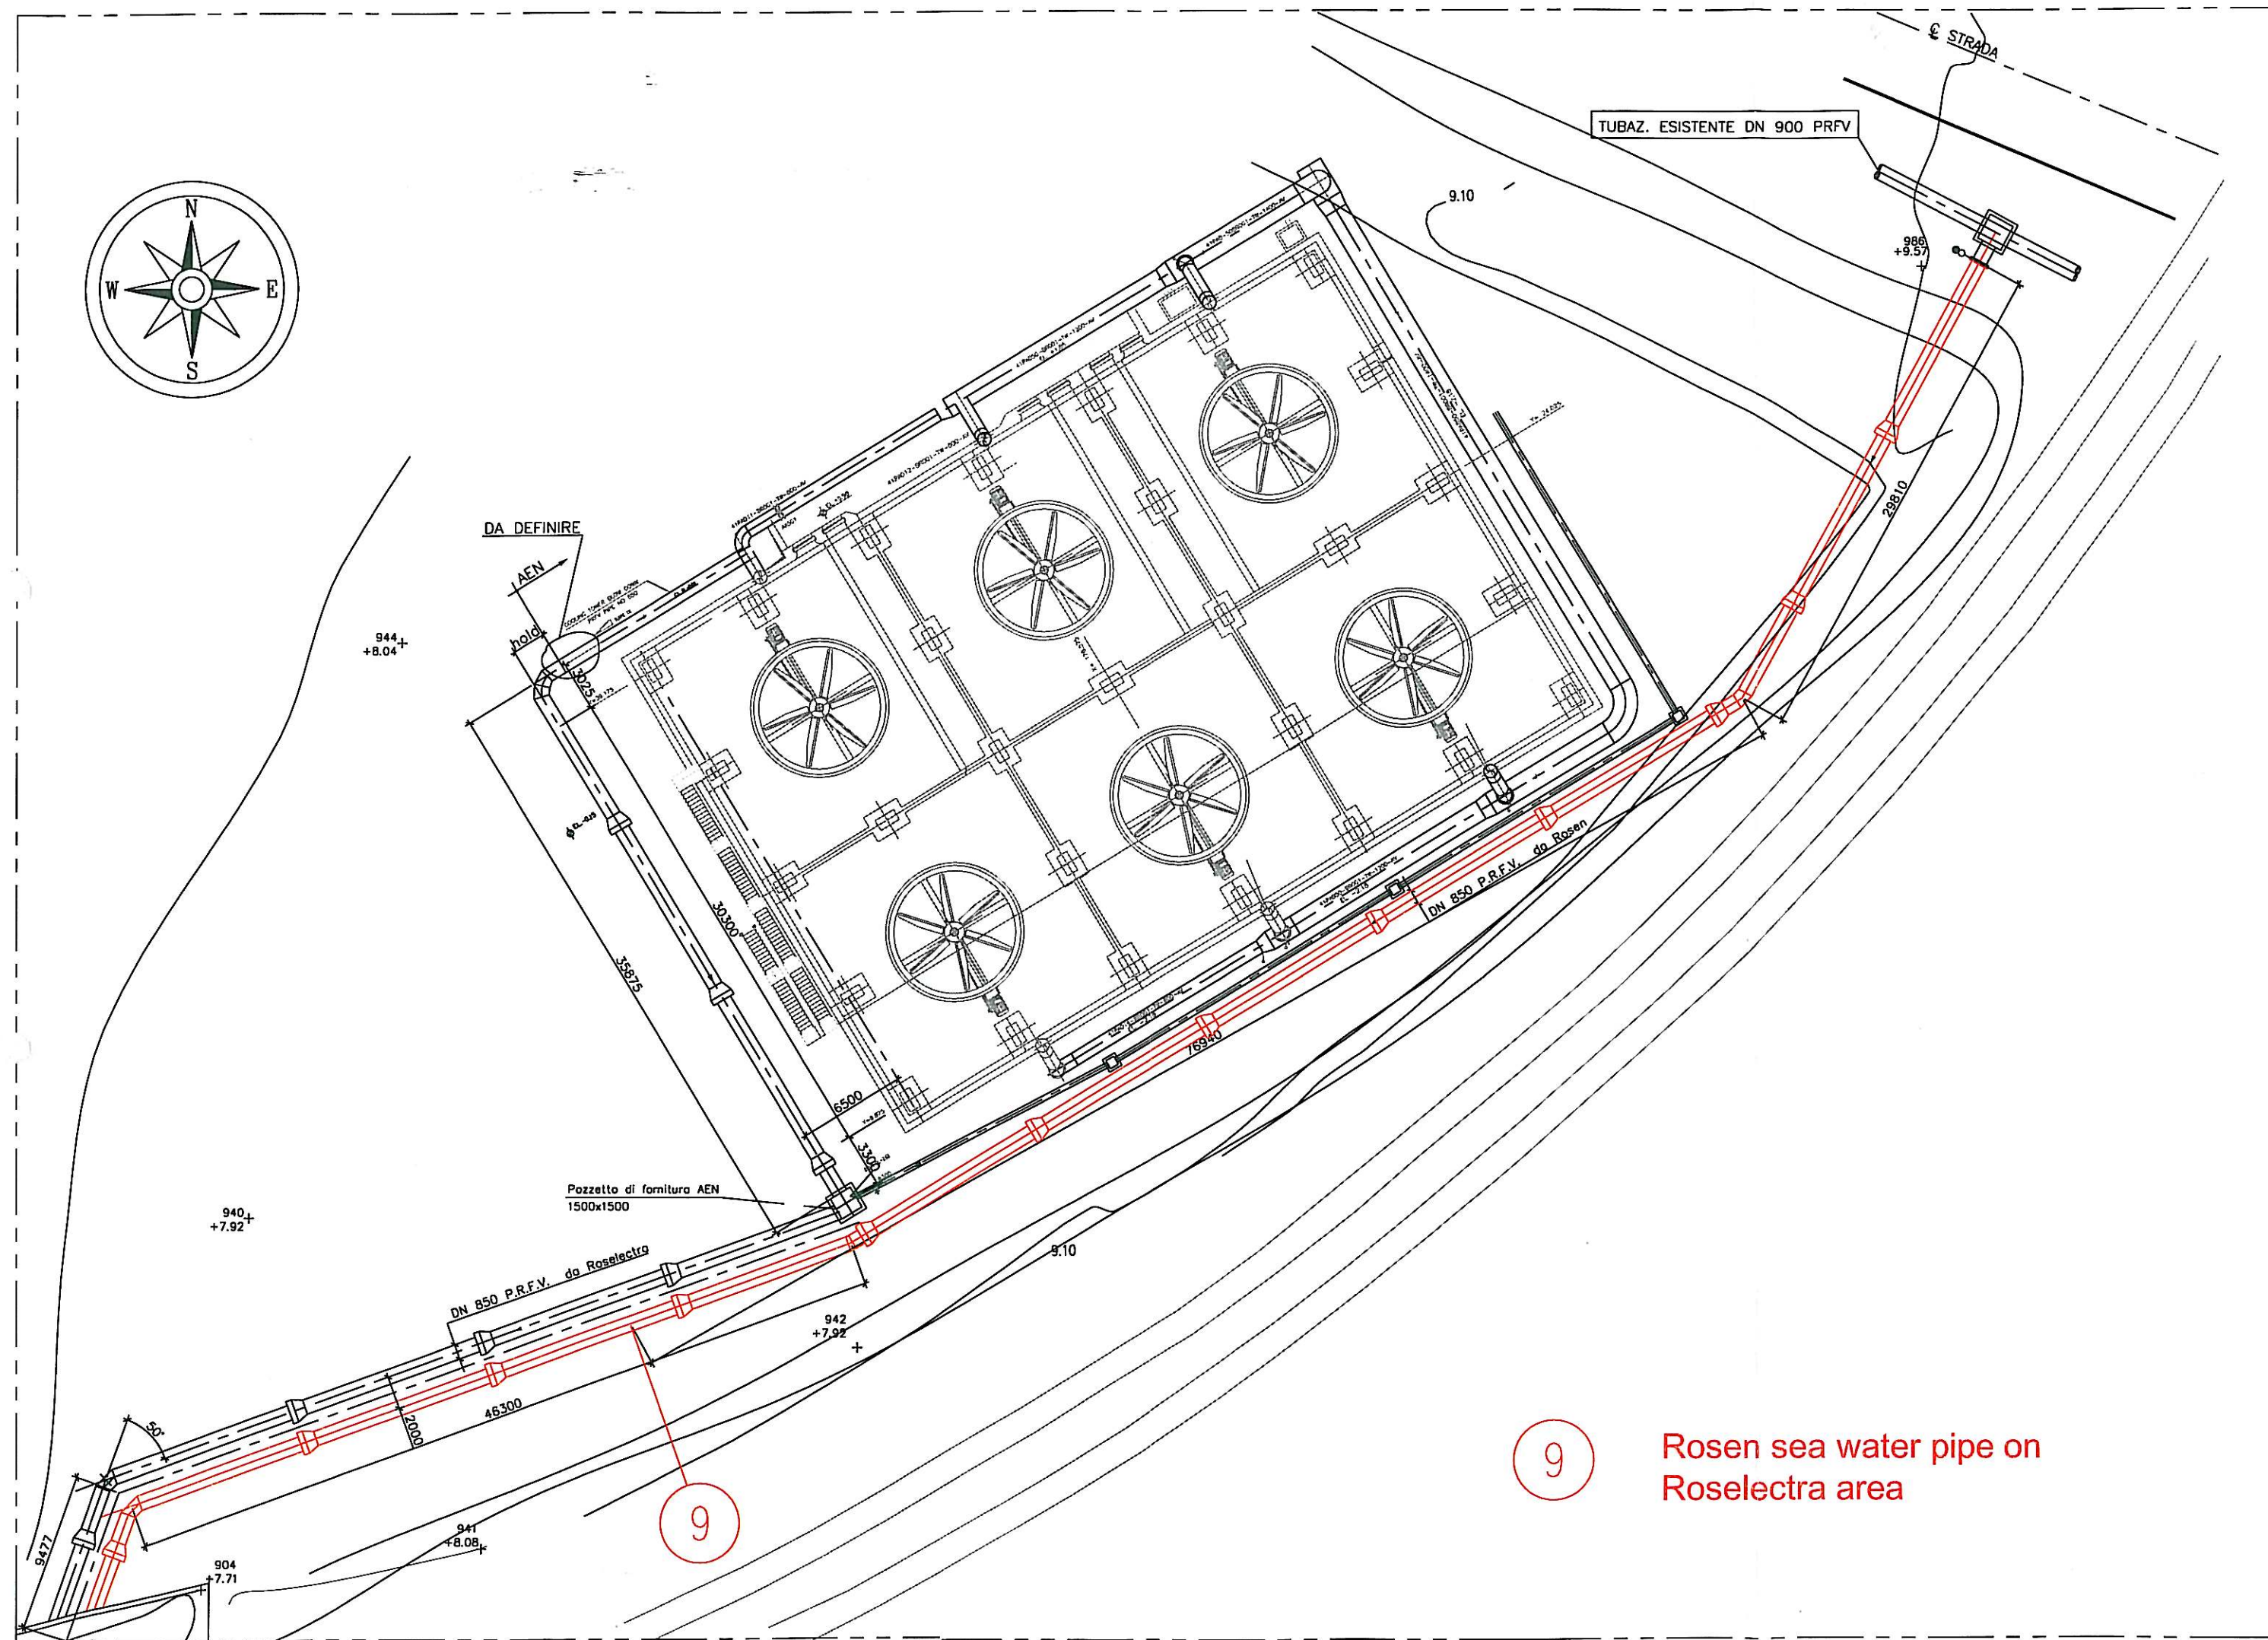


-

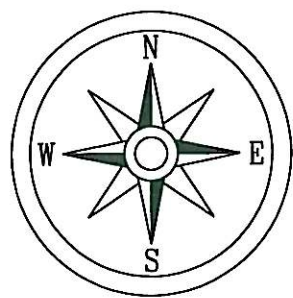

9

Rosen sea water pipe on
Roselectra area

10: Interventions in the power substation

A: connection transformer-terminals cable 380 kv (area belonging part to Rosen and part to Terna)

B: several control cables and power cables

C: 6 kv back-up supply + changes protections

