



NORTH PLANT

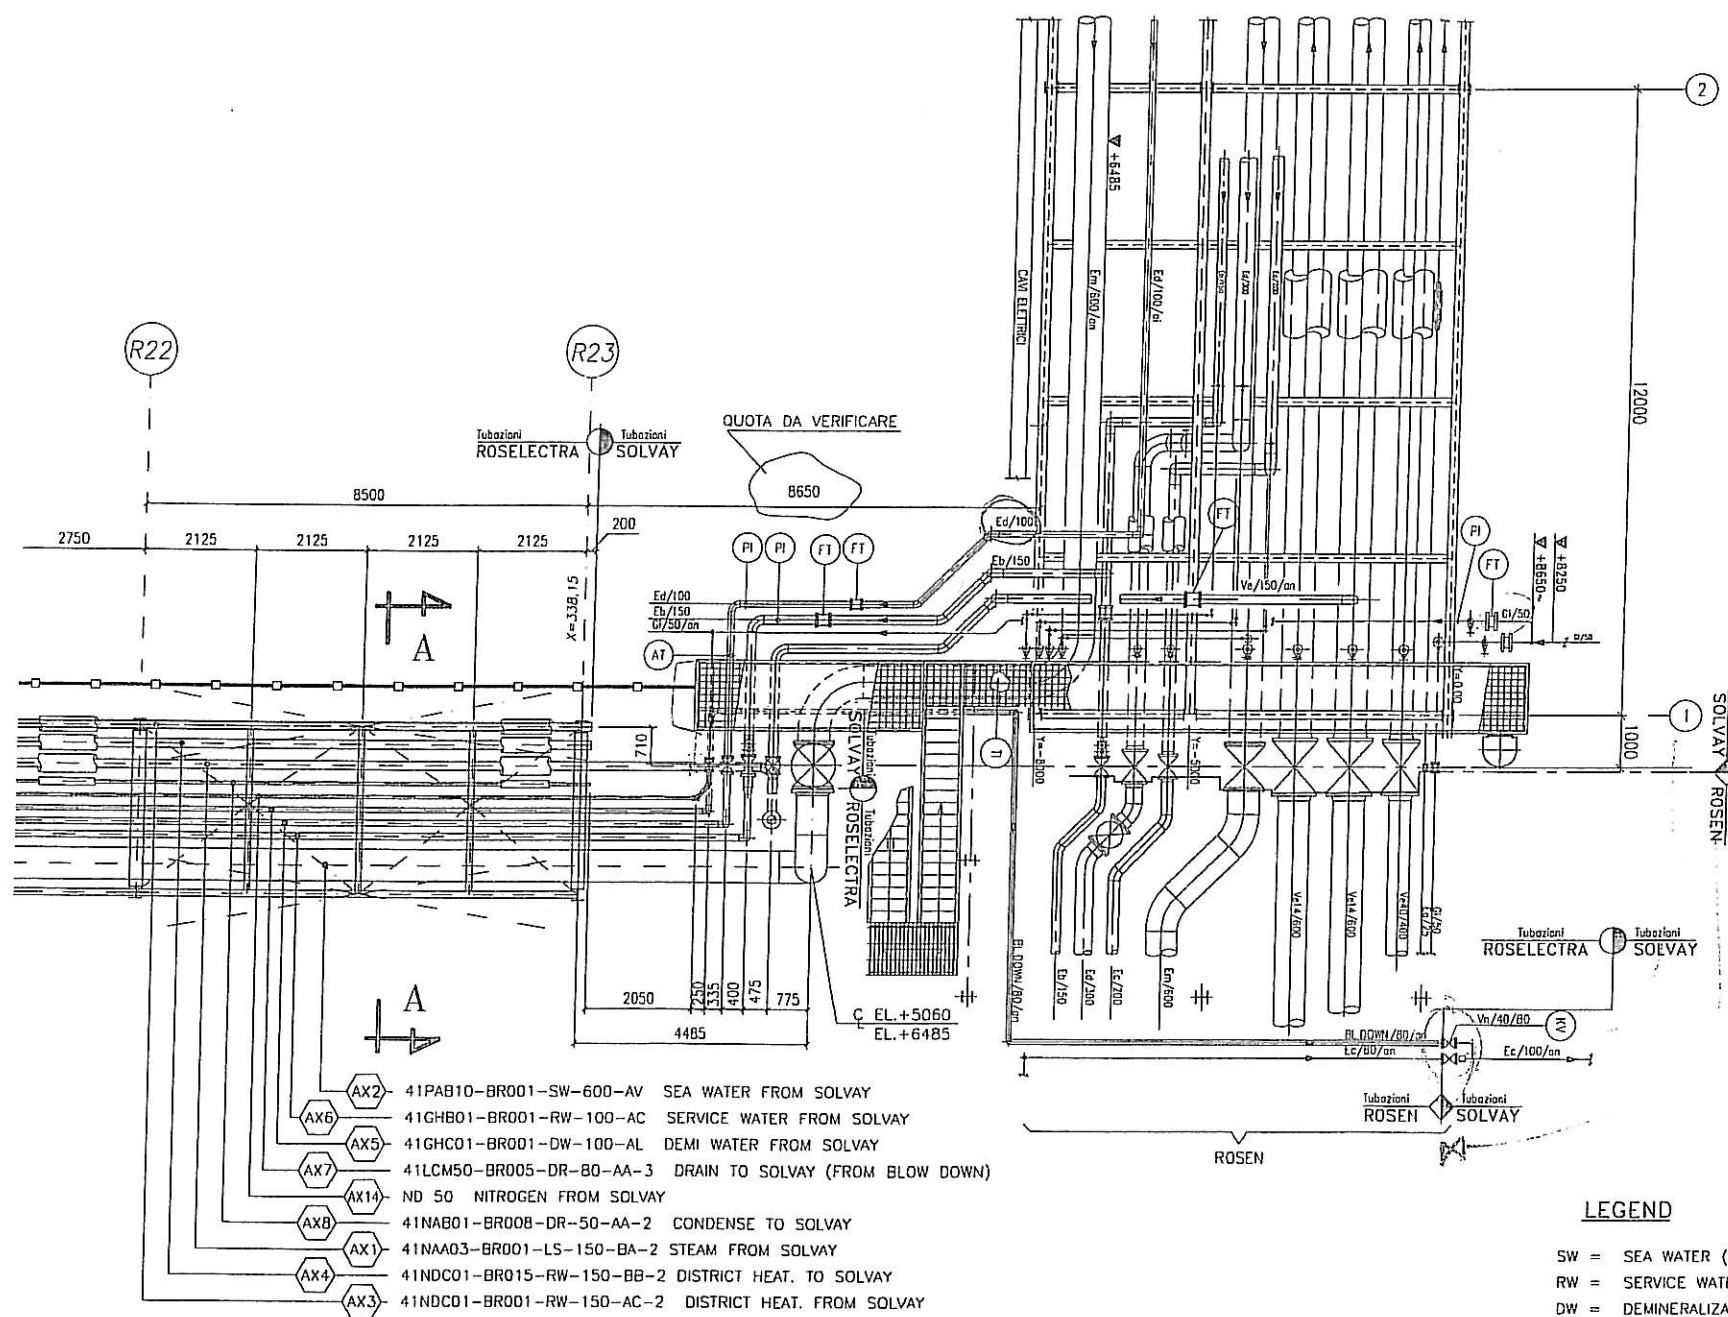

LEGEND

SW = SEA WATER (Em)
RW = SERVICE WATER (Eb)
DW = DEMINERALIZED WATER (Ed)
DR = DRAINS (BL)
LS = STEAM (Ve)
GI = NITROGEN

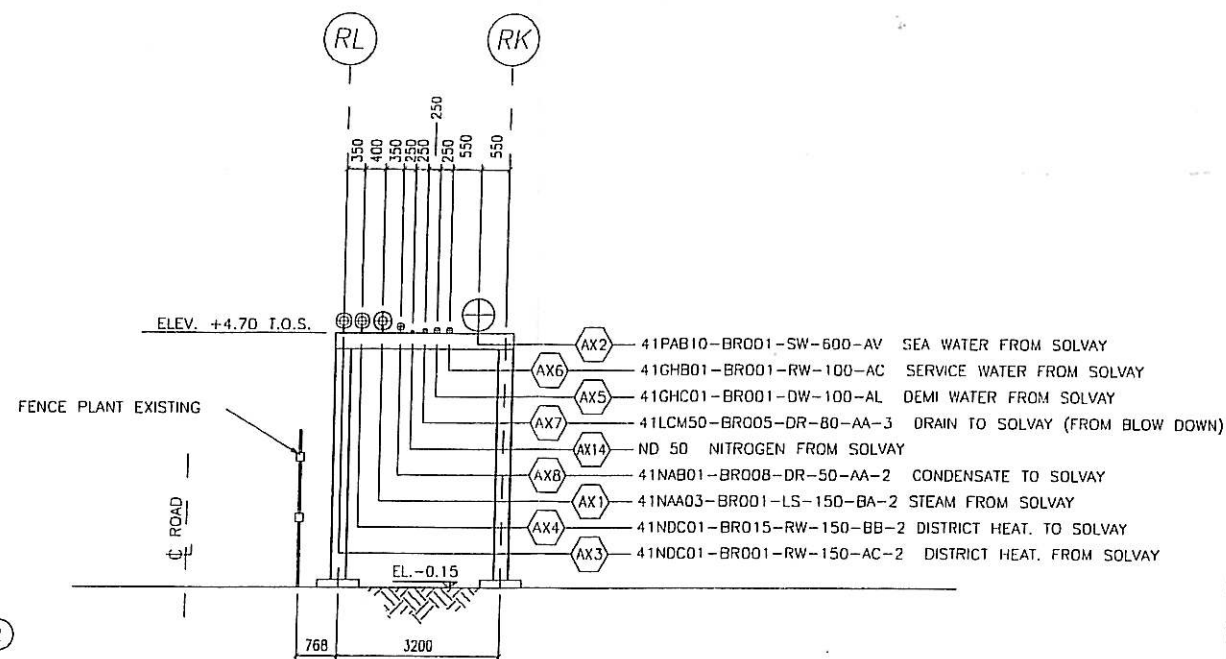

SECT. A-A

REFERENCE DRAWINGS

- R208017 rev02 - FLUIDI INTERFACCE CON ROSELECTRA
- 0249A1VVEP140 rev00 - AREA 4 - YARD - ABOVE AND UNDERGROUND PIPING LAYOUT

NOTES

- LEVEL 0.00 REFERS TO LEVEL +8.55 mt. ABOVE SEA LEVEL
- ALL DIMENSION ARE IN mm
- ALL COORDINATES ARE IN mt

INTERFACES FOR DEBRIS FILTER ON SEA WATER TO BE DEFINED ON SOLVAY DRAWINGS

00	P	I	FIRST ISSUE	BOBBIO	P.ZAMPPELLI	G.CUTARELLI	F.POLIZZA	S.BERTINI	15-12-04
Rev.	Sl.	Sc.	Descrizione	Preparato	Controllato	Verificato	Verificato	Verificato	Data
rev.	sl.	sc.	kind of revision	prepared	checked	checked	checked	checked	date
Progetto/project				ELECTRABEL s.a.					
ROSELECTRA PROJECT				ELECTRABEL s.a.					
Commissa	Emittente	Tipo doc.	Form.	Scala	Derivato da	Rev.			
job no.	issued by	doc. type	size	scale	derived from	rev.			
0249	PPS-INR-MEC	PCD	A2	1:100					
AnsaldoEnergia				TITOLO					
Una Società Finmeccanica				PIPING INTERFACES					
Ansaldo Energia s.p.a. si riserva tutti i diritti su questo documento che non può essere riprodotto neppure parzialmente senza la sua autorizzazione scritta.									
Ansaldo Energia s.p.a. reserves all rights on this document that can not be reproduced in any part without its written consent.									
Codice struttura		Identificativo/document no.		Per./rev.		Foglio		Di	
product breakdown structure				0		01		of	
		0249 A 1VVEP230							