


LEGENDA

● 67 Sorgenti sonore

ID N.	DESCRIZIONE	COORDINATA X	COORDINATA Y
01	P-208 A/B	2455074	4540162
02	TRASFORMATORI TAU 101	2455078	4540127
03	TRASFORMATORI TAU 102	2455080	4540030
04	TRASFORMATORI TAU 103	2455083	4540133
05	TRASFORMATORI TAU 104	2455085	4540136
06	X-204	2455101	4540132
07	P-209 A/B	2455112	4540125
08	X-201	2455122	4540123
09	K-201 A/B	2455130	4540120
10	E-201 A	2455107	4540109
11	E-201 B	2455110	4540113
12	E-201 C	2455112	4540105
13	E-201 D	2455115	4540110
14	E-201 E	2455116	4540102
15	E-201 F	2455119	4540106
16	E-201 G	2455121	4540098
17	E-201 H	2455123	4540102
18	P-201 A/B	2455139	4540114
19	P-207 A/B	2455144	4540110
20+21	P-206 A/B/C	2455138	4540091
22	P-203 A/B	2455130	4540095
23	P-108 A/B	2455125	4540067
24	X-101/102	2455116	4540054
25	C-102	2455114	4540076
26	P-105 A/B	2455113	4540060
27	P-106 A/B	2455117	4540065
28	C-101	2455096	4540089
29	P-103 A/B	2455096	4540073
30	P-104 A/B	2455099	4540078
31	X-103	2455089	4540069
32	X-104	2455106	4540056
33-44	E-105 A-H	2455038	4540093
45+46	P-107 A/B/C	2455056	4540107
47+48	P-101 A/B/C	2455074	4540094
49+50	P-102 A/B/C	2455067	4540085
51	P-210 A/B	2455016	4540074
52	FLOTTATORE WWT	2455011	4540073
53	DOSAGGIO REAGENTI WWT	2455022	4540064
54	TRASFORMATORE TE-101	2455066	4540034
55	TRASFORMATORE TE-102	2455083	4540021
56	TRASFORMATORE TE-103	2455049	4540047
57	TRASFORMATORE TU-101	2455070	4540041
58	TRASFORMATORE TU-102	2455088	4540028
59	GT-102	2455086	4540040
60	E-102	2455100	4540053
61	K-102	2455099	4540050
62	GT-101	2455069	4540053
63	E-101	2455082	4540063
64	K-101	2455084	4540066
65	ST-101	2455053	4540067
66	GENERATORE EMERGENZA	2455051	4540129
67	CABINA RIDUZIONE GAS	2454902	4540508
68	CALDAIA RISCALDAMENTO GAS	2454895	4540499
69	C-201	2455091	4540091
70	E-202	2455141	4540086
71	CAMINO GT-101	2455094	4540086
72	CAMINO GT-102	2455111	4540073
73	E-201 I	2455102	4540112
74	E-201 J	2455106	4540117

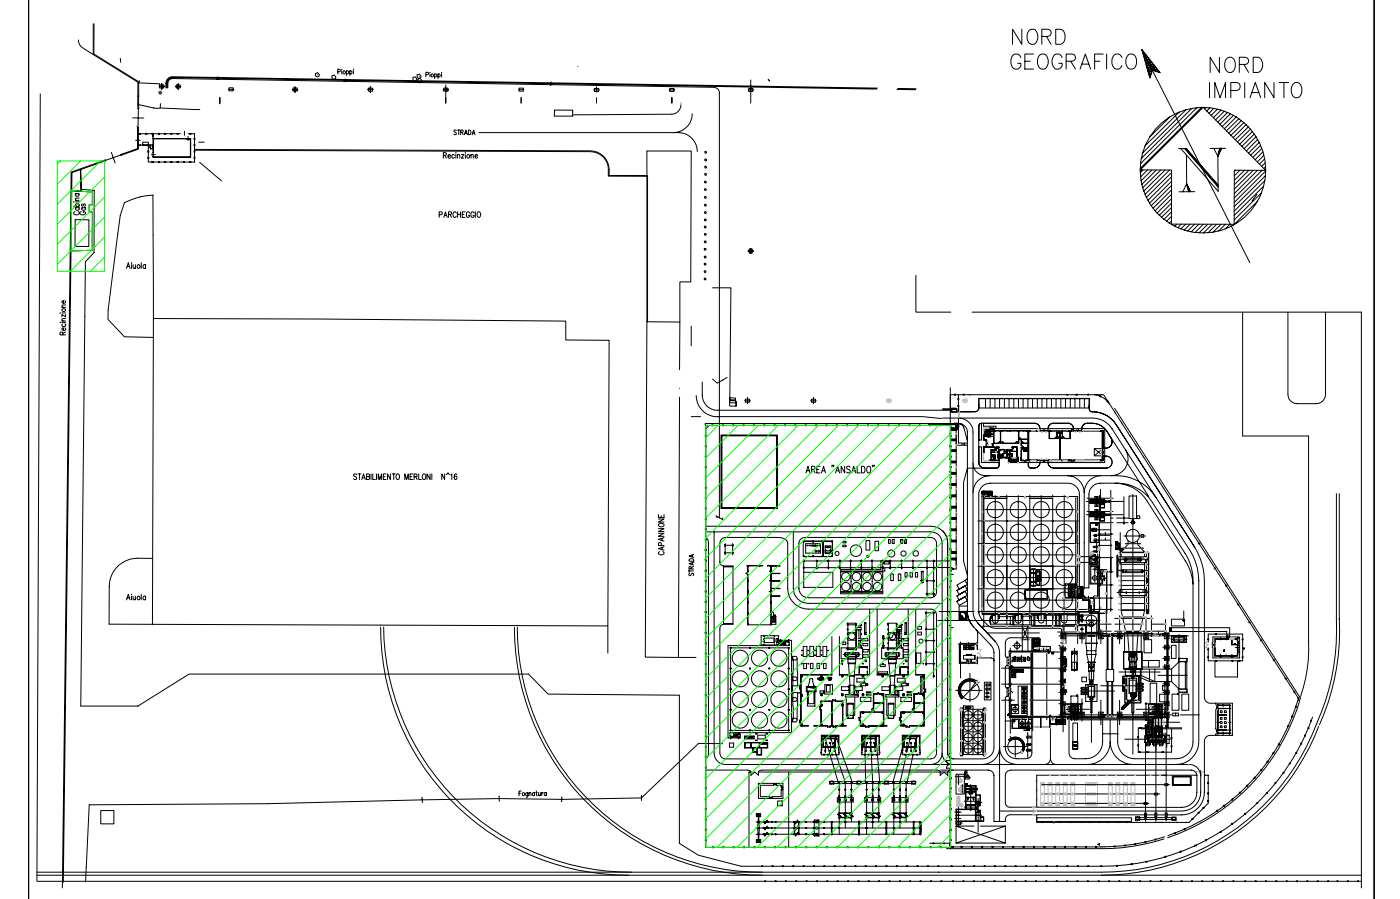

0	28/7/06	EMISSIONE FINALE	S.G.	R.M.	M.Z.
A	06/7/06	PER COMMENTI	S.G.	R.M.	M.Z.
LETTER	DATE	DESCRIPTION	BY	CHK	APP.

REVISIONS

CENTRO ENERGIA TEVEROLA
COGENERATION UNIT
TEVEROLA (CE) - ITALY -
SCHEDA C12

PLANIMETRIA MODIFICATA DELLO STABILIMENTO CON INDIVIDUAZIONE
DEI PUNTI DI ORIGINE E DELLE ZONE DI INFLUENZA DELLE SORGENTI

APPROVED FOR CONSTRUCTION

DWG. REV. DATE
SIGNATURE

ORDER N°
SUPPLIER
CONTRACT N° 1-BH-0275-A

FRAME N°
THIS DWG. SUPERSEDED BY SCALE

THIS DWG. SUPERSEDES 1:500

DWG. N° REV. 0
BH0275A-01-07-A1

FW FOSTER WHEELER ITALIANA S.P.A
ENVIRONMENTAL DIVISION

THIS DRAWING IS THE PROPERTY OF FOSTER WHEELER ITALIANA S.P.A. AND IS LENT WITHOUT CONSIDERATION OTHER THAN THE BORROWER'S AGREEMENT THAT IT SHALL NOT BE REPRODUCED, COPIED, LENT OR DISPOSED OF DIRECTLY OR INDIRECTLY, NOR USED FOR ANY PURPOSE OTHER THAN THAT FOR WHICH IT IS SPECIFICALLY FURNISHED. THE APPARATUS SHOWN IN THE DRAWING IS COVERED BY PATENTS.

File name: C12.dwg