




CAVA MATER GRATIAE
DISCARICA G3
BACINO 1



POZZO PERCOLATO

MISURATORE DI PORTATA

GAUSS BOAGA	E	2706440,434		GAUSS BOAGA	E	2706376,897
	N	4489277,473			N	4489344,176
LOCALI	E	1323,807		LOCALI	E	1232,401
	N	4093,826			N	4082,371
QUOTA slm	18.560			QUOTA slm	34.938	DATA 19/10/2017

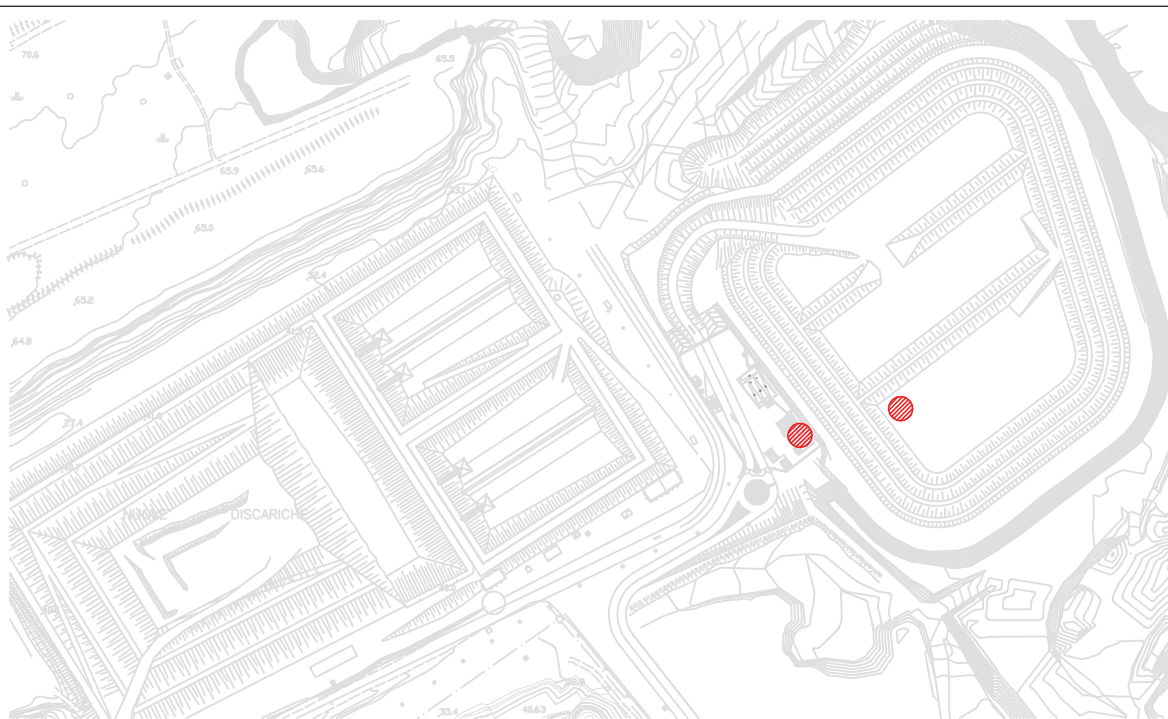



CAVA MATER GRATIAE
DISCARICA G3
BACINO 2



POZZO PERCOLATO

MISURATORE DI PORTATA

GAUSS BOAGA	E	2706461,884		GAUSS BOAGA	E	2706377.314
	N	4489357,744			N	4489347.166
LOCALI	E	1271,999		LOCALI	E	1230.132
	N	4158,784			N	4084.707
QUOTA slm	14.024			QUOTA slm	34.925	DATA 19/10/2017

