



SIDE VIEW

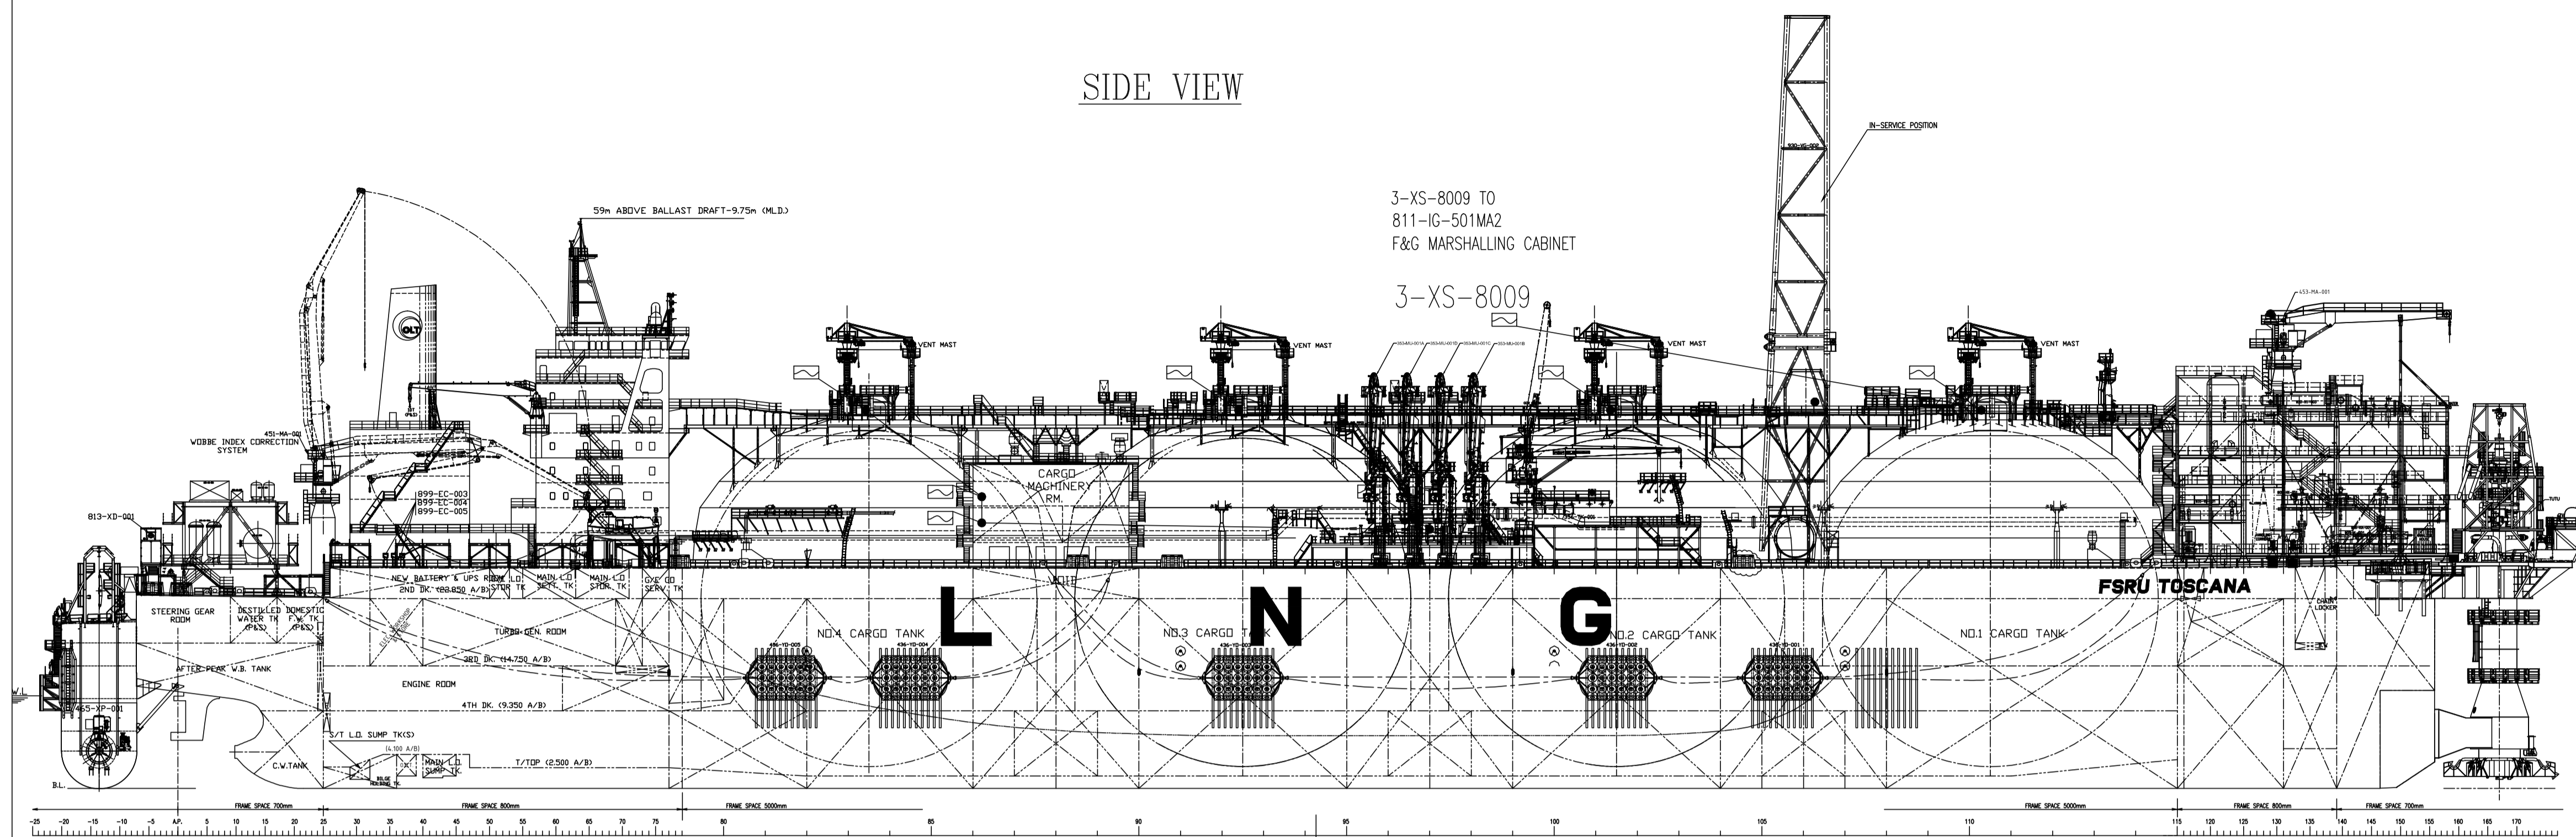

LEGEND

ITEM	SYMBOL	DESCRIPTION	REMARKS
1		FIRE THERMAL FUSE	
2		FLAME DETECTOR COMBINED ULTRA VIOLET / INFRA RED	
3		MANUAL CALL POINT W/T I.S. TYPE	
4		MANUAL OVERBOARD PUSH BUTTON	
5			
6			
7			
8			
9			
10			

UPPER DECK

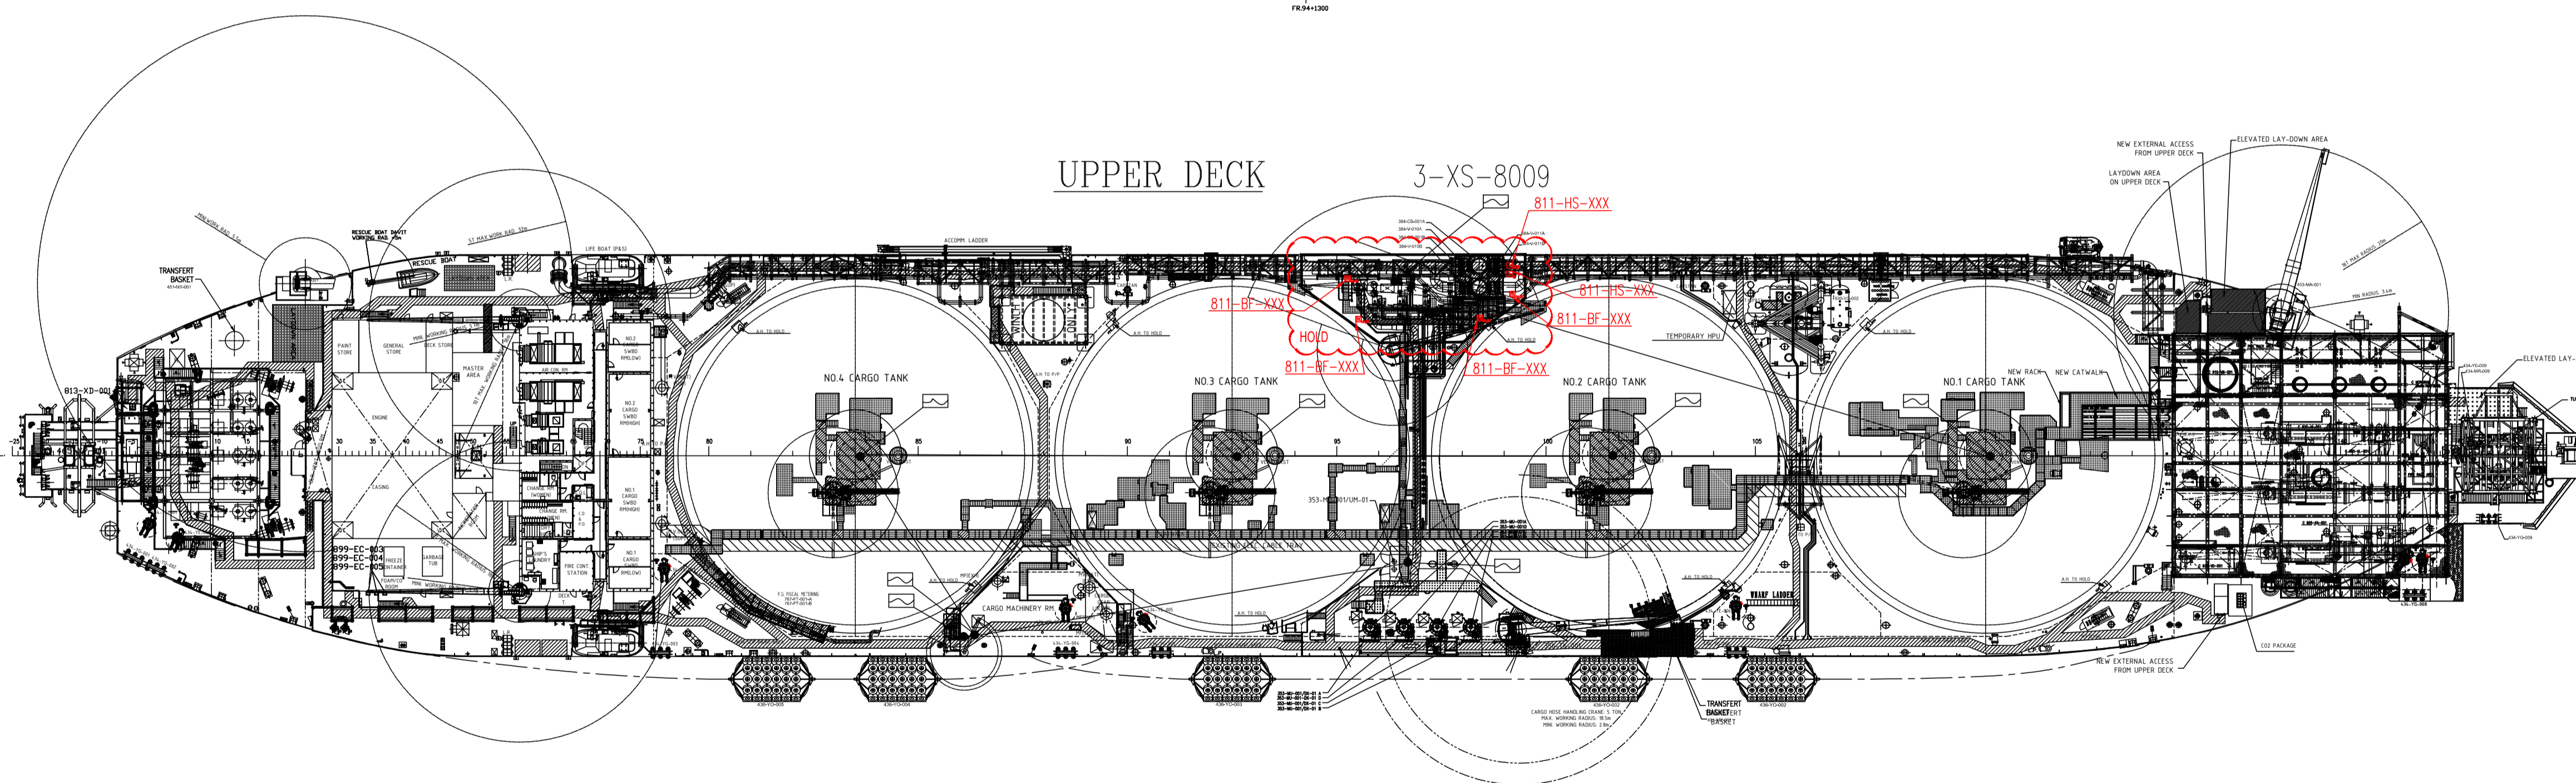

HOLD:

- LAYOUT TO BE MODIFIED AND CONFIRMED NEXT DESIGN PHASE.

Rev. No.	19/03/19	ISSUE FOR COMMENTS	ABR	MCI	LFE	
Rev. Date		Descrizione Emissione Issue Description	Preparato Prepared	Verificato Verified	Approvato Approved	Cliente Client
Cliente Customer	OLT (Offshore LNG Toscana)					
Progetto Project	FSRU Toscana					
Titolo Title	VESSEL FIRE DETECTION LAYOUT					
Disegno No. Drawing No.	TECH-033470-V00-811-ID-0001				Foglio Sheet	20 di 20
			Revisione Revision	A01	Scala Scale	Formato Size
			Sostituisce Supersedes	-		