



NOTES  
1. FOR MATERIAL SPECIFICATION & DETAILS REFER SHEET 2 OF 2

LEGEND

- CAP
- SCUPPER
- BLIND FLANGE
- NEW PIPE

REFERENCE DRAWINGS

TITLE	DRAWING NO.
MAIN DECK ZERO POLLUTION PIPING SKETCH	09-112-SEN-PS-06
HAZARDOUS DRAIN SYSTEM SCHEMATIC (SANGI I.E. INTERNATIONAL)	MMH-FAB-01

REVISION HISTORY

REV	DATE	DESCRIPTION
0	21.10.2009	APPROVED FOR CONSTRUCTION
A	15.10.2009	ISSUED FOR APPROVAL


WBS NO. BR-730 / 001

REV	DATE	DESCRIPTION	BY	CHKD./APPD.
0	21.10.2009	APPROVED FOR CONSTRUCTION	SPN	PBM MP
A	15.10.2009	ISSUED FOR APPROVAL	SPN	PBM MP

CLIENT: TRANSOCEAN  
 TITLE: KEY MANHATTAN  
 MAIN DECK ZERO POLLUTION  
 PIPING FLOW DIAGRAM



SCALE	BUILD No.	BIG CLASS	DRAWING NUMBER	SHT. No.	REV.
NTS			09-112-SEN-PHFD-006	1	0

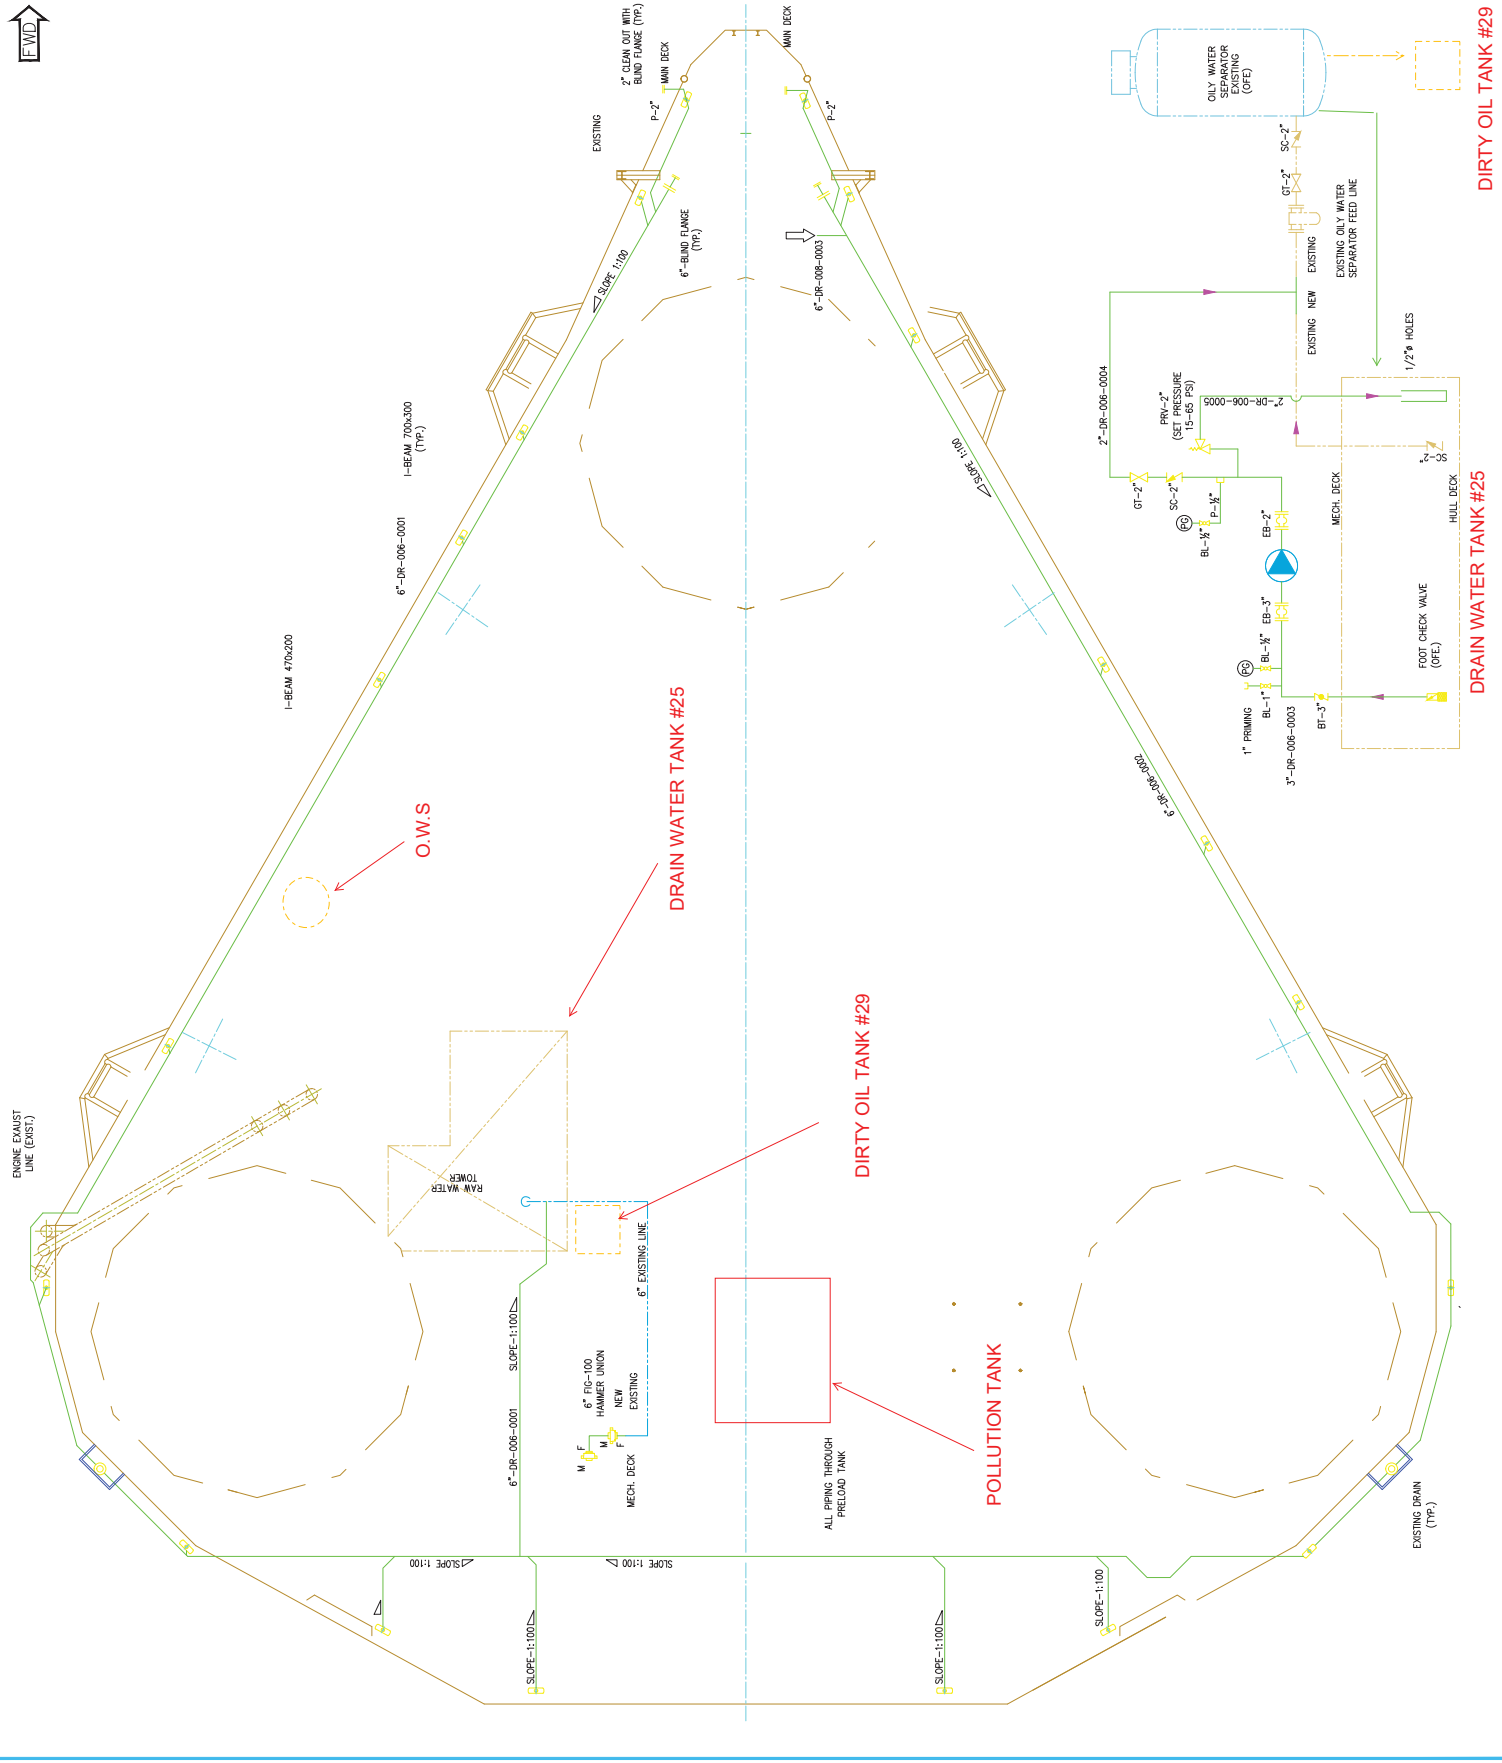

DIRTY OIL TANK #29

DRAIN WATER TANK #25

POLLUTION TANK

EXISTING DRAIN (TYP.)