

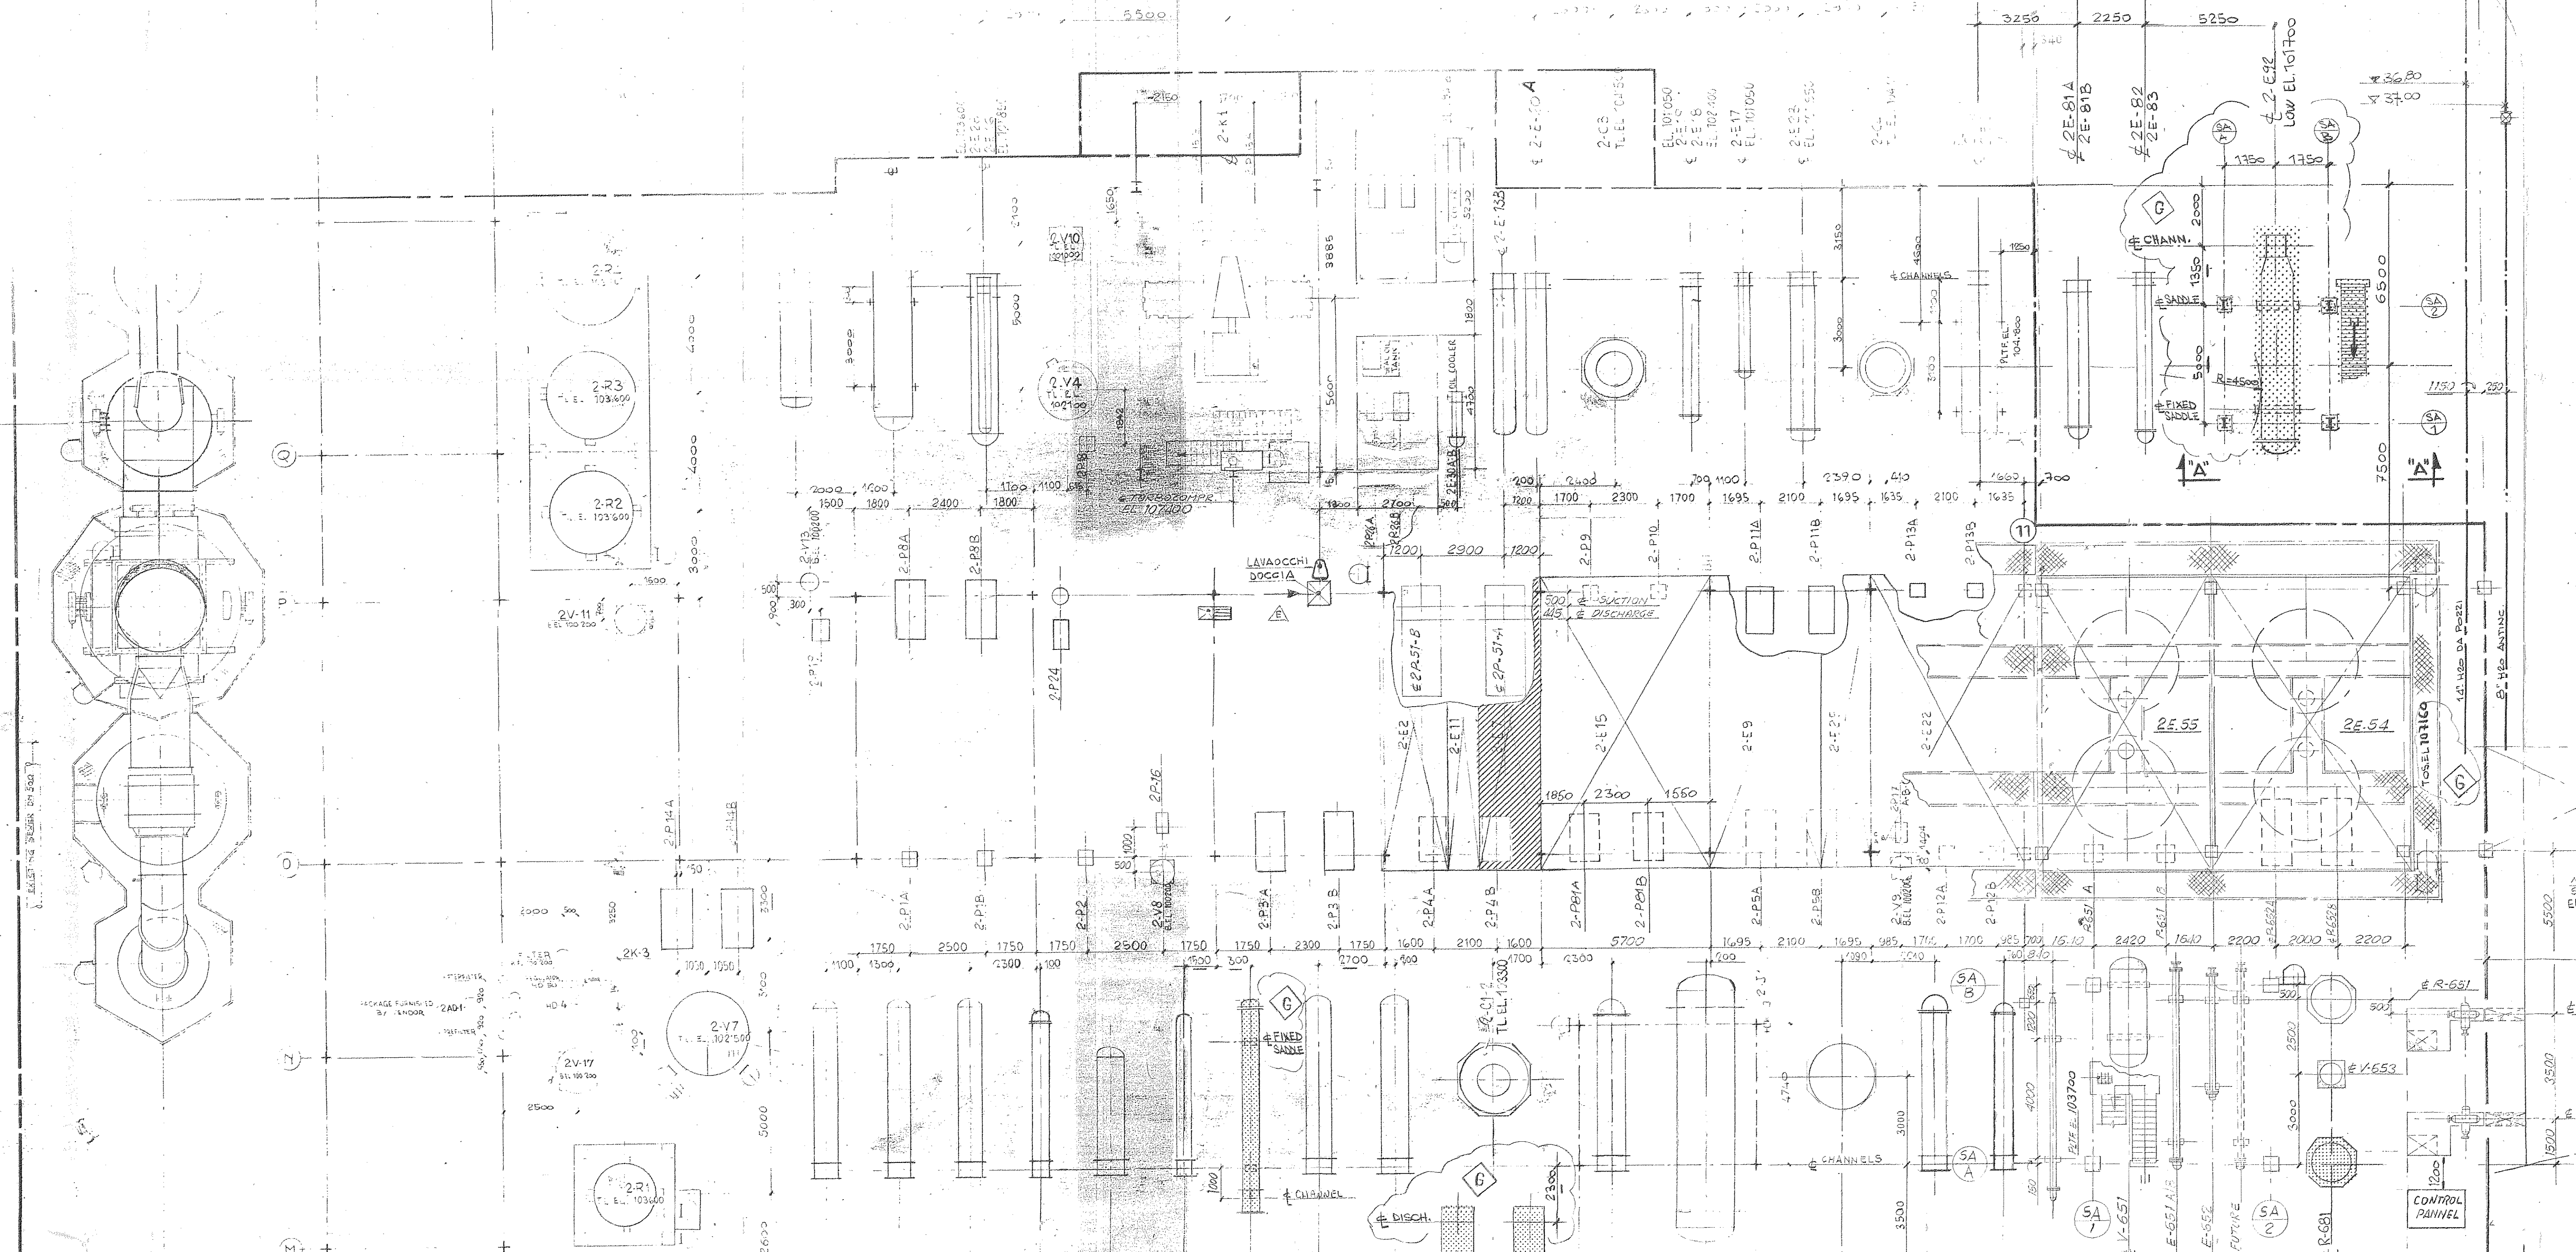
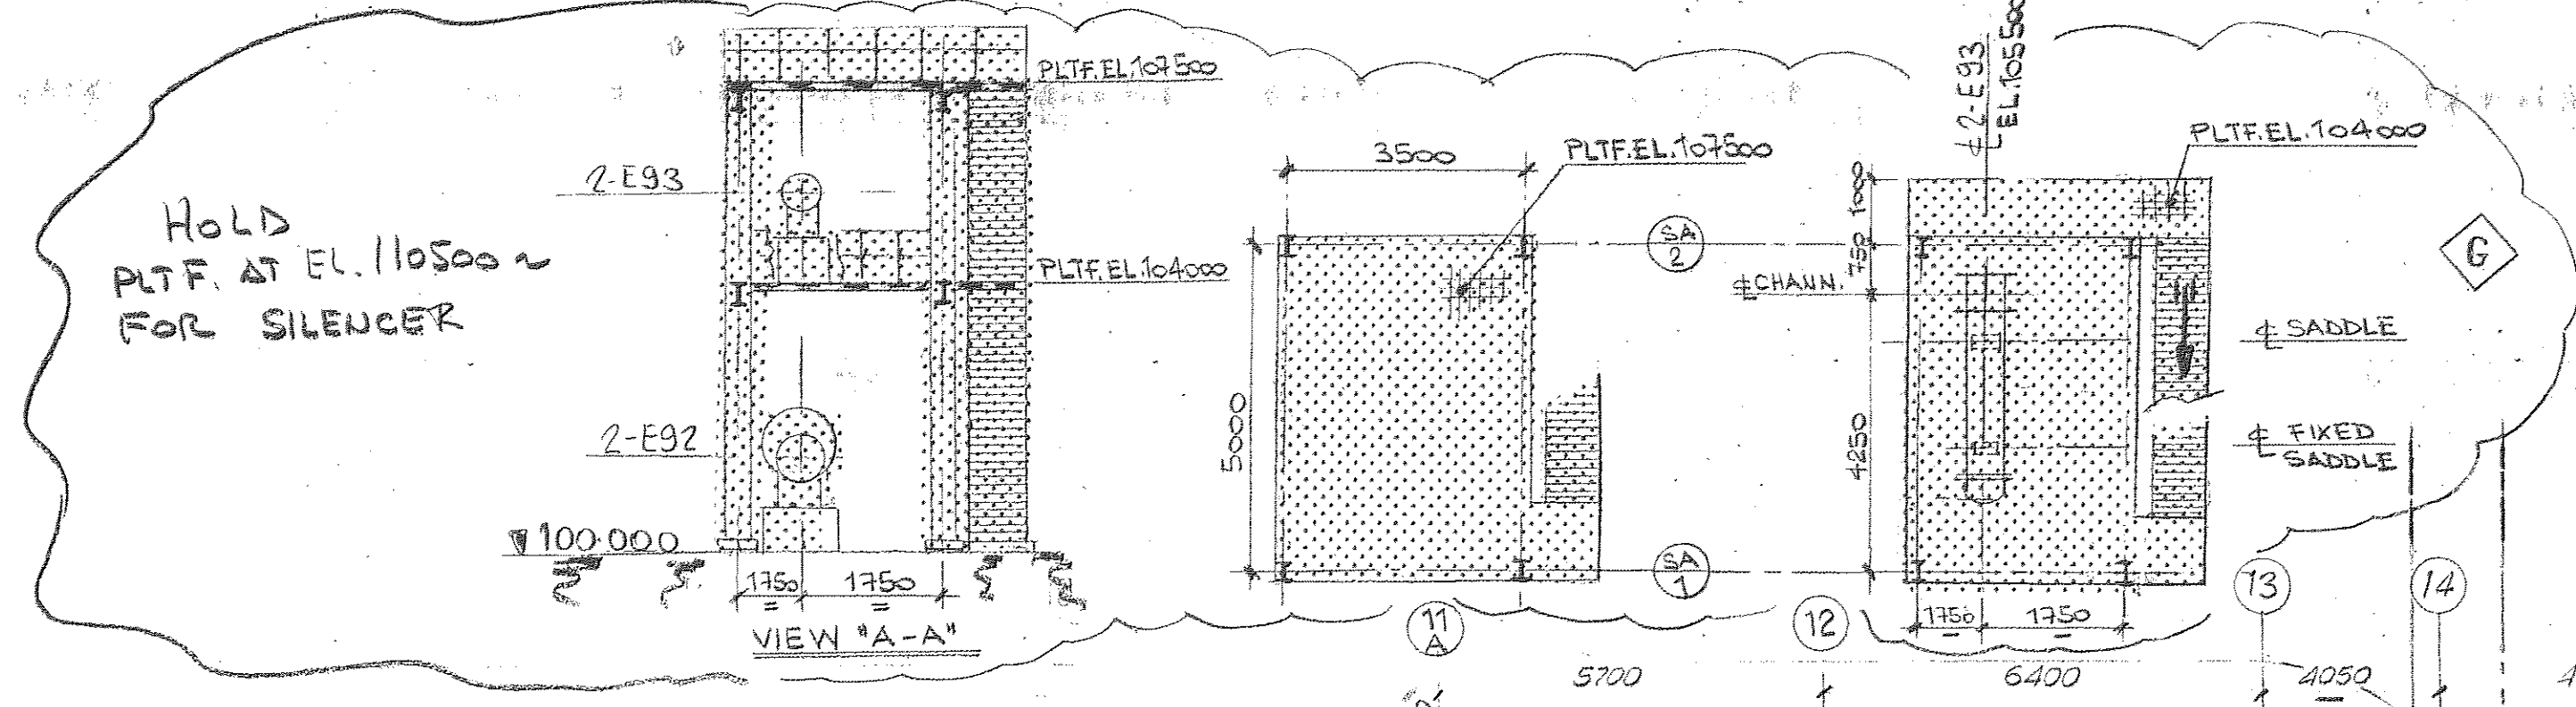


0203B - 2-0 - 01-1

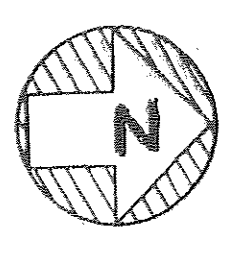

DESCRIPTION	ELEVATION
SEPARATORE AD ALTA PRESSIONE	101800
SEPARATORE A BASSA PRESSIONE	101800
REATTORE	101800
ALTERNATORE DELL'EFFLUENTE	101750
INTERESSATORE FINALE DELL'EFFLUENTE	101750
POMPA PRODOTTO TRATTATO	100200 T.O.C.
COMPRESSORI DI CARICATA	101300
COMPRESSORI DI RICICLO	101300
REATTORI	101800

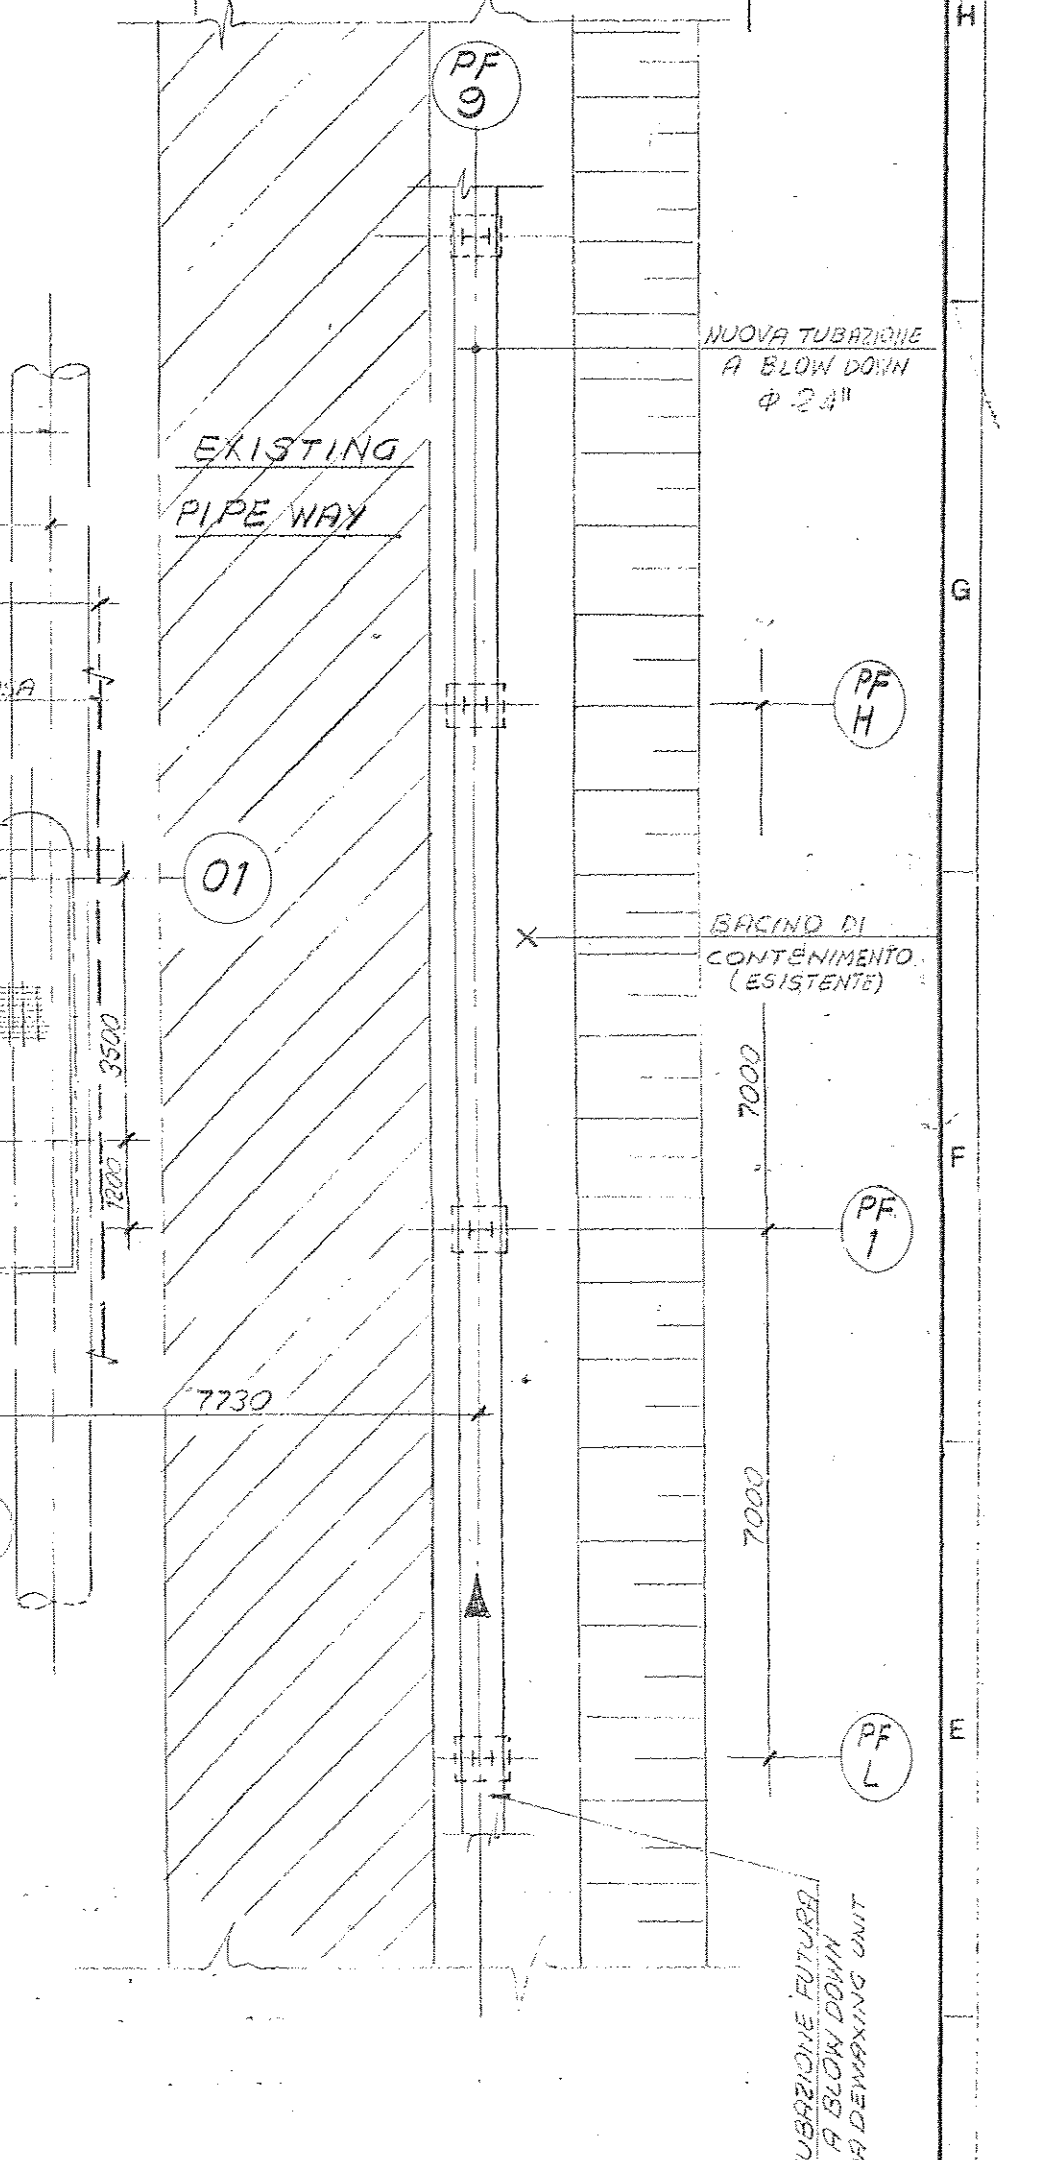

ITEM N°	SERVICE	ELEVATION
2-C1-2	ULTRAFORMER STRIPPER	EL. 103300
2-E-12	KEROSENE PRODUCT TRIM COOLER (COLOCATO)	EL. 103200
2-E15-D	BETHANIZER REFINER (EX COOL ULTRAF. CHANGE)	EL. 102200
2-E8	2-E8	EL. 102212
2-E51	REACTOR EFFLUENT/RECYCLE GAS	EL. 102100
2-E52	1 ST EFFLUENT COOLER	EL. 101900
2-E53	STABILIZER STM TRIM COOLER	EL. 101700
2-E54	ULTRAFINER EFFLUENT AIR CONDENSER	EL. 101710
2-E55	EFFLUENT AIR CONDENSER	EL. 101710
2-E56	ULTRAFINER EFFLUENT AIR CONDENSER	EL. 101500
2-E57	ULTRAFINER EFFLUENT AIR CONDENSER	EL. 101500
G	15-04	REVISED WHERE INDICATED CONTR. N° 1-10-0233
F	23-10	ISSUE FOR CONSTRUCTION - CONTR. N° 1-10-0233
D	23-09	EMESSO PER COSTRUZIONE
C	12-09	EMESSO PER COSTRUZIONE
B	30-08	EMESSO PER APPLICAZIONE MECCANICA
A	02-08	INSERITI COMMENTI CLIENTE
	15-06	DESEGNATO COORDINATORE (G.C.E. ALTA OTTANICA)

APPROVED FOR CONSTRUCTION

ULTRAFORMER 2-UNITA' 2 - DIENI UNITA' 600

REFINERY UPGRADING PROJECT
TAMOL - RAFFINERIA DICREMONA

CREMONA ITALIA

FOSTER WHEELER ITALIANA
COMPAGNIA TECNICA INTERNAZIONALE

TECHINT
COMPAGNIA TECNICA INTERNAZIONALE

AMOCO ITALIA S.p.A.
CREMONA ITALY

ULTRAFORMER N.2

PLOT PLAN






