




REFERENCE DRAWINGS								
TITOLO	JZH N°	VERSALIS N°						
PIPING AND INSTR. DIAGRAM (P&I)	1789-100	BRINVEETBFM20300						
CARICHI SULLE FONDAZIONI	1789-102	BRINVEETBADB20310						
CABLE ROUTING 	1789-143	BRINVEETDIDL20398						
PIPING LAYOUT 	1789-310	BRINVEETBLDL20435						
DETTAGLI PIPING 	1789-311	BRINVEETBLDL20436						
SKETCH ISOMETRICI PIPING	1789-312	BRINVEETBLDQ20438						
DETTAGLI SUPPORTI PIPING	1789-313	BRINVEETBLDQ20439						
DETTAGLI CAMERA DI COMBUSTIONE	1789-430	BRINVEETBJDC20494						
DETTAGLI STAGING SKID DIS.	1789-440	BRINVEETBJDC20495						
PROCEDURA DI MONTAGGIO	1789-820	BRINVEETBJPC20446						
NOTE								
1) CERTIFICATI MATERIALI IN ACCORDO CON EN 10204-3.1								
2) TUTTE LE SALDATURE DEVONO ESSERE A PIENA PENETRAZIONE DOVE POSSIBILE TUTTE LE ALTRE SALDATURE CONTINUE DEVONO AVERE UN CORDONE UGUALE AI 7/10 DELLO SPESSORE MINIMO DA SALDARE MA NON INFERIORE A 6mm (SE NON DIVERSAMENTE INDICATO).								
3) SALDATURE TUBAZIONI IN ACCORDO CON EN / ASME B 31.3 SALDATURE STRUTTURALI IN ACCORDO CON EN-15614-1								
4) TUTTI I FORI DELLE FLANGE SONO A CAVALLO DEGLI ASSI								
5) GLI SPESSORI INDICATI SUL DISEGNO SONO NOMINALI								
GENERAL DESIGN DATA								
INSTALLAZIONE: ESTERNO								
NAZIONE: ITALIA								
LUOGO: BRINDISI								
AREA: ZONA 2 IIC T4								
CONDIZIONI AMBIENTALI: NTC 2018								
AZIONI VENTO: NTC 2018								
AZIONI SISMA: NTC 2018								
STRUTTURE IN CALCESTRUZZO: EN 1992-1-1:2015								
STRUTTURE IN ACCIAIO: EN 1993-1-1:2005								
DATI VERNICIATURA								
IN ACCORDO ALLA SPECIFICA N° 20000.ENG.CPI.STD Rev. 05 E MANUALE DELLE VERINICIATURE 								
CONTROLLI								
TUTTI I CONTROLLI SONO IN ACCORDO AL MANUALE CONTROLLO QUALITA' JZH								
MATERIALI								
PROFILATI : S275 J2-S355 J2								
LAMIERE: S275 J2 - S355 J2								
BULLONI: VITE IN 8.8 DADO IN CLASSE 8 ROSETTA IN HV100 								
SPECIFICHE DI PROGETTO								
BRINP1BPRB90000_CDFE00_23 DATI BASE PER LA PROGETTAZIONE BEED								
BRINP1FAST20011_CDFE00_07 TECHNICAL SPECIFICATION FOR ANCHOR BOLTS								
OPL_018_PE_SPAINDU_R01 PROGETTAZIONE STRUTTURALE COSTRUZIONI CA E ACCIAIO								
28820.ENG.CIV.DWG ANCHOR BOLTS								
28816E00 CIVIL WORKS AND STANDARDS GENERAL NOTES								
PIPING AL LIMITE DI FORNITURA								
N° L.B.	Ø	DESCRIZIONE	SERVIZIO					
24	6"	INGRESSO LINEA VAPORE A MEDIA PRESSIONE	LINEA VAPORE MEDIA PRESSIONE					
25	4"	INGRESSO LINEA AZOTO	LINEA AZOTO PER POST PURGA					
26	30"	INGRESSO LINEA GAS DI TORCIA	COLLETTORE GAS DI TORCIA VERSO TORCIA A TERRA A VALLE DEL KO DRUM V-9101					
27	3"	INGRESSO LINEA FUEL GAS DI ASSISTENZA	LINEA FUEL GAS					
28	TBA	INGRESSO LINEA ACQUA ANTINCENDIO (ACQUA DI MARE)	LINEA ACQUA ANTINCENDIO PER SISTEMA FIRE & GAS					
29	3/4"	INGRESSO LINEA ARIA STRUMENTALE	LINEA ARIA STRUMENTALE PER LO SKID					
INDEX								
EX-DE	00	19/01/2020	Revised where indicated	NESPOLI				
CD-FE	03	04/06/2019	Revised where indicated	NESPOLI				
CD-FE	02	18/04/2019	Revised where indicated	NESPOLI				
CD-FE	01	18/01/2019	Issued for Comment	NESPOLI				
Validity	Revision	Date	Description	Vendor	Contractor	Contractor	Company	Company
Status	Member			Approved	Verified	Approved	Checked	Approved
Index	Revision							
Company Logo and Business Name				Project Name		Company Document ID:		
 Versalis S.p.A.				VERSALIS BRINDISI Nuova Torcia a Terra		Job N. 655046021 BRINVEETBADG20305		
Contractor Logo and Business Name						Contractor Document ID:		
 Eni progetti						Job N.		
Vendor Logo and Business Name						Vendor Document ID:		
 John Zink Hamworthy Combustion S.r.l.						Contract N. 3500047624		
Facility and Sub Facility Name						Sheet of Sheets		
BRIN-P1CR						1/75 1/10		
Document Title					Superseded by N.			
ASSIEME GENERALE-PIANTA					Superseded by N.			
					Plant Area		Unit	
					P1CR		91	
Software: Autocad								
File Name: Vendor Document Rev 00.dwg								






REFERENCE DRAWINGS

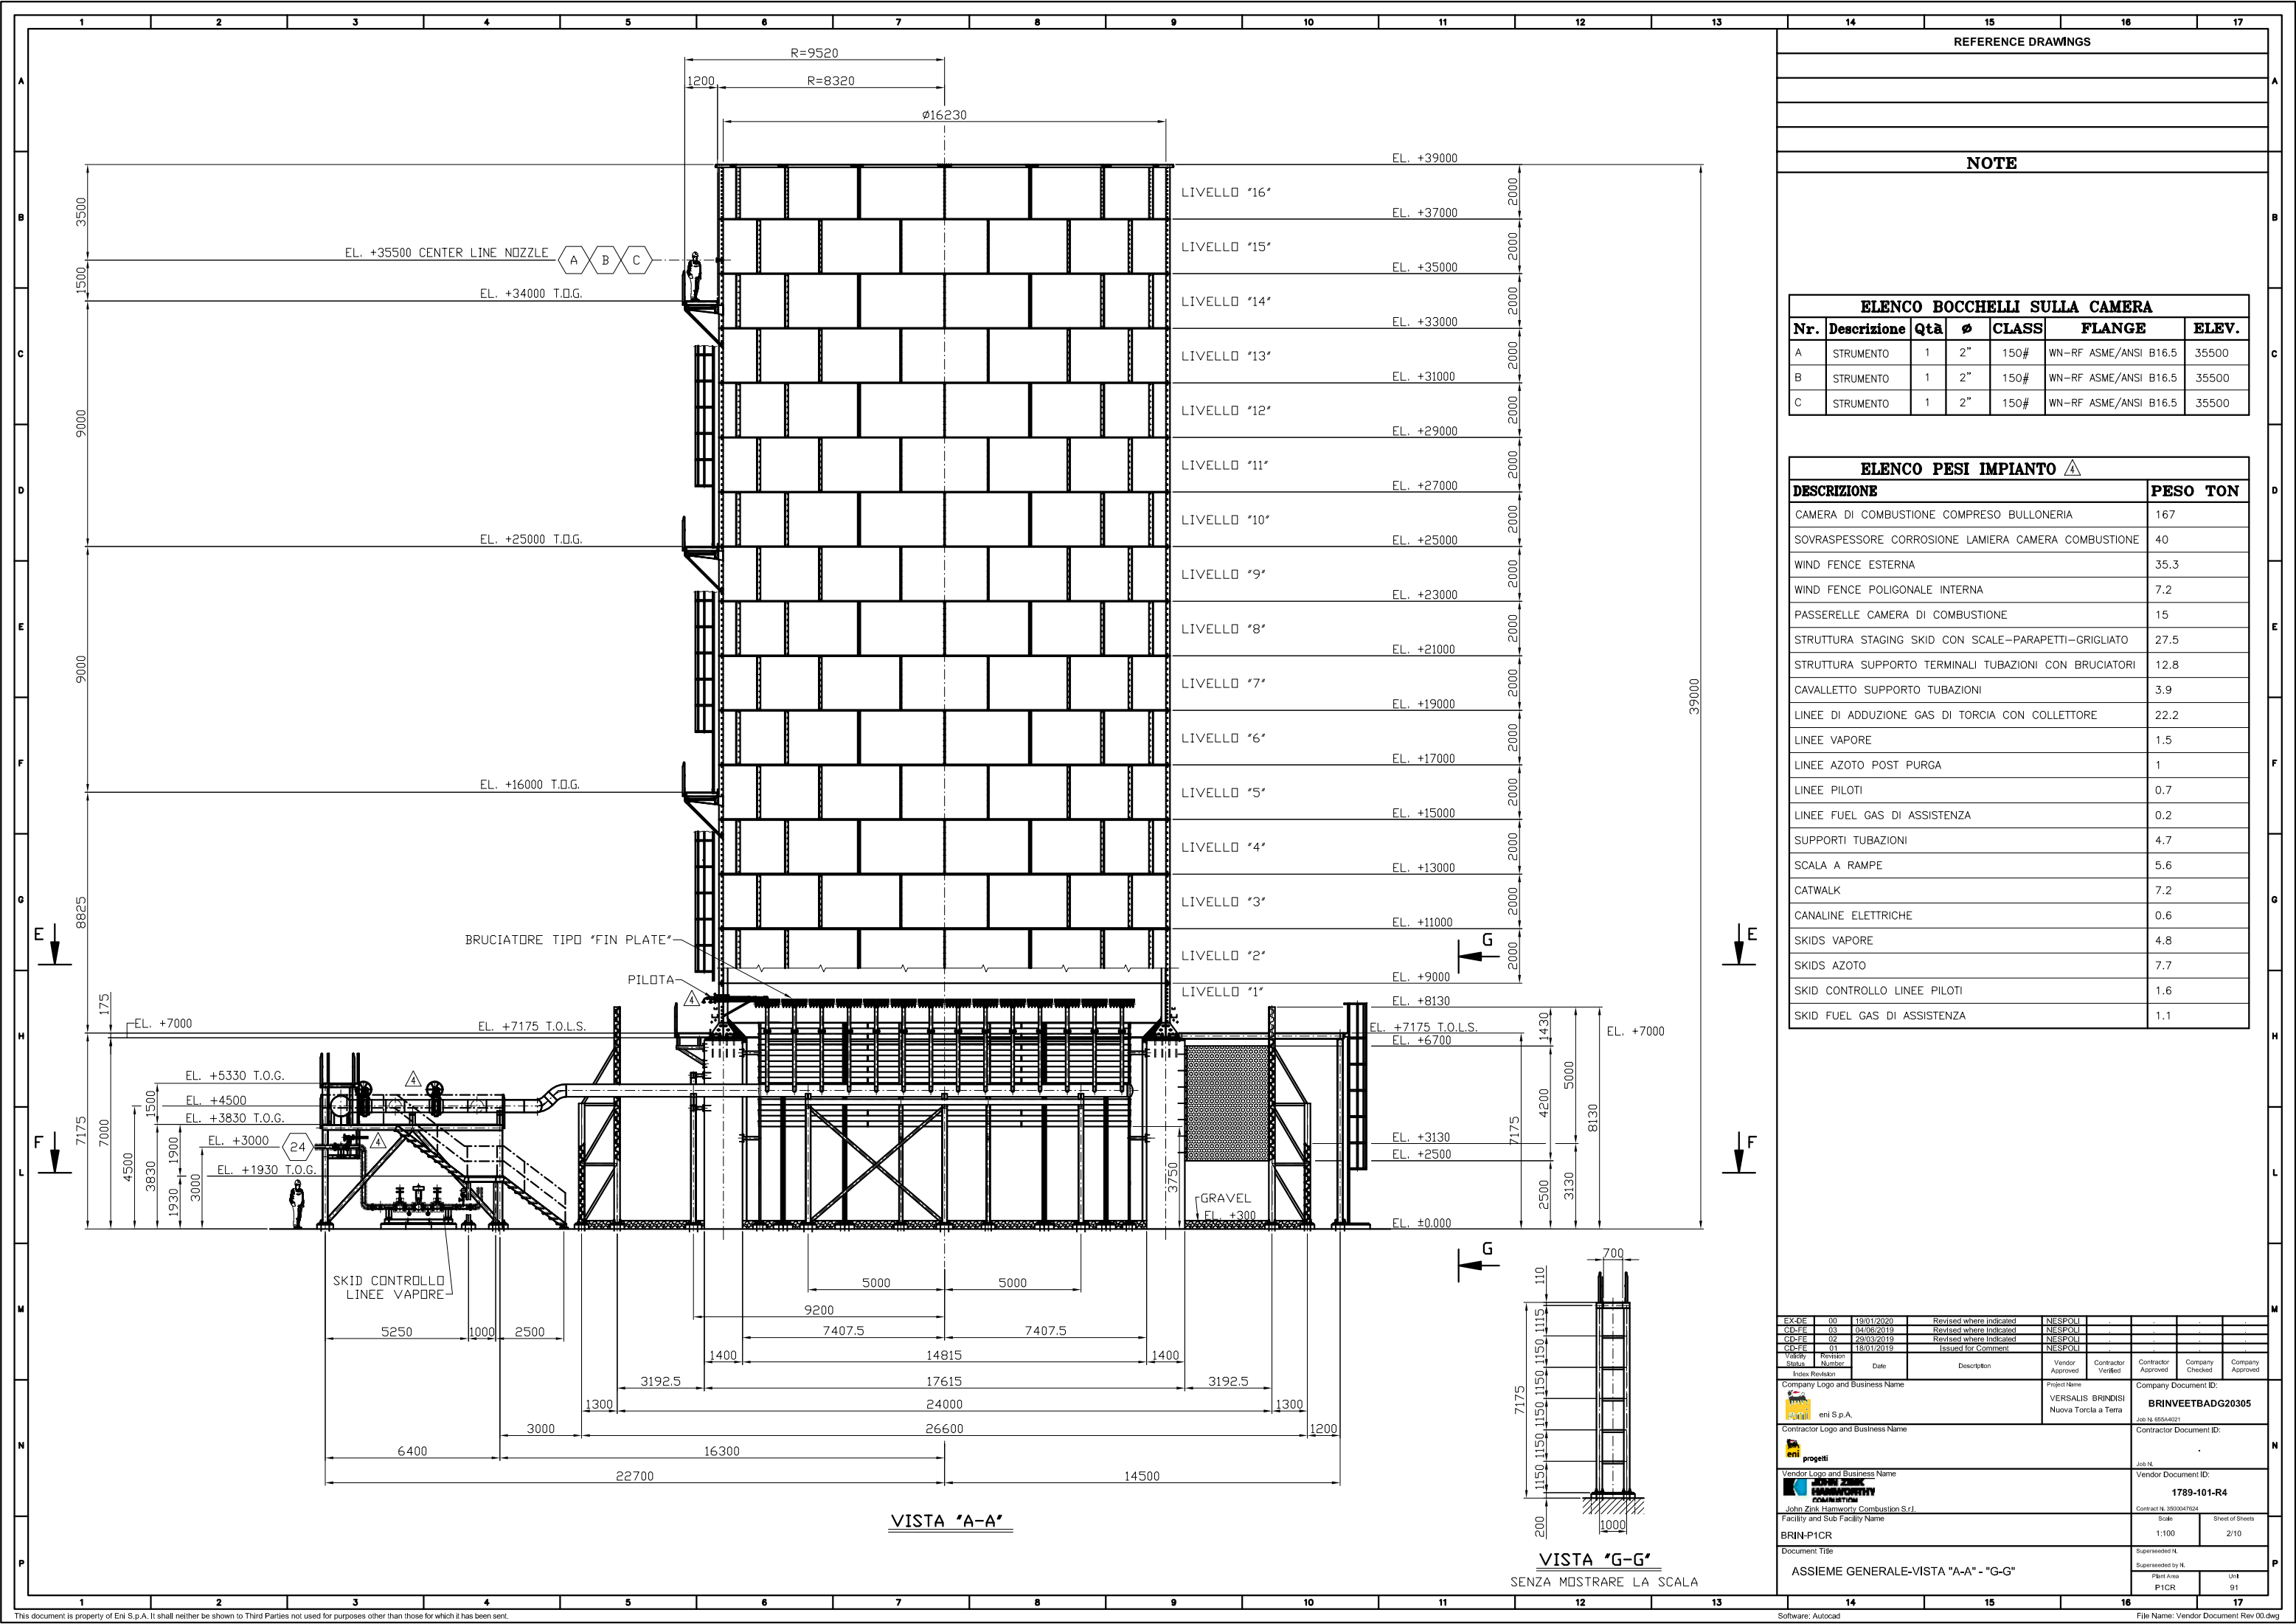
NOTE

ELENCO BOCCELLI SULLA CAMERA						
Nr.	Descrizione	Qtà	Ø	CLASS	FLANGE	ELEV.
A	STRUMENTO	1	2"	150#	WN-RF ASME/ANSI B16.5	35500
B	STRUMENTO	1	2"	150#	WN-RF ASME/ANSI B16.5	35500
C	STRUMENTO	1	2"	150#	WN-RF ASME/ANSI B16.5	35500


ELENCO PESI IMPIANTO ⚠	
DESCRIZIONE	PESO TON
CAMERA DI COMBUSTIONE COMPRESO BULLONERIA	167
SOVRASPESORE CORROSIONE LAMIERA CAMERA COMBUSTIONE	40
WIND FENCE ESTERNA	35.3
WIND FENCE POLIGONALE INTERNA	7.2
PASSERELLE CAMERA DI COMBUSTIONE	15
STRUTTURA STAGING SKID CON SCALE-PARAPETTI-GRIGLIATO	27.5
STRUTTURA SUPPORTO TERMINALI TUBAZIONI CON BRUCIATORI	12.8
CAVALLETTO SUPPORTO TUBAZIONI	3.9
LINEE DI ADDUZIONE GAS DI TORCIA CON COLLETTORE	22.2
LINEE VAPORE	1.5
LINEE AZOTO POST PURGA	1
LINEE PILOTI	0.7
LINEE FUEL GAS DI ASSISTENZA	0.2
SUPPORTI TUBAZIONI	4.7
SCALA A RAMPE	5.6
CATWALK	7.2
CANALINE ELETTRICHE	0.6
SKIDS VAPORE	4.8
SKIDS AZOTO	7.7
SKID CONTROLLO LINEE PILOTI	1.6
SKID FUEL GAS DI ASSISTENZA	1.1

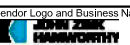


EX-DE	00	19/01/2020	Revised where indicated	NESPOLI	-	-	-	-	-
CD-FE	03	04/06/2019	Revised where indicated	NESPOLI	-	-	-	-	-
CD-FE	02	29/03/2019	Revised where indicated	NESPOLI	-	-	-	-	-
CD-FE	01	18/01/2019	Issued for Comment	NESPOLI	-	-	-	-	-
Validity Status	Revision Number	Date	Description	Vendor Approved	Contractor Verified	Contractor Approved	Company Checked	Company Approved	
Index Revision									
Company Logo and Business Name				Project Name		Company Document ID:			
 eni S.p.A.				VERSALIS BRINDISI Nuova Torcia a Terra		BRINVEETBADG20305			
Contractor Logo and Business Name				Contractor Document ID:		Job N. 8554-6023			
 progetti				Job N.		Contractor Document ID:			
Vendor Logo and Business Name				Vendor Document ID:		Job N.			
 JOHN ZINK HAMWORTHY COMBUSTION				Contract N. 3500047624		1789-101-R4			
Facility and Sub Facility Name				Scale		Sheet of Sheets			
BRIN-P1CR				1:100		2/10			
Document Title				Supervised by N.		Plant Area			
ASSIEME GENERALE-VISTA "A-A" - "G-G"				P1CR		Unit			
						91			

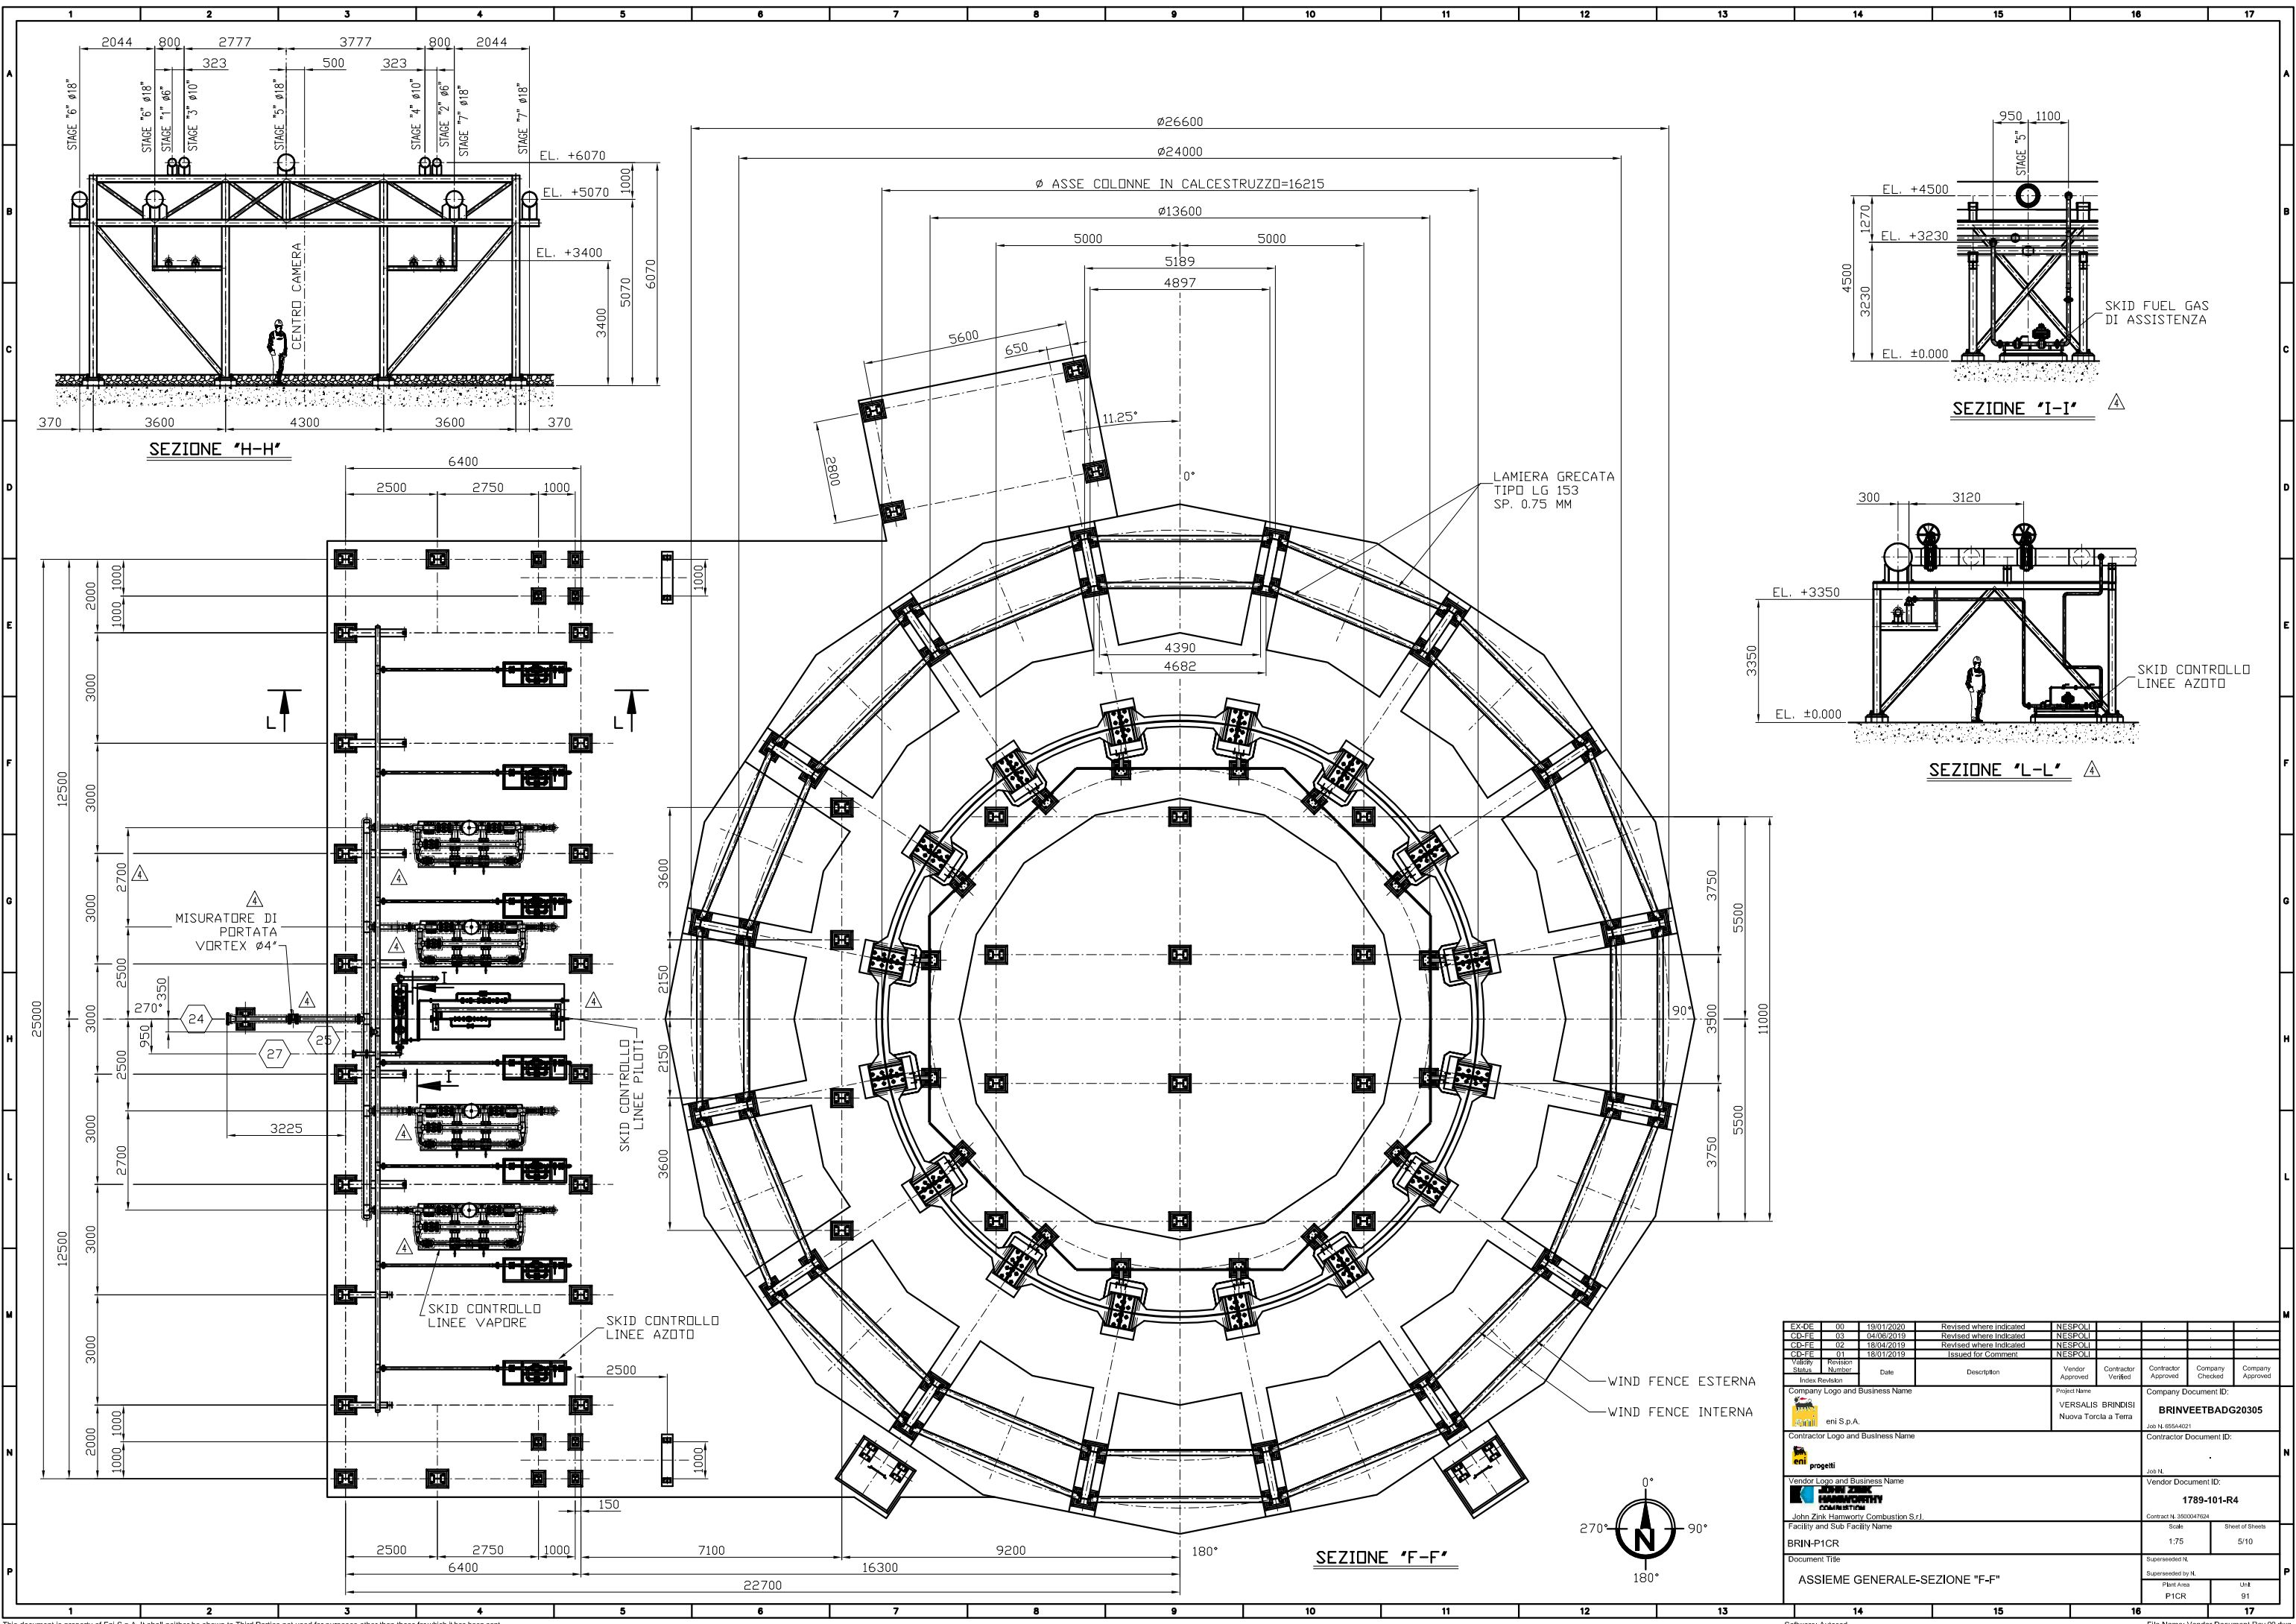


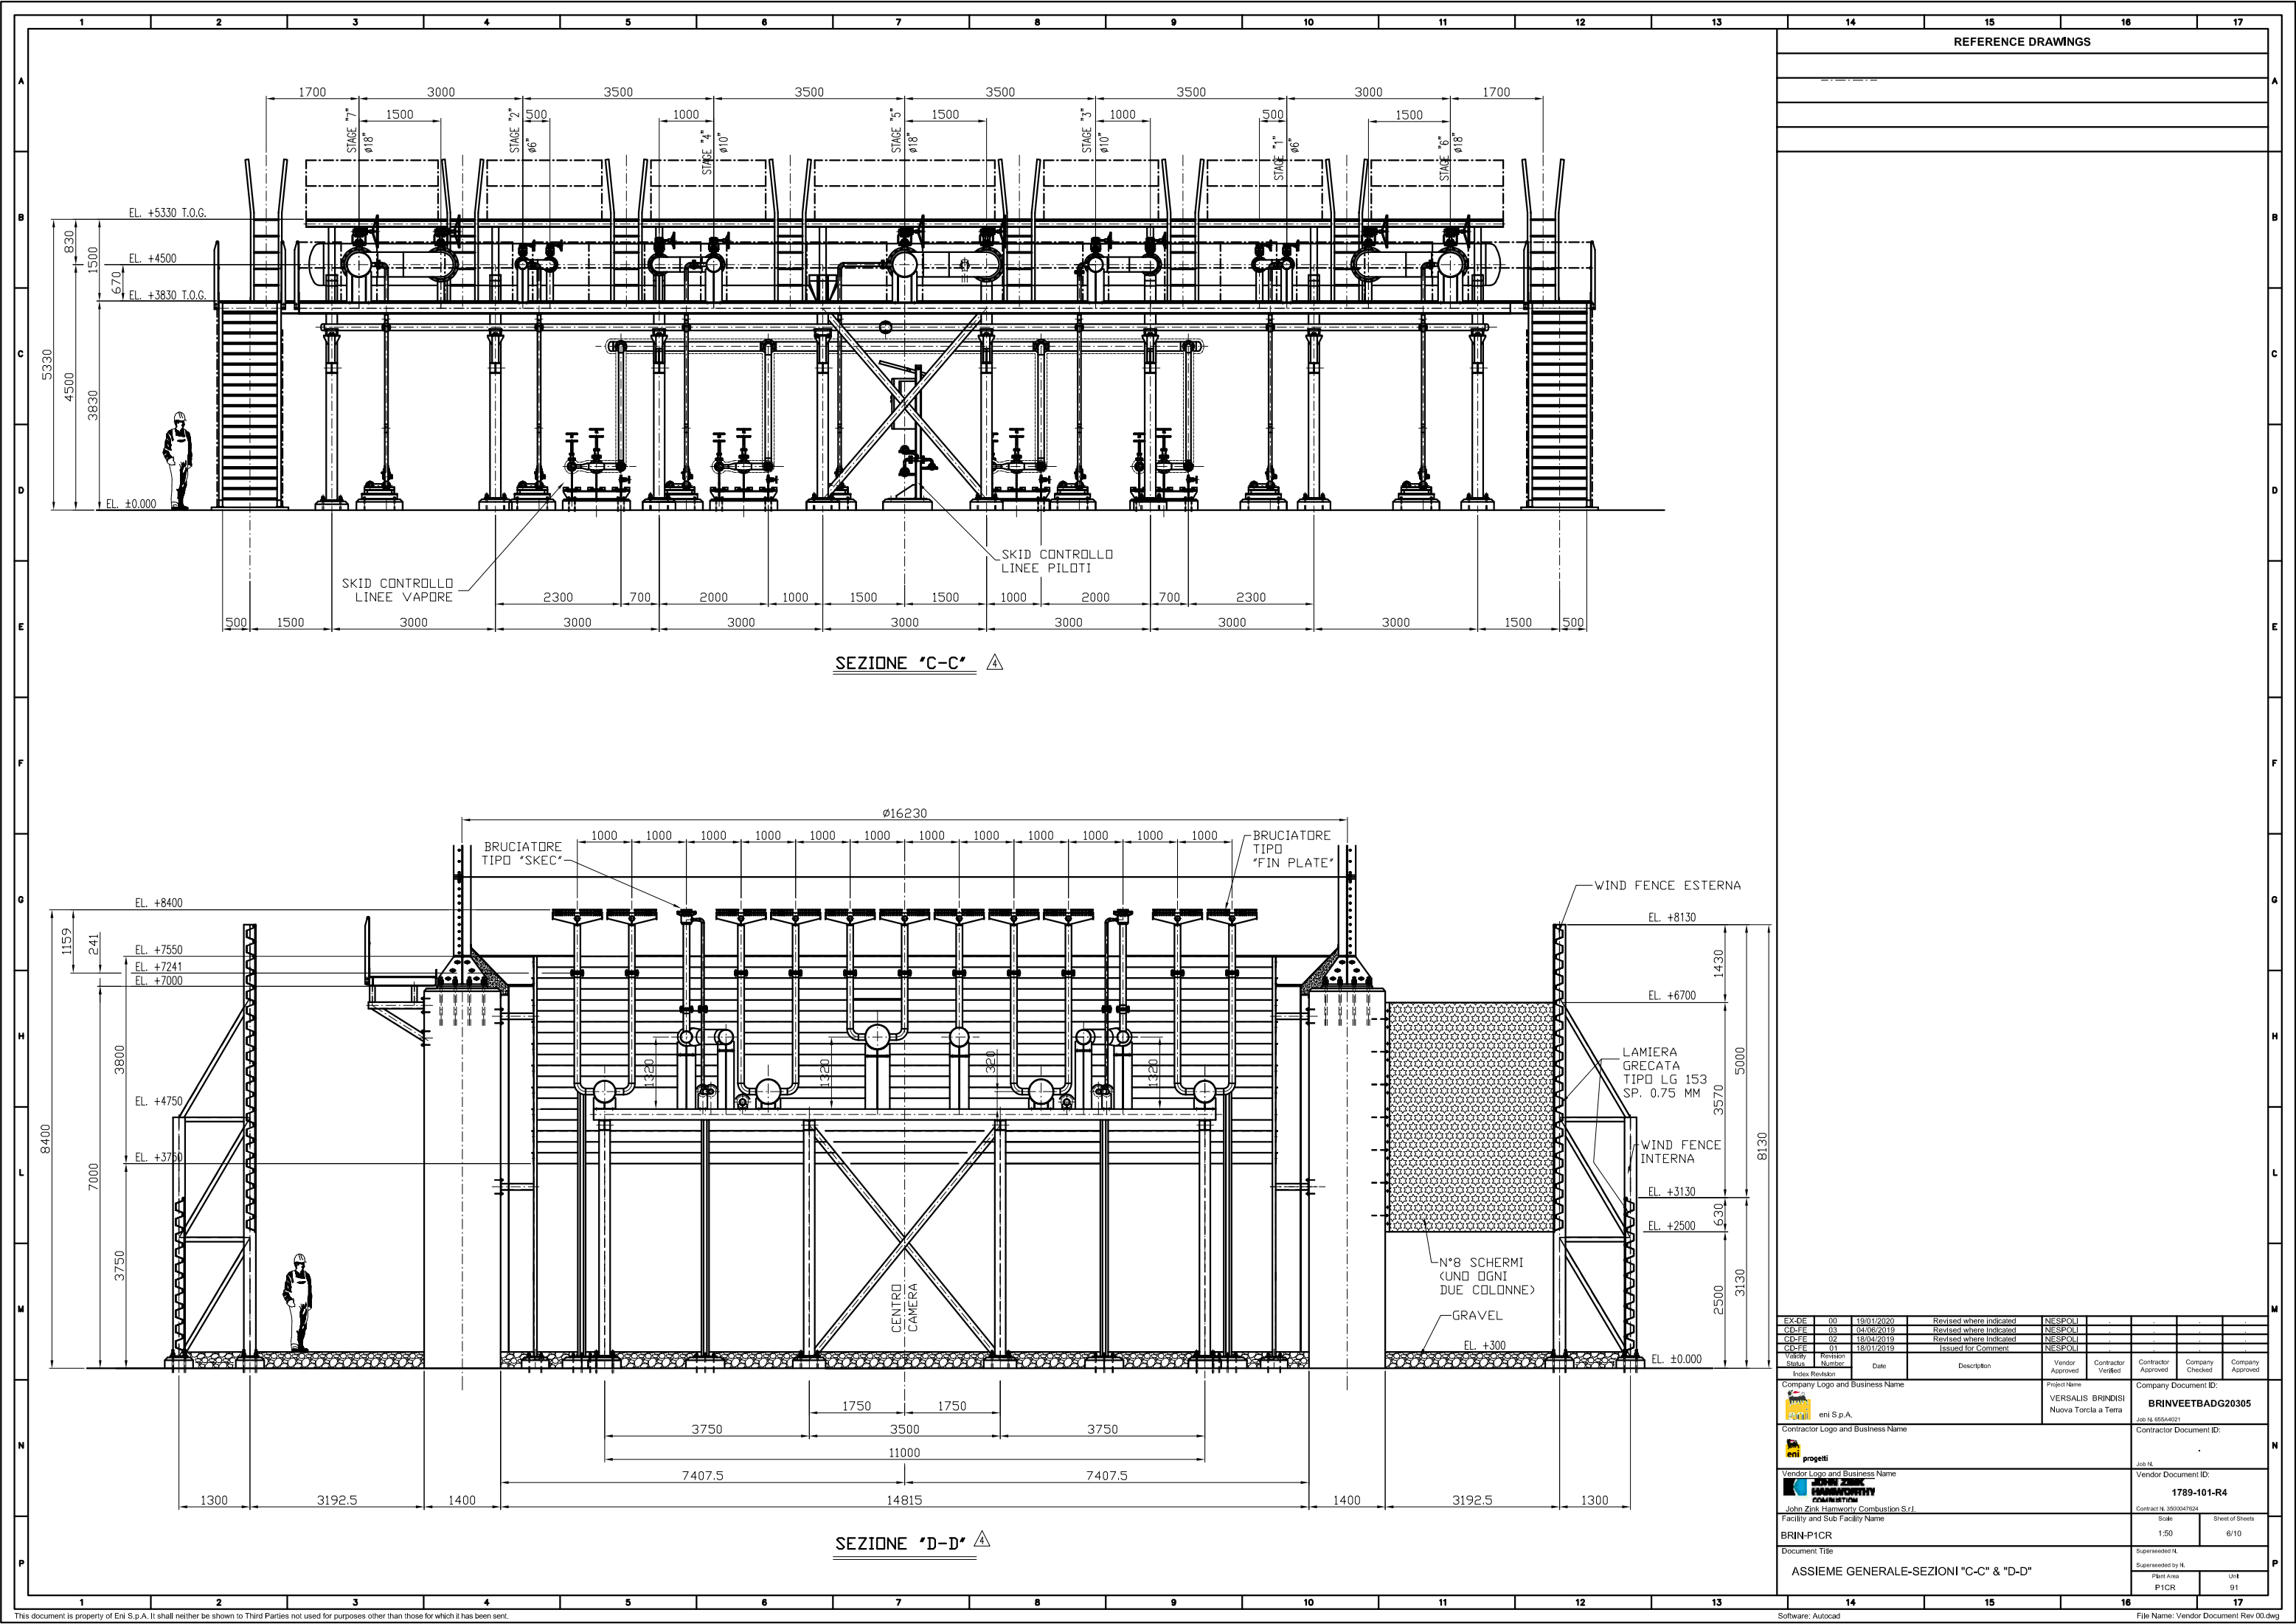


EX-DE	00	19/01/2020	Revised where indicated	NESPOL					
CD-FE	03	04/06/2019	Revised where indicated	NESPOL					
CD-FE	02	19/04/2019	Revised where indicated	NESPOL					
CD-FE	01	19/01/2019	Issued for Comment	NESPOL					
Validity	Status	Revision	Number	Date	Description	Vendor	Contractor	Contractor	Company
Index	Revision					Approved	Approved	Approved	Approved
Company Logo and Business Name				Project Name		Company Document ID:			
Contractor Logo and Business Name				VERSALIS BRINDISI Nuova Torcia a Terra		BRINVEETBADG20305			
Vendor Logo and Business Name				Contract N. 3550047624		Contractor Document ID:			
John Zink Hamworthy Combustion S.r.l.				Contract N. 3550047624		1789-101-R4			
Facility and Sub Facility Name				Scale		Sheet of Sheets			
BRIN-P1CR				1:75		5/10			
Document Title				Superseded by N.		P			
ASSIEME GENERALE-SEZIONE "F-F"				Plant Area		Unit			
				P1CR		91			




EX-D/E		00	19/01/2020	Revised where indicated		NESPOLI						
C-D/E		03	04/06/2019	Revised where indicated		NESPOLI						
C-D/E		02	18/04/2019	Revised where indicated		NESPOLI						
C-D/E		01	18/01/2019	Issued for Comment		NESPOLI						
Validity		Revision Status		Date		Description		Vendor Approved	Contractor Verified	Contractor Approved	Company Checked	Company Approved
Index Revision												
Contractor Logo and Business Name												
 BRINVEET BADG 20305												
Contractor Logo and Business Name												
 progetti												
Vendor Logo and Business Name												
 JOHN ZINK HAMMOVORY COMBUSTION SYSTEMS												
Facility and Sub Facility Name												
BRIN-P1CR												
Document Title												
ASSIEME GENERALE-SEZIONI "C-C" e "D-D"												

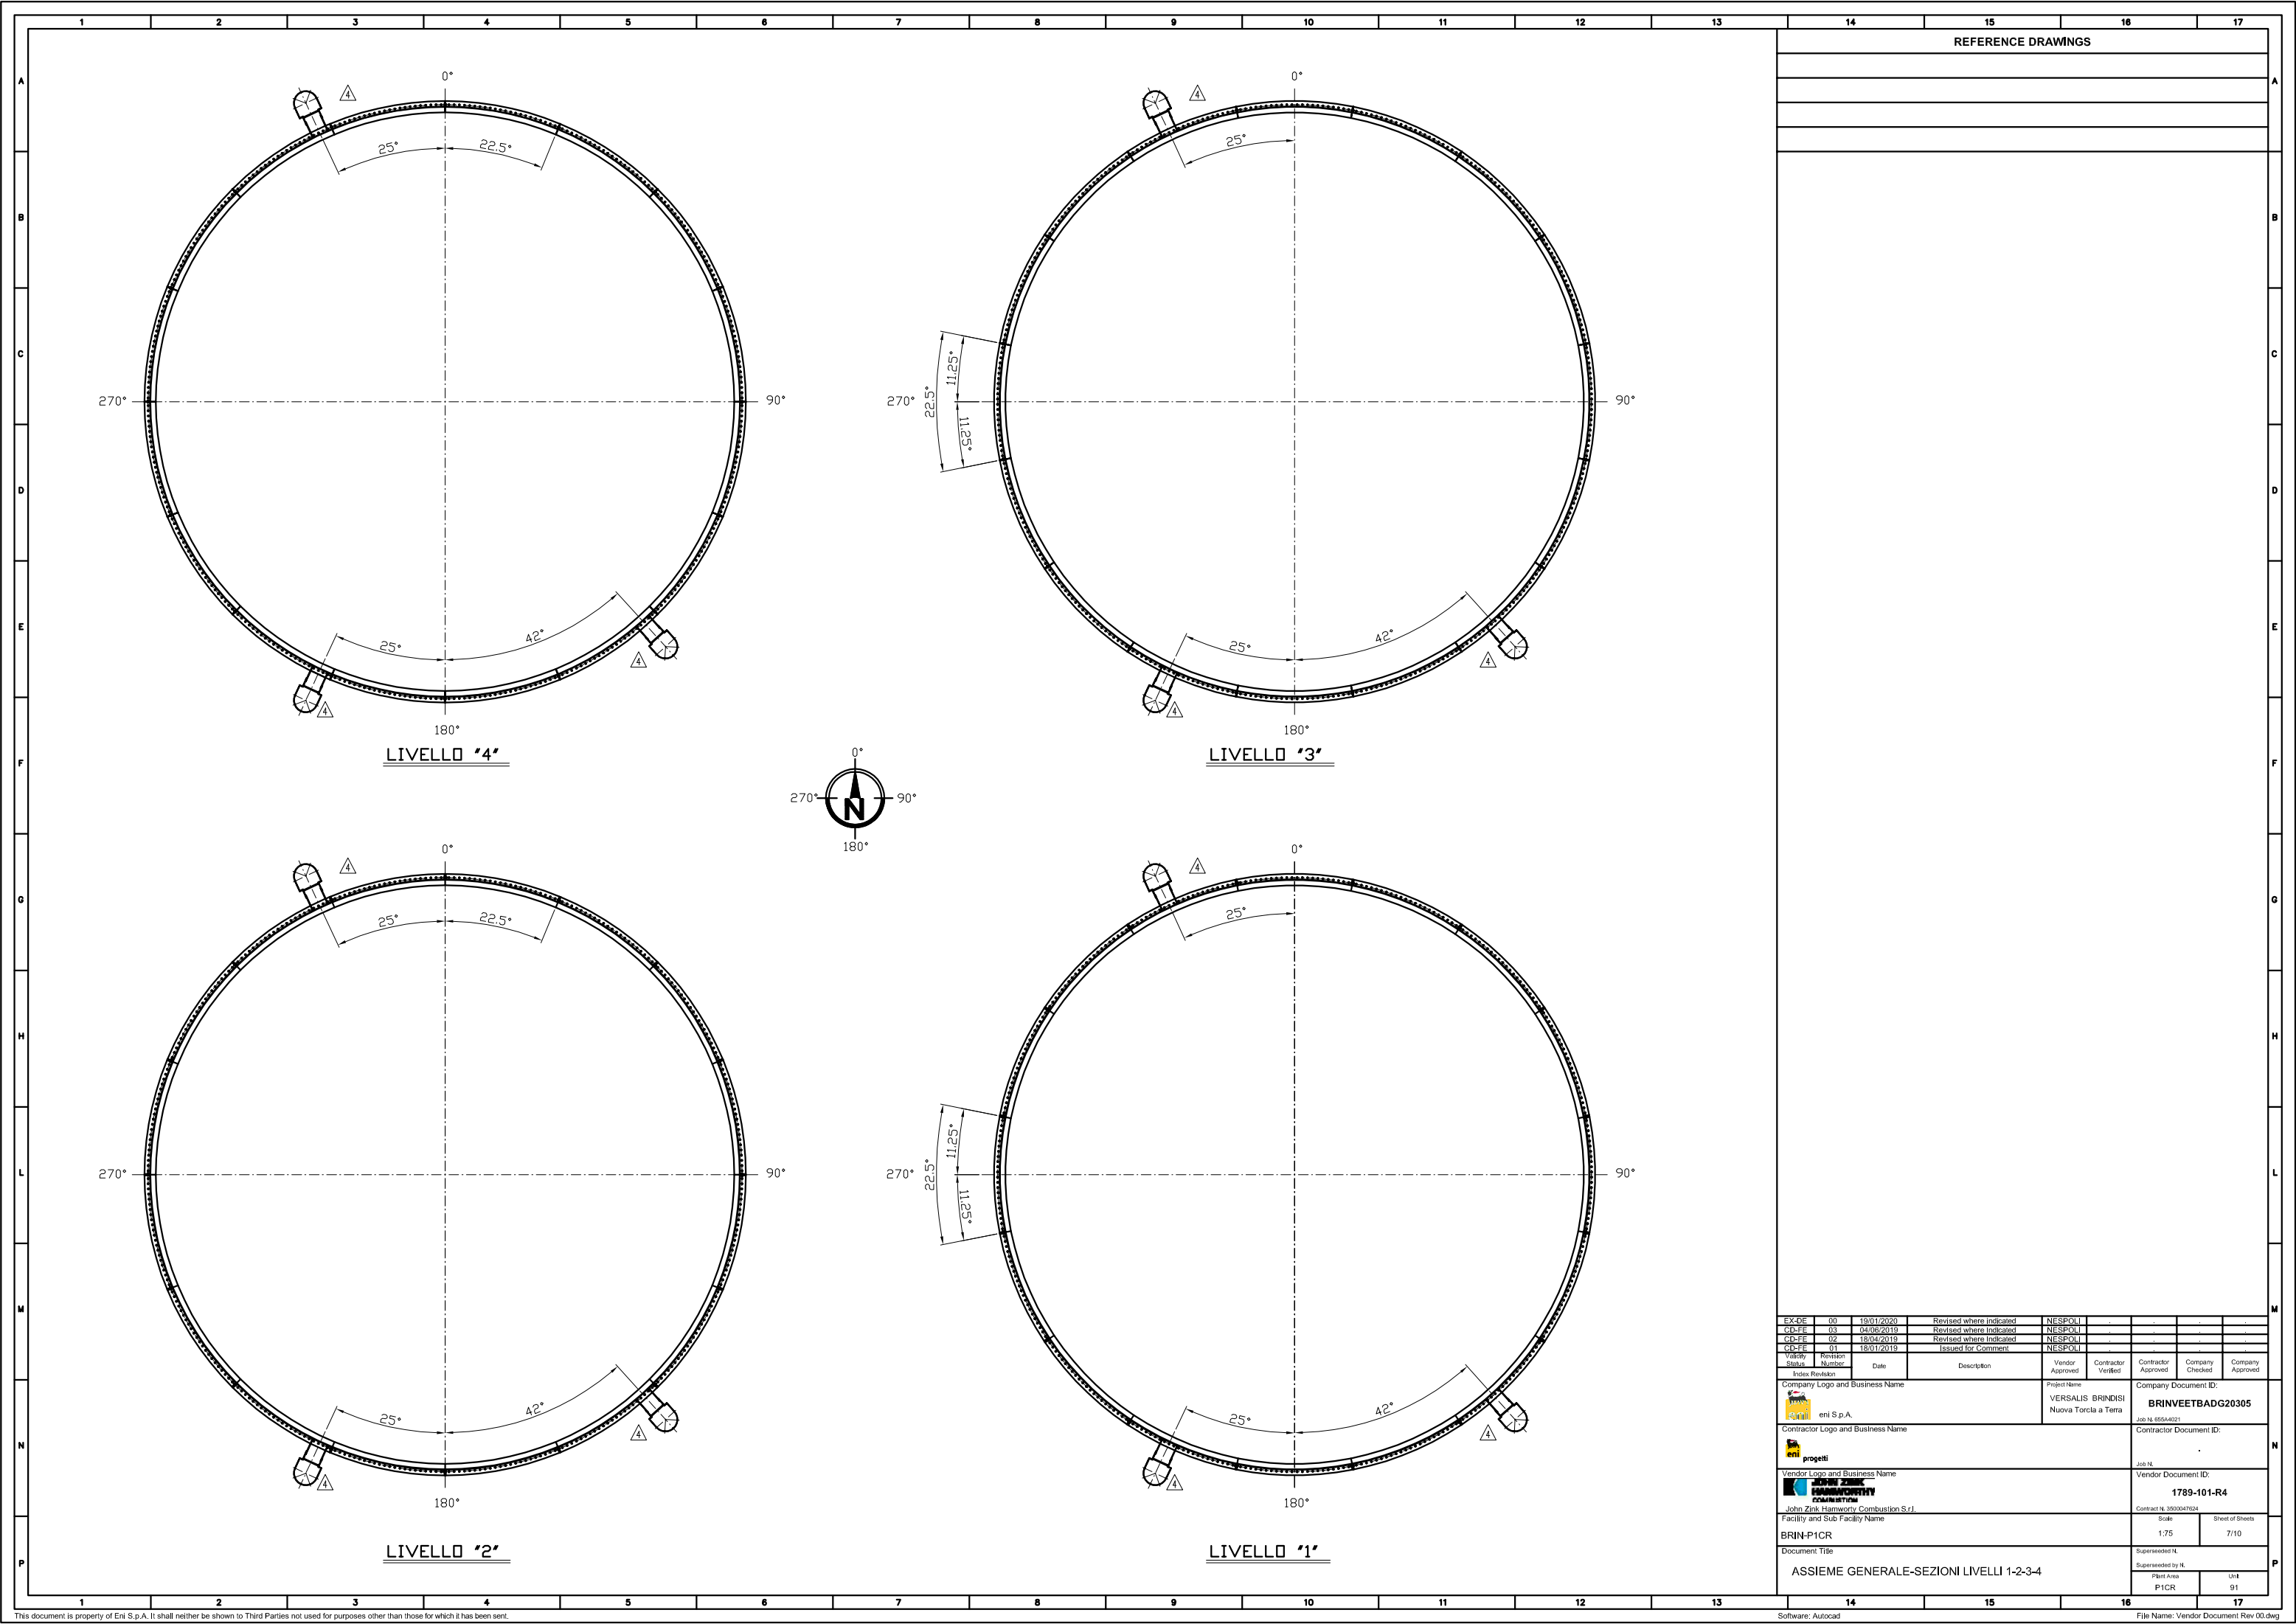



REFERENCE DRAWINGS									
EX-DE	00	19/01/2020	Revised where indicated	NESPOLI					
CD-FE	03	04/06/2019	Revised where indicated	NESPOLI					
CD-FE	02	19/04/2019	Revised where indicated	NESPOLI					
CD-FE	01	19/01/2019	Issued for Comment	NESPOLI					
Validity Status	Revision Number	Date	Description	Vendor Approved	Contractor Verified	Contractor Approved	Company Checked	Company Approved	
Index Revision									
Company Logo and Business Name				Project Name		Company Document ID:			
 eni S.p.A.				VERSALIS BRINDISI Nuova Torcia a Terra		Job N. 05564021 BRINVEETBADG20305			
 progetti				Job N.		Contractor Document ID:			
 John Zink Hamworthy Combustion S.r.l.				Vendor Document ID:		Contract N. 3500047624 1789-101-R4			
Facility and Sub Facility Name				Scale		Sheet of Sheets			
BRIN-P1CR				1:75		7/10			
Document Title				Superseded by N.		Unit			
ASSIEME GENERALE-SEZIONI LIVELLI 1-2-3-4				Plant Area		P1CR			
						91			

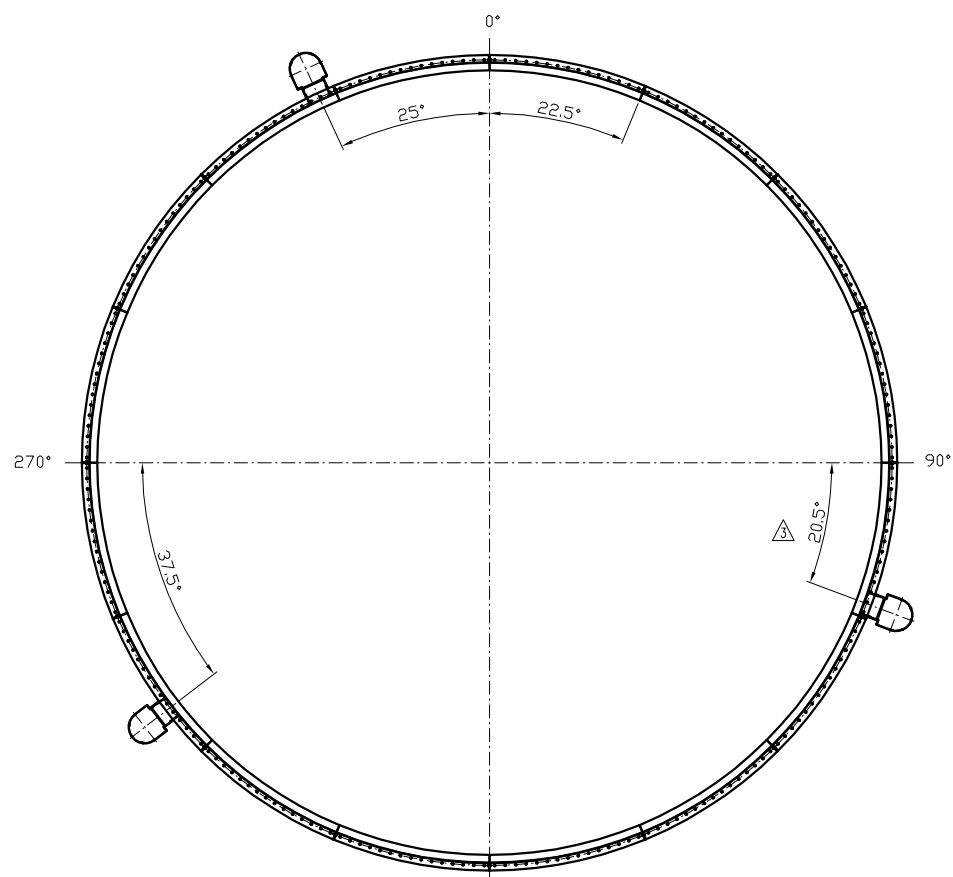


LIVELLO "12"

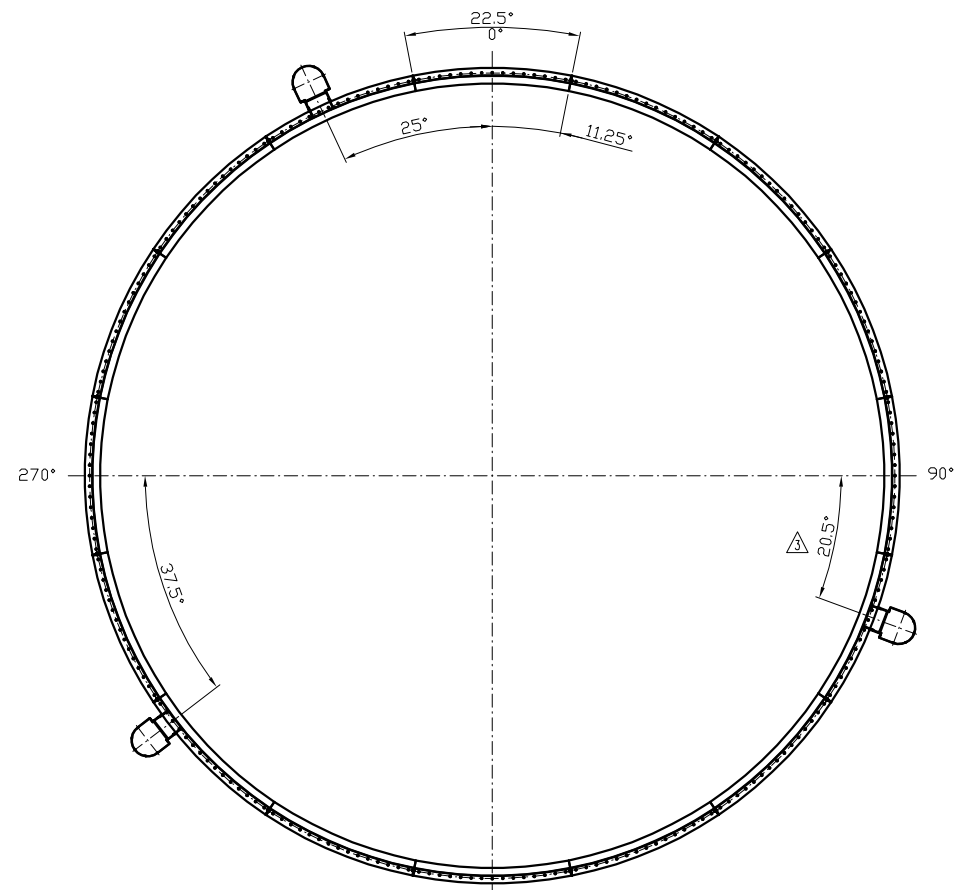

LIVELLO "11"

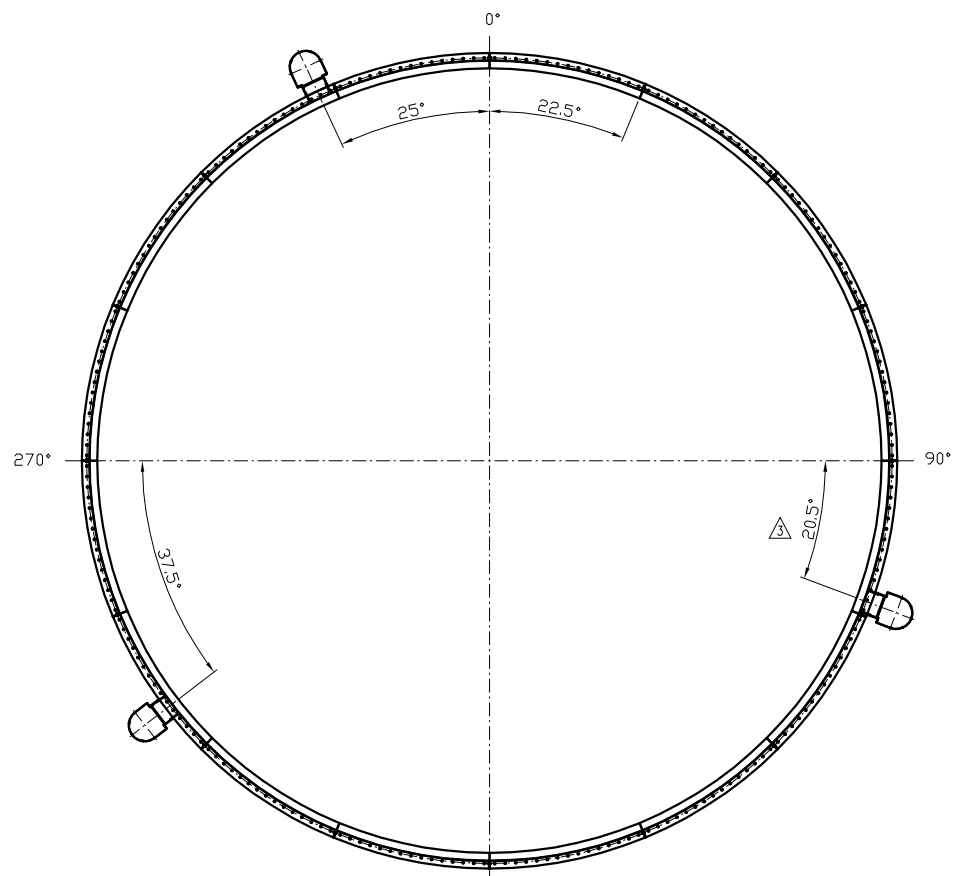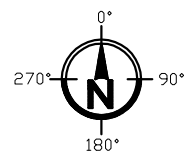




LIVELLO "10"

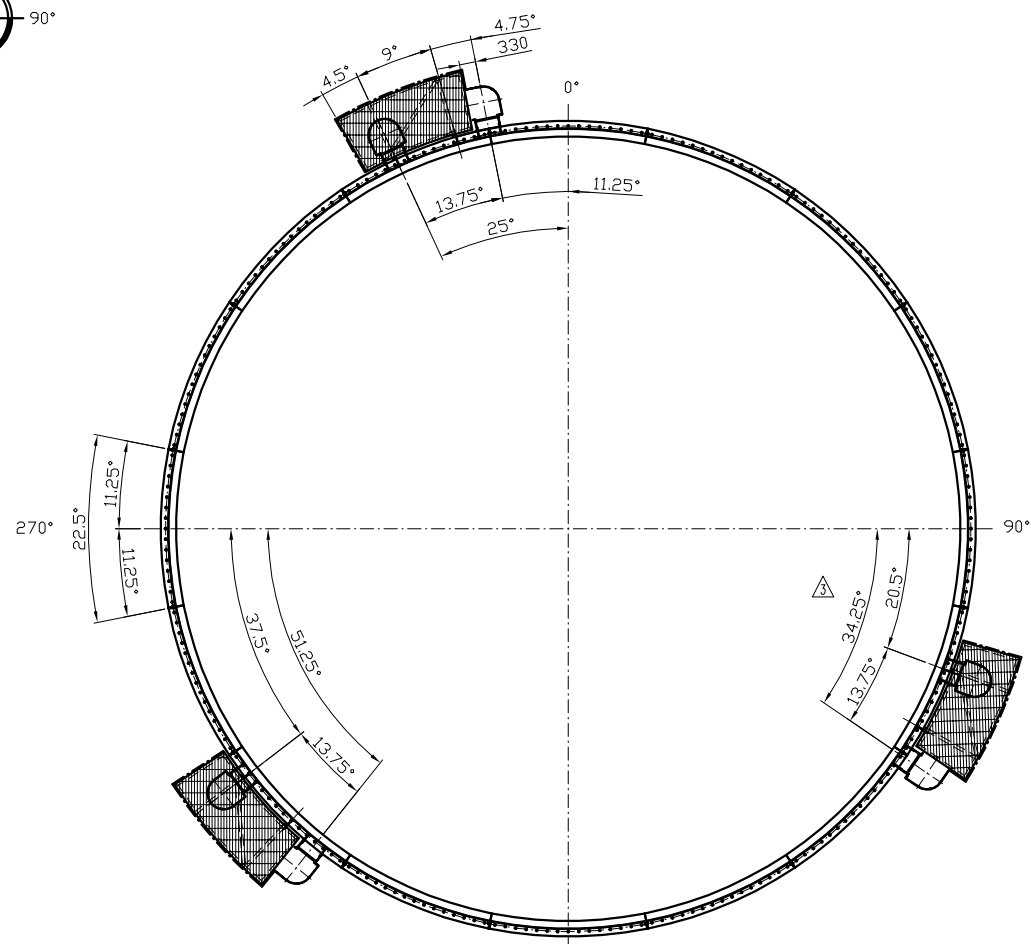



LIVELLO "9"




REFERENCE DRAWINGS

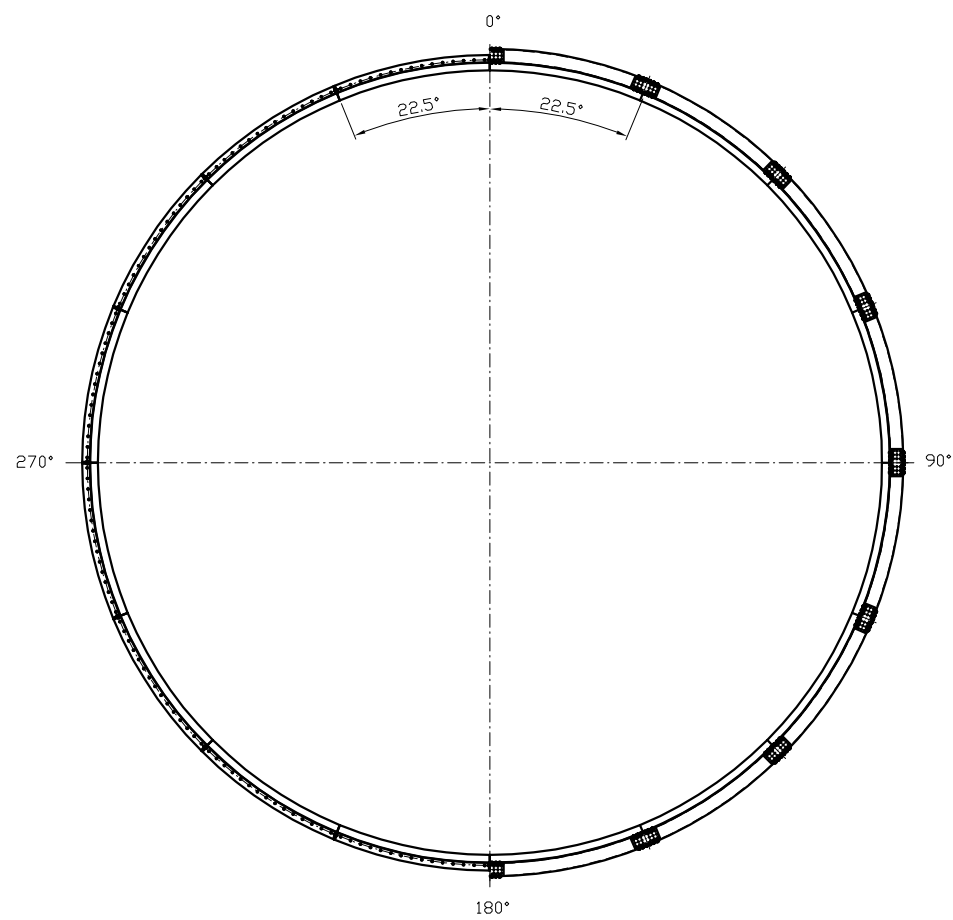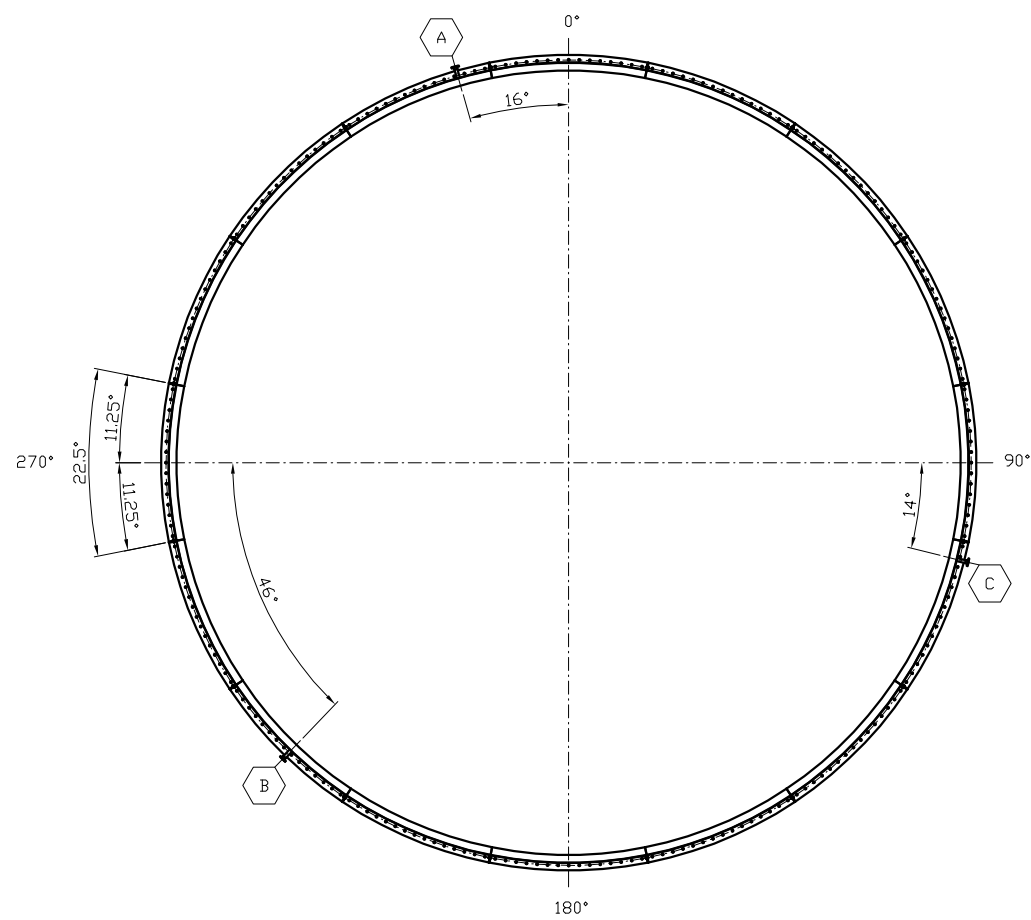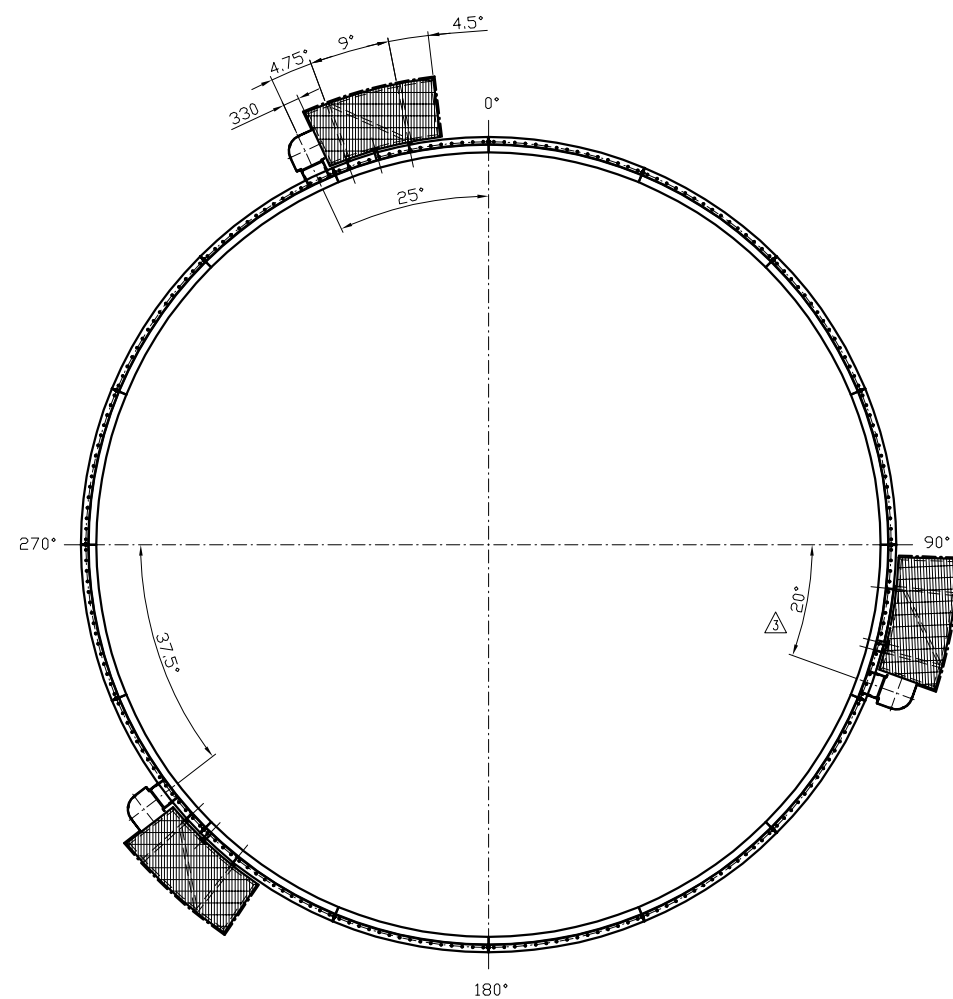[illegible]

LIVELLO "16"LIVELLO "15"

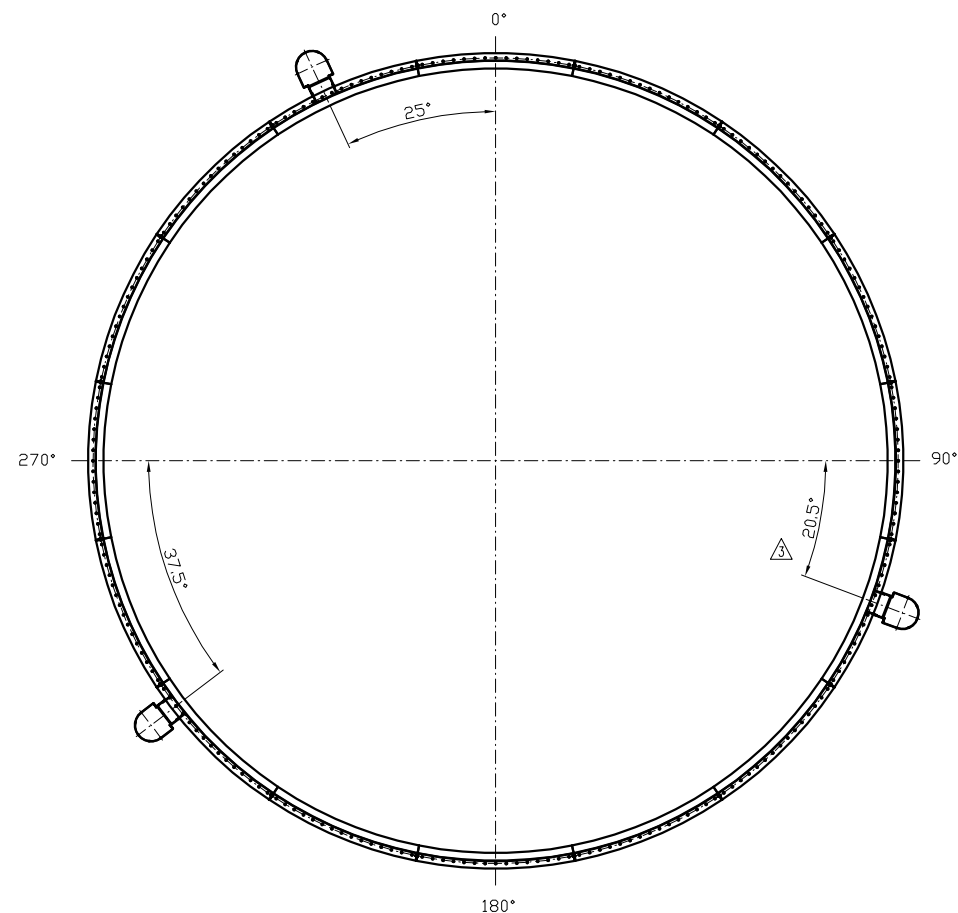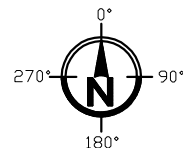LIVELLO "14"

LIVELLO "13"

REFERENCE DRAWINGS									
EX-DE	00	19/01/2020	Revised where indicated	NESPOU
CD-FE	03	04/06/2019	Revised where indicated	NESPOU
CD-FE	02	18/04/2019	Revised where indicated	NESPOU
CD-FE	01	18/01/2019	Issued for Comment	NESPOU
Validity	Revision	Date	Description	Vendor Approved	Contractor Verified	Contractor Approved	Company Checked	Company Approved	
Index	Revision								
Company Logo and Business Name				Project Name		Company Document ID:			
 VERSALIS Versalis S.p.A.				VERSALIS BRINDISI Nuova Torcia a Terra		BRINVEETBADG20305 Job N. 856A4021			
Contractor Logo and Business Name						Contractor Document ID:			
 progetti						Job N.			
Vendor Logo and Business Name						Vendor Document ID:			
 JOHN ZINK HAMWORTHY COMBUSTION S.r.l.						1789-101-R4 Contract N. 3500347624			
Facility and Sub Facility Name				Scale		Sheet of Sheets			
BRIN-P1CR				1:75		10/10			
Document Title						Superseded by N.			
ASSIEME GENERALE-SEZIONI LIVELLI 13-14-15-16						Superseded by N.			
						Plant Area		Unit	
						P1CR		91	