
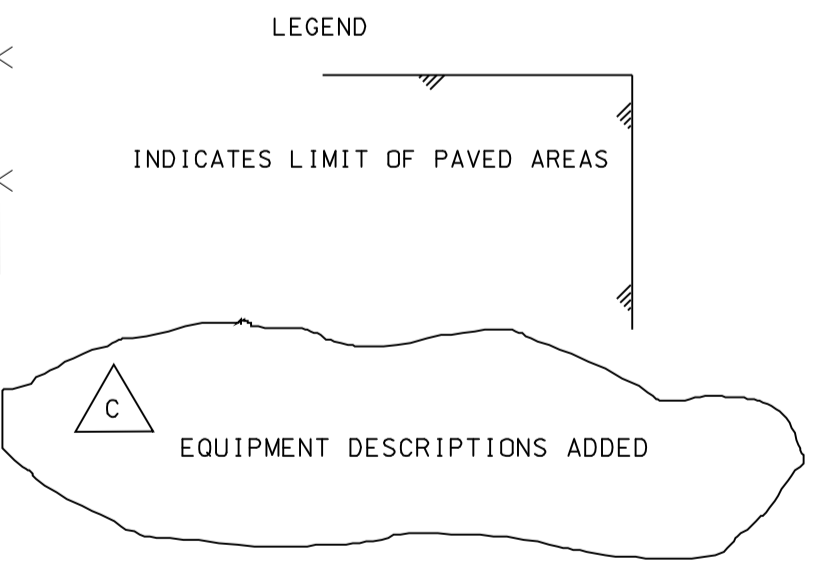


UNCONTROLLED

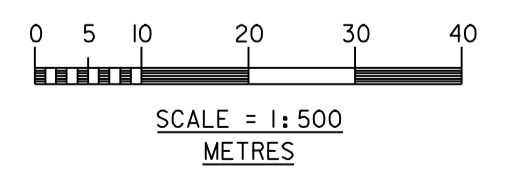

C	RE-ISSUED FOR FEED	MAY 2005	MIKE HILL			
B	ISSUED FOR FEED	APRIL 2005	MIKE HILL	AC		AF/BE
A	ISSUED FOR MULTI DISCIPLINE REVIEW	FEB 2005	MIKE HILL			
REV	REVISION DESCRIPTION/ISSUE STATUS	DATE	ORIG	CHECK	REVIEW	APPR
SIGNATURE BOXES SHALL BE COMPLETED IN ACCORDANCE WITH DISCIPLINE DC PROCEDURES						
		M. W. Kellogg Limited				
GAS NATURAL LNG RECEIVING TERMINAL TARANTO, ITALY						
PLOT PLAN						
PROCESS AND STORAGE AREA						
		1:500	5867-01	P1-00-P10-002	C	
QAT CODE	ITEM OR CLASS	AREA	SCALE	JOB NUMBER	DRAWING NUMBER	REV