


REFERENCE DRAWINGS / DISEGNI DI RIFERIMENTO

| DWG. N° / N° DIS         | DESCRIPTIONS / DESCRIZIONE                                     |
|--------------------------|--|
| 0469-TITA-P-PP-000-001_0 | GENERAL PLOT PLAN  |
| 0469-TITA-E-LY-000-131   | ELECTRICAL EQUIPMENT LAYOUT MAIN CONTROL & ELECTRICAL BUILDING |
| 0469-TITA-I-LY-001-101   | MAIN CONTROL-RACK ROOM LAYOUT                                  |
| .....                    | .....  |
| .....                    | .....  |


NOTE:

- 1 - ALL DIMENSION AND ELEVATION ARE IN METER.
- 2 - THE REFERENCE ELEVATION ± 0.000 M CORRESPONDES TO +2.500 M A.S.L.


TRANSVERSAL SECTION  
SCALE 1:100

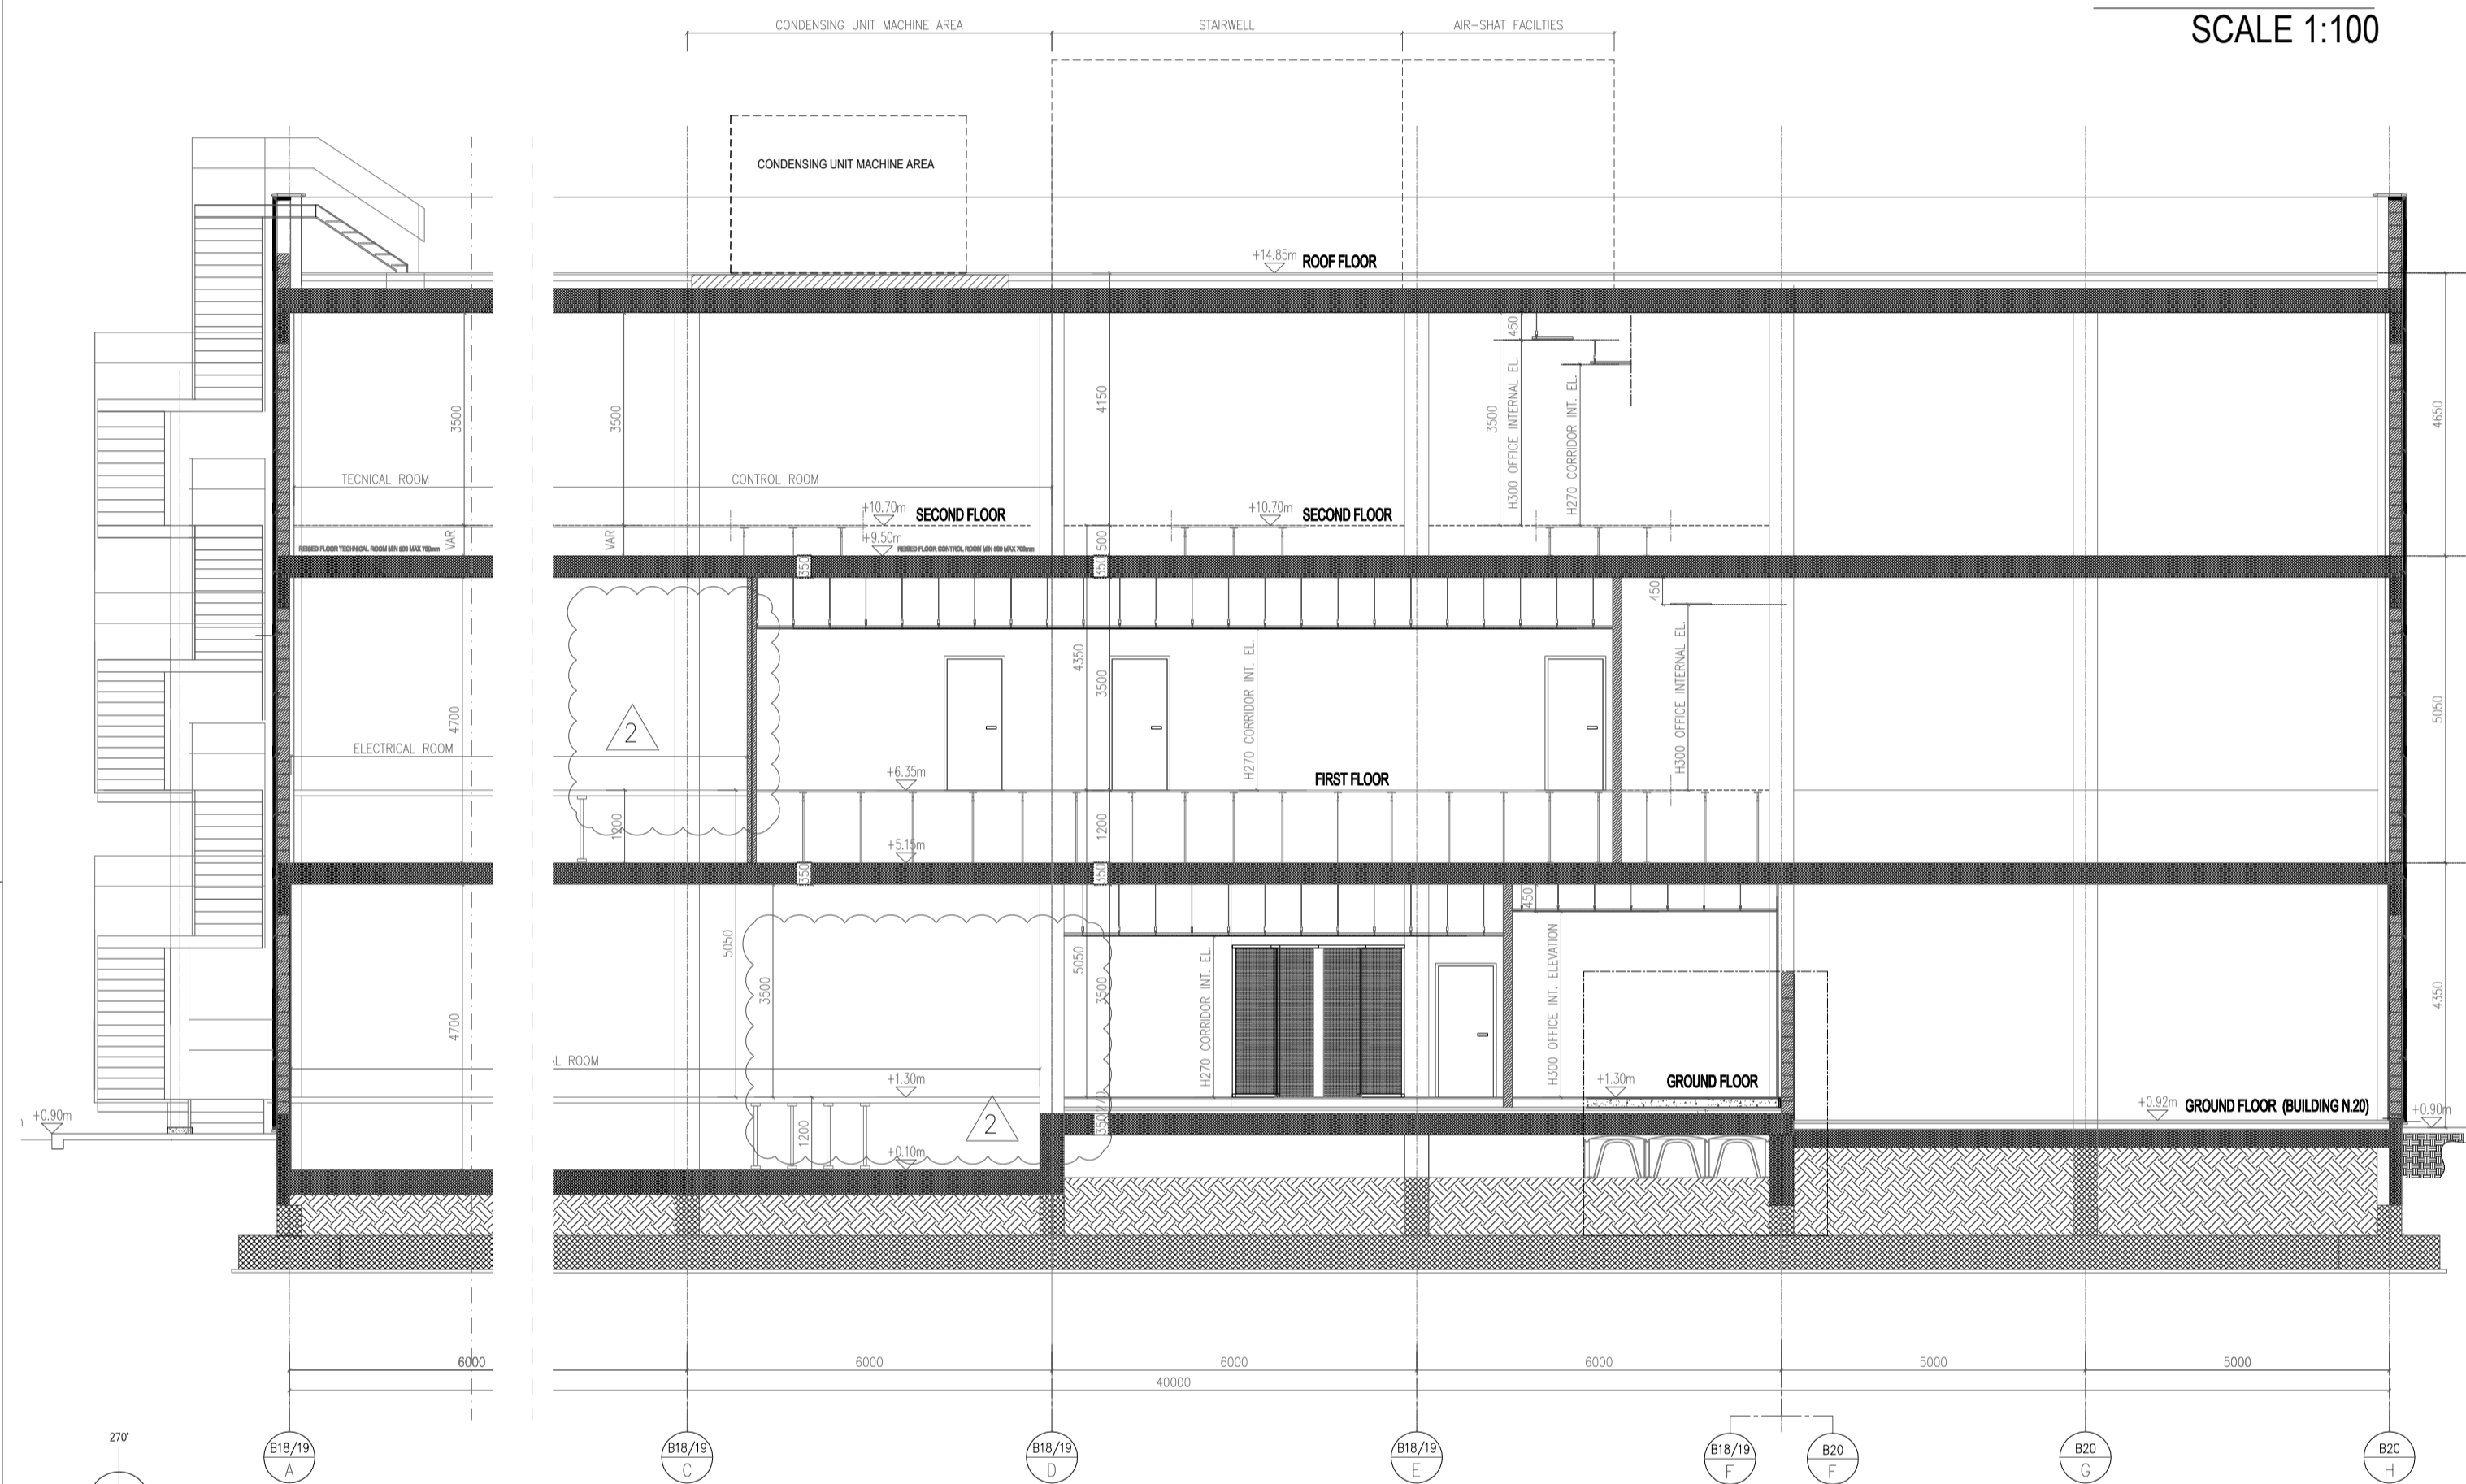

TYPICAL SECTION  
SCALE 1:50

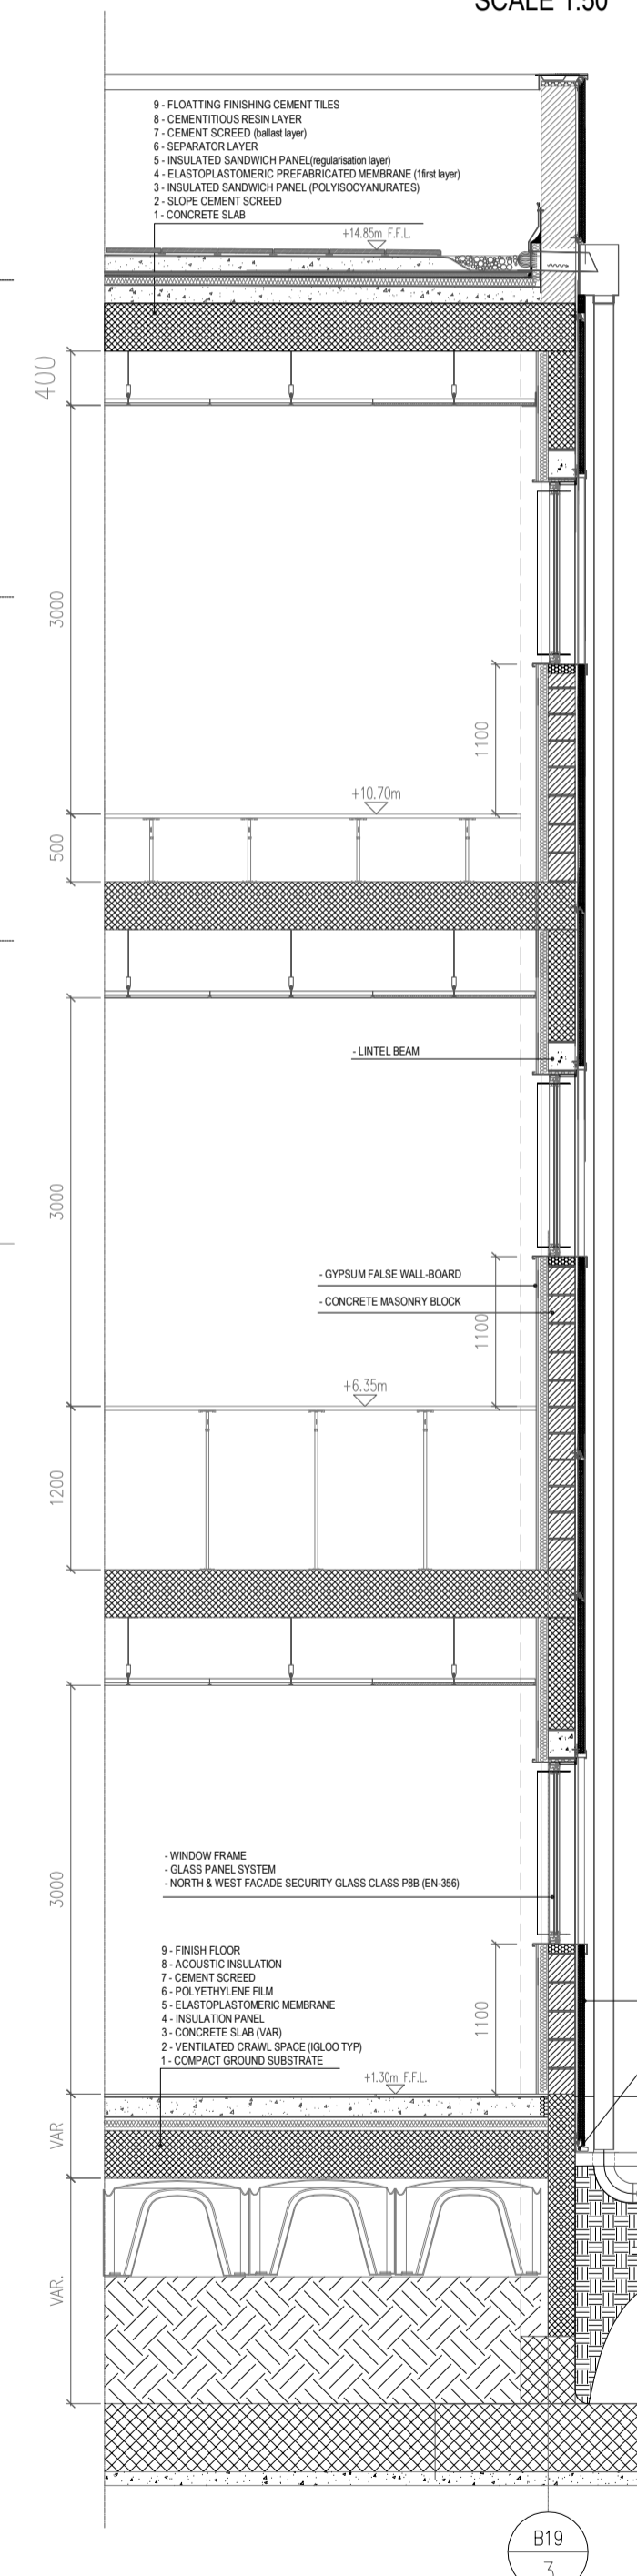

TYPICAL FACADE SECTION  
SCALE 1:50

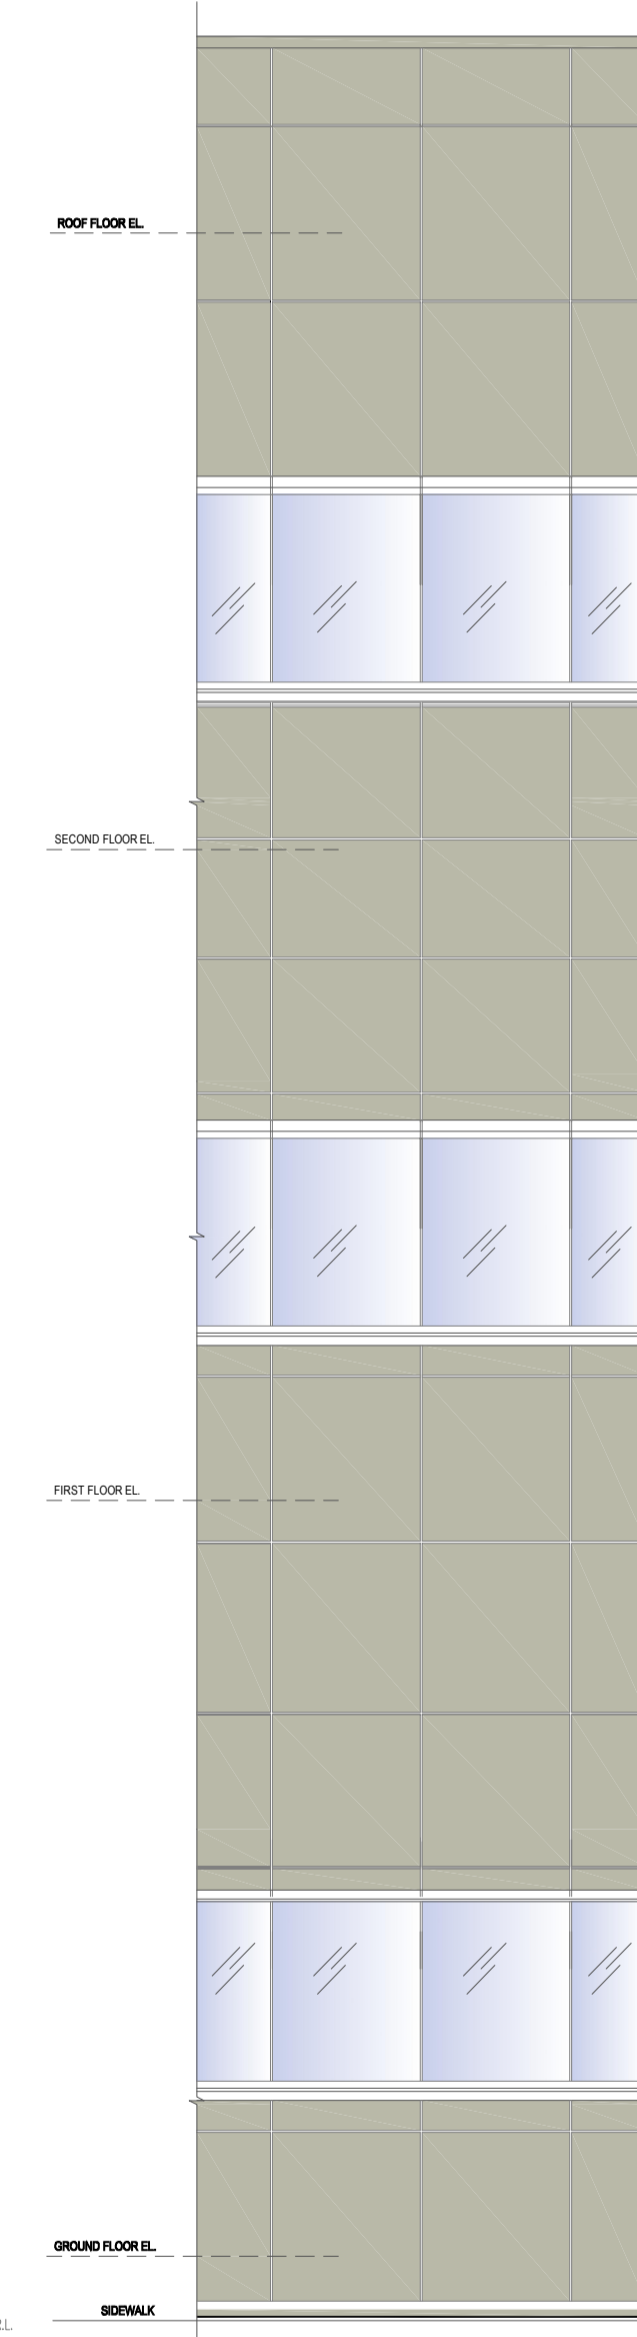

| REV. | DESCRIPTION - Descrizione | PREP'D - Red. | CHK'D - Contr. | APPR'D - Appr. | REV APPR'D - Appr. | DATE - Date |
|------|---------------------------|---------------|----------------|----------------|--------------------|-------------|
| 2    | ISSUED FOR USE            |               |                |                |                    | 05/08/20    |
| 1    | ISSUED FOR USE            |               |                |                |                    | 03/08/20    |
| 0    | ISSUED FOR COMMENT        |               |                |                |                    | 24/07/20    |

REVISIONS - Modifiche

CONTRACTOR: **TECHINT Engineering & Construction**

COMPANY: **VeniceLNG**

JOB NUMBER: COMPANY DOC. N°

PROJECT TITLE: **VENICE LNG FEED - VENICE LNG TERMINAL (PORTO MARGHERA)**

TITLE: **BUILDING N.18, 19, 20 ELECTRICAL, CONTROL&OFFICE BUILDING, WAREHOUSE VIEW & SECTION**

| SCALE: 1:50/100 | FORM: A1 | CONTRACTOR DOC. N°: 0469-TITA-A-PW-001-002 | REV: 2 | SHT. OF: 1 di 2 |
|-----------------|----------|--|--------|-----------------|
|-----------------|----------|--|--------|-----------------|

La TECHINT si riserva la proprietà di questo disegno con la proibizione di riprodurlo o trasferirlo a terzi senza autorizzazione scritta. This document is property of TECHINT. Reproduction and divulgation forbidden without written permission.

REFERENCE DRAWINGS / DISEGNI DI RIFERIMENTO


| DWG. N° / N° DIS         | DESCRIPTIONS / DESCRIZIONE                                     |
|--------------------------|--|
| 0469-TITA-P-PP-000-001_0 | GENERAL PLOT PLAN  |
| 0469-TITA-E-LY-000-131   | ELECTRICAL EQUIPMENT LAYOUT MAIN CONTROL & ELECTRICAL BUILDING |
| 0469-TITA-I-LY-001-101   | MAIN CONTROL-RACK ROOM LAYOUT                                  |
| .....                    | .....  |
| .....                    | .....  |

NOTE:

- 1 - ALL DIMENSION AND ELEVATION ARE IN METER.
- 2 - THE REFERENCE ELEVATION ± 0.000 M CORRESPONDES TO +2.500 M A.S.L.



WEST ELEVATION  
SCALE 1:100

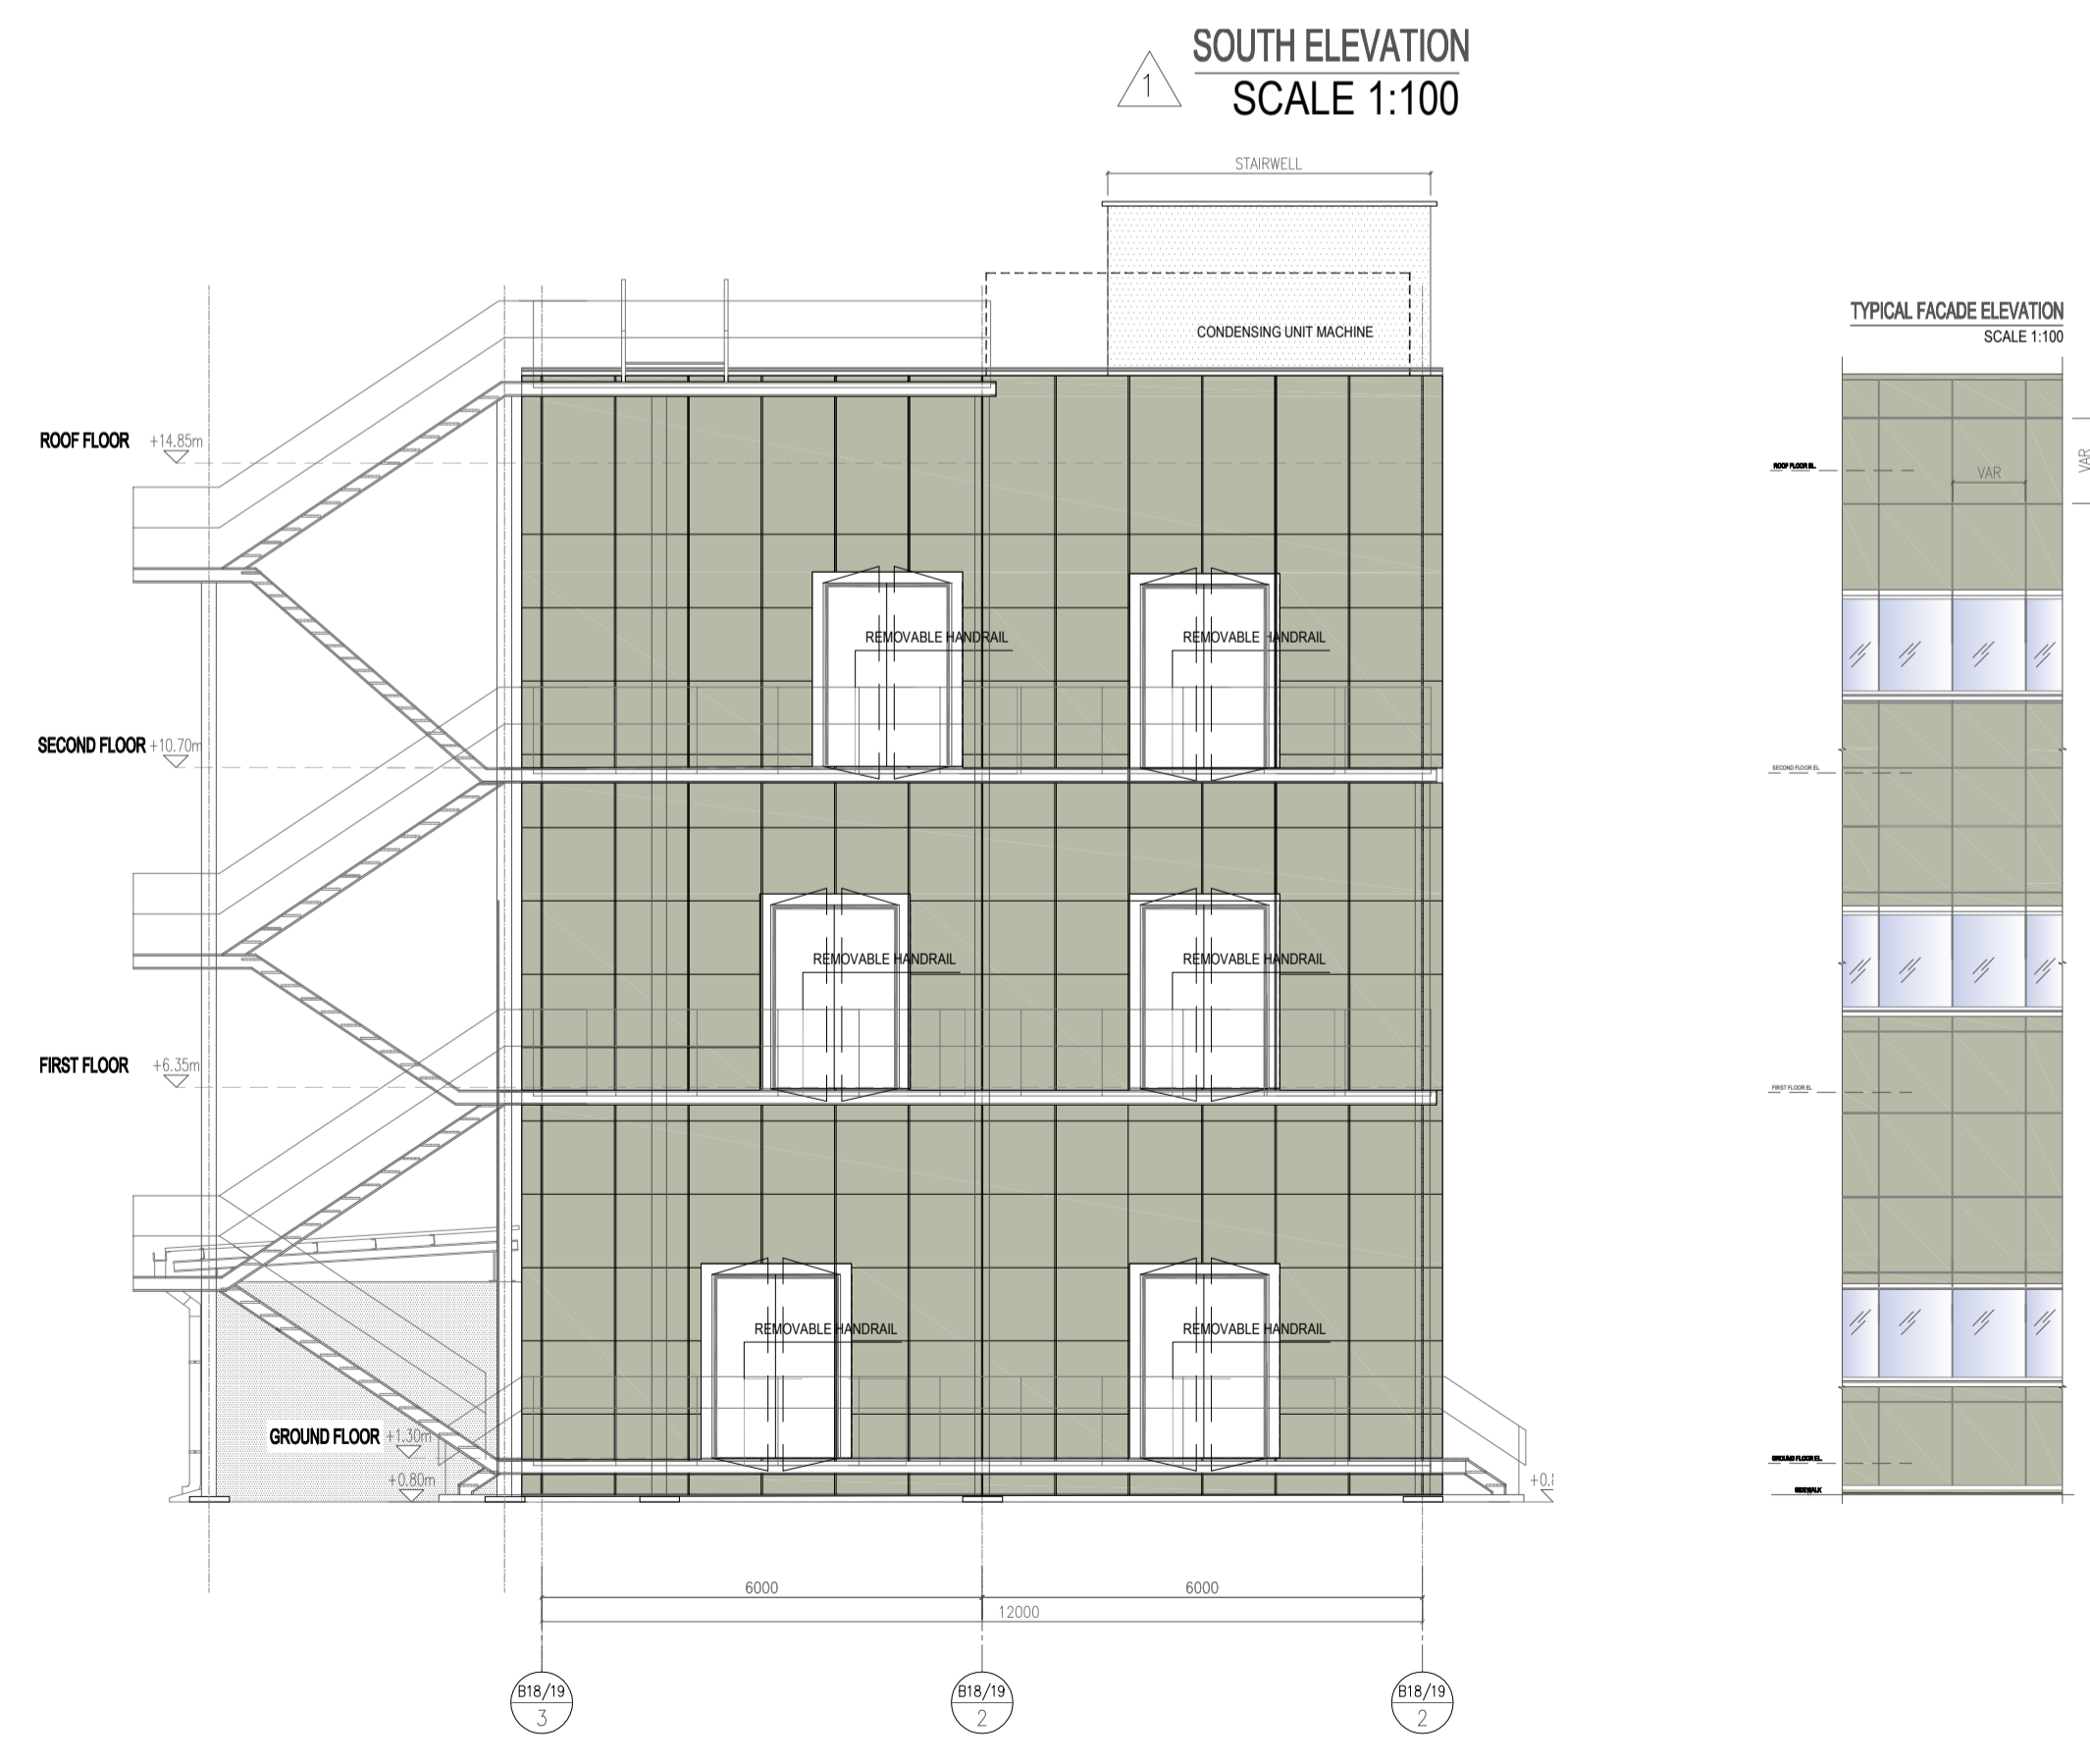

SOUTH ELEVATION  
SCALE 1:100

TYPICAL FAÇADE ELEVATION  
SCALE 1:100

| REV. | DESCRIPTION - Descrizione | PREP'D - Red. | CHK'D - Contr. | APPR'D - Appr. | REV APPR'D - Appr. | DATE - Data |
|------|---------------------------|---------------|----------------|----------------|--------------------|-------------|
| 2    | ISSUED FOR USE            | COV           | GCA            | DMR            | CMA                | 05/08/20    |
| 1    | ISSUED FOR USE            | COV           | GCA            | DMR            | CMA                | 03/08/20    |
| 0    | ISSUED FOR COMMENT        | COV           | GCA            | DMR            | CMA                | 24/07/20    |

REVISIONS - Modifiche

CONTRACTOR: **TECHINT Engineering & Construction**  
 COMPANY: **VeniceLNG**

JOB NUMBER: COMPANY DOC. N°: PROJECT TITLE: VENICE LNG

FEED - VENICE LNG TERMINAL (PORTO MARGHERA)

BUILDING N.18, 19, 20  
 ELECTRICAL, CONTROL&OFFICE BUILDING, WAREHOUSE  
 VIEW & SECTION

| SCALE: 1:50/100 | FORM: A1 | CONTRACTOR DOC. N°: 0469-TITA-A-PW-001-002 | REV. 2 | SHT. 2 | OF 2 |
|-----------------|----------|--|--------|--------|------|
|-----------------|----------|--|--------|--------|------|

La TECHINT si riserva la proprietà di questo disegno con la proibizione di riprodurlo o trasferirlo a terzi senza autorizzazione scritta. This document is property of TECHINT. Reproduction and divulgation forbidden without written permission.