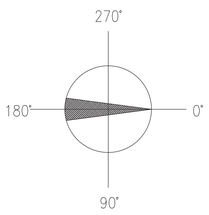

REFERENCE DRAWINGS / DISEGNI DI RIFERIMENTO

DWG. N° / N° DIS	DESCRIPTIONS / DESCRIZIONE
0469-TITA-P-PP-000-001	GENERAL PLOT PLAN
0469-TITA-C-GD-001-006	ROADS AND PAVED AREAS
.....	.....
.....	.....
.....	.....

NOTE:

1 – HIGH POINT OF PAVING EL. 0.00 CORRESPOND TO 2500mm SLM

LEGEND:

- Drainage pit
- Manhole
- Spillway pit
- Gravelled area

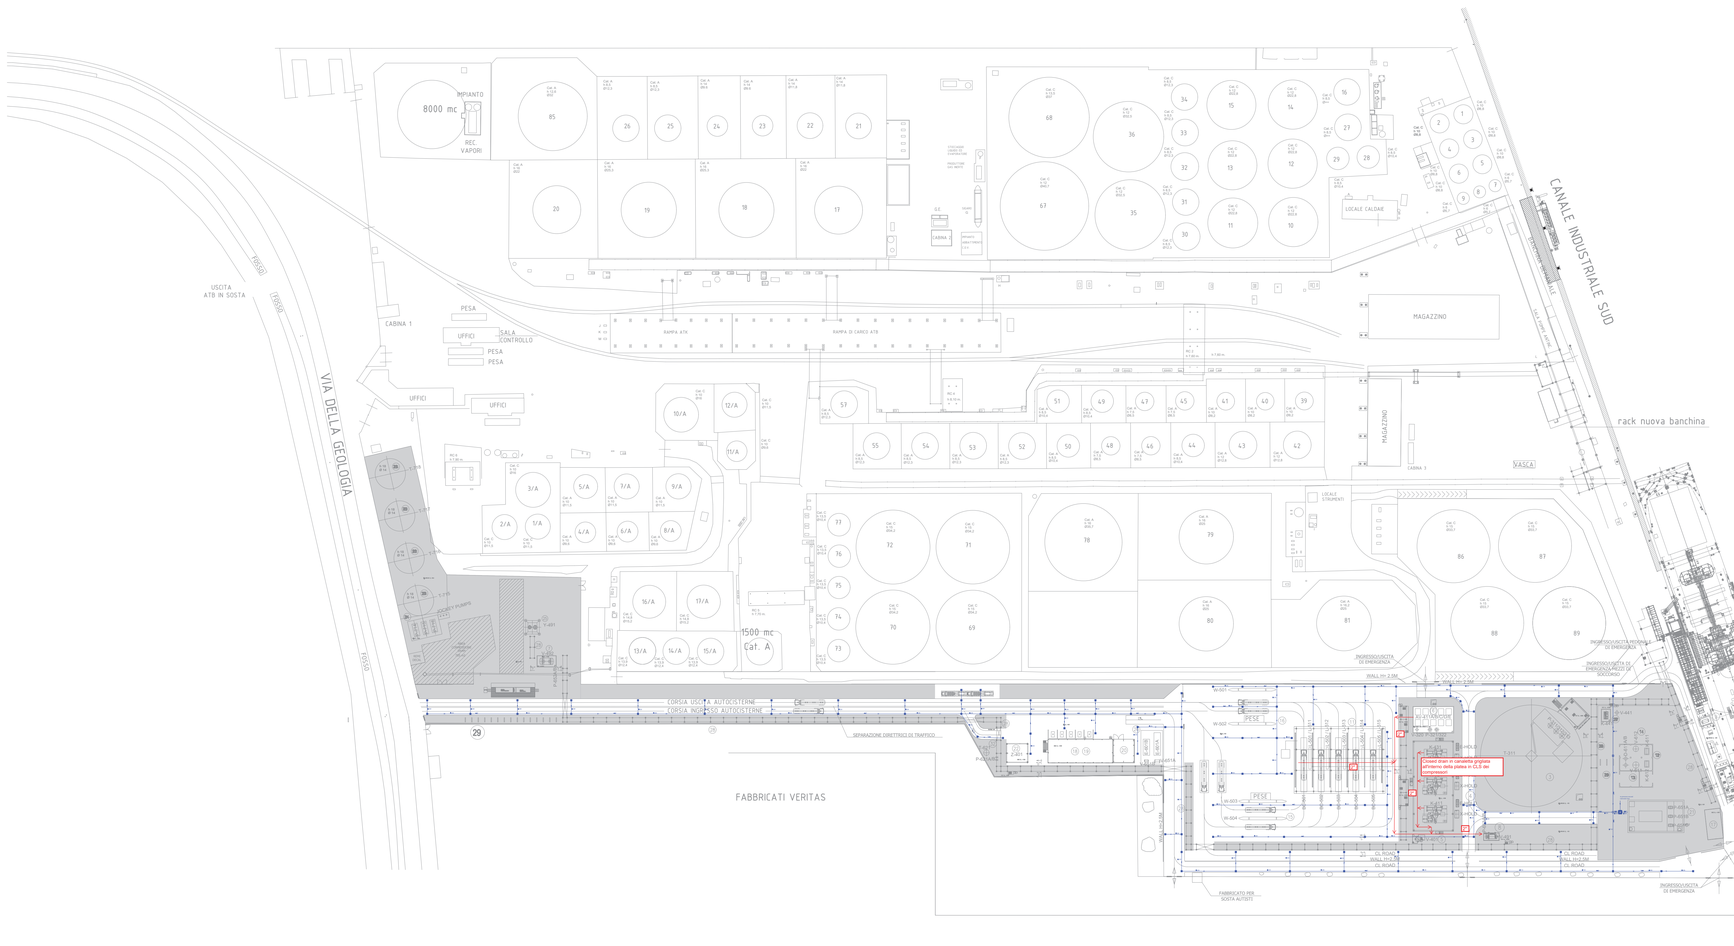

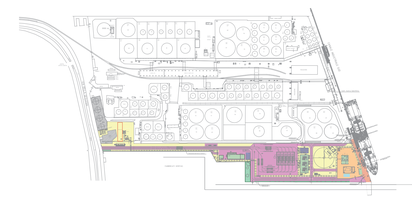

- ROADS AREA
- GRAVELLED AREA
- GRAVELLED AREA WITH GEOCELLS (CARRIAGEABLE)
- PAVED AREA
- PAVED AREA (KERBED)
- GREEN AREA (LANDSCAPE)
- BUILDINGS AND SHELTER AREA
- EXISTING SLAB
- EXISTING QUAY (NO ACTIVITIES TO BE CONSIDERED FOR THE EXISTING R.C. PAVING)

PRECAST / CAST IN SITU CATCH BASIN IN ASPHALT PAVING

SECTION A–A

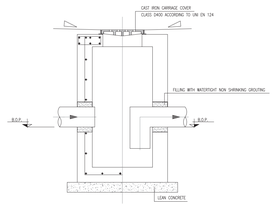

PLAN

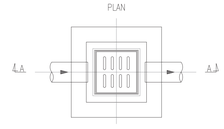

PRECAST / CAST IN SITU CATCH BASIN IN CONCRETE PAVING

SECTION A–A

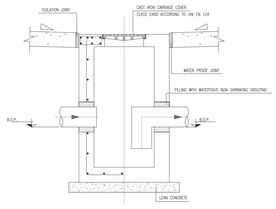

PLAN

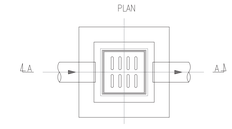

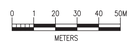

REV.	DESCRIPTION– *Descrizione*	PREP'D– *Red.*	CHK'D – *Contr.*	APPR'D –*Appr.*	PEM APPR'D.–*Appr.*	DATE – *Data*

----	----	----	----	----	----	----
----	----	----	----	----	----	----
1	ISSUED FOR USE	ACT	GCA	DMR	CMA	10/06/20
0	ISSUED FOR APPROVAL	ACT	GCA	DMR	CMA	05/06/20

REVISIONS – *Modifiche*

CONTRACTOR: VeniceLNG

COMPANY: TECHINT Engineering & Construction

JOB NUMBER: ----

COMPANY DOC. N°: ---- ---- ----

REV. REVISIONE: ----

PROJECT TITLE / *PROGETTO:*

VENICE LNG

FEED – VENICE LNG TERMINAL (PORTO MARGHERA)

TITLE / *TITOLO:*

—

STORMWATER DRAINAGE NETWORK

—

SCALE / SCALA:	FORM / FORMATO:	CONTRACTOR DOC. N°:	REV.	SHT.	OF
VAR	A0	0469-TITA-C-SD-001-001	01	*Fg.* 1	*di* 1

CAD FILE N°

La TECHINT si riserva la proprieta' di questo disegno con la proibizione di riprodurlo o trasferirlo a terzi senza autorizzazione scritta.
This document is property of TECHINT. Reproduction and divulgation forbidden without written permission.