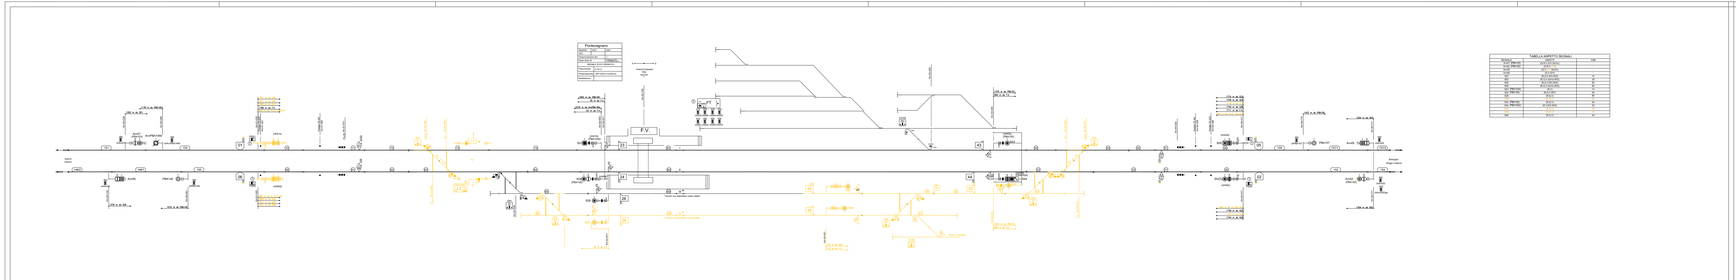

TABELLA ASPETTO SEGNALI		
