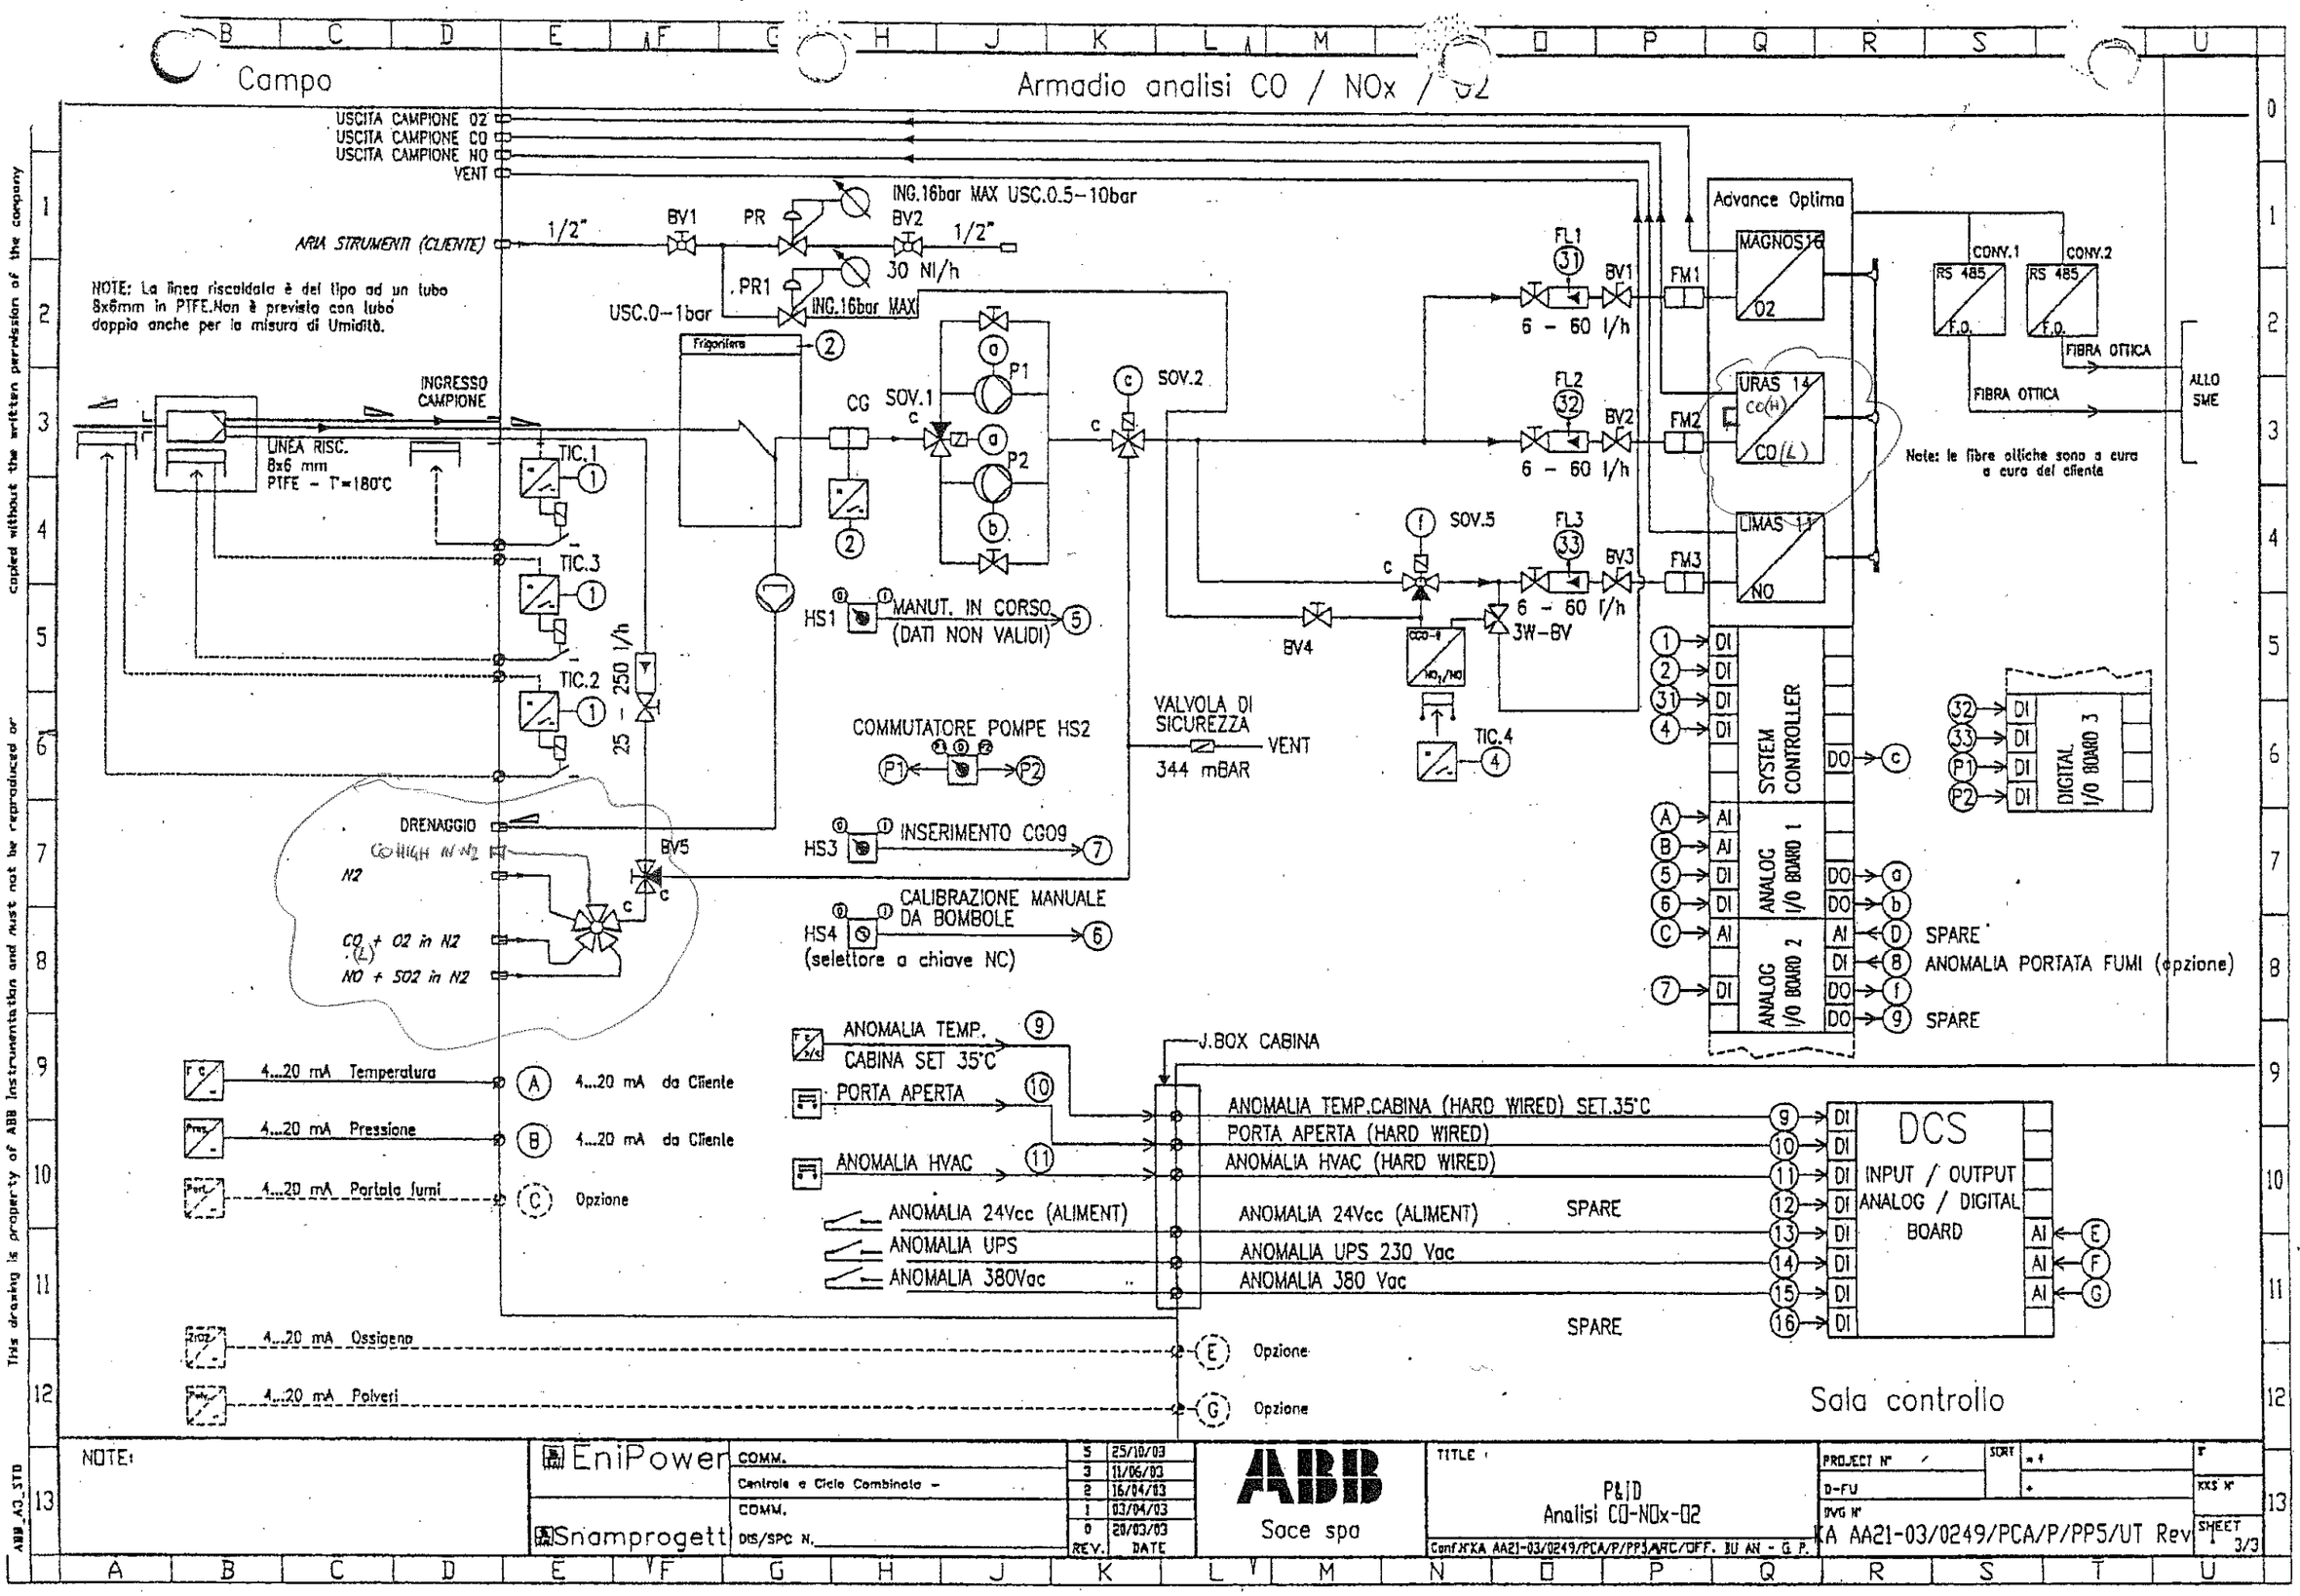

NOTE:

EniPower	COMM.	5	25/10/03	ABB Sace spa	TITLE: P&ID Analisi CO-NOx-O2
	Centrale e Ciclo Combinato -	3	11/06/03		
	COMM.	2	16/04/03		
Snamprogett	DIS/SPC N.	1	03/04/03		
		0	20/03/03		
		REV.	DATE		

Conf.N°KA AA21-03/0249/PCA/P/PP5/ARC/OFF. BU AN - G.P.

PROJECT N° / SORT / D-FU / DWG N° KA AA21-03/0249/PCA/P/PP5/UT Rev / SHEET 3/3

This drawing is property of ABB Instrumentation and must not be reproduced or copied without the written permission of the company

ABB_A3_STD