

VERTICE C1 – FONDO SCAVO APPALTI  
VITALI SPA

COORDINATE GAUSS-BOAGA – FUSO OVEST (EPSG:3003)  
NORD: 5057851,363 - EST: 1537250,514

COORDINATE ED50 / UTM Zone 32N (EPSG:23032)  
NORD: 5058029,57 – EST: 537305,42



VERTICE C2 – FONDO SCAVO BETTONI  
SPA

COORDINATE GAUSS-BOAGA – FUSO OVEST (EPSG:3003)  
NORD: 5046511,950 - EST: 1585256,373


COORDINATE ED50 / UTM Zone 32N (EPSG:23032)  
NORD: 5046690,49 – EST: 585310,78



VERTICE C3 – FONDO SCAVO BOSCHINI  
FRANCO

COORDINATE GAUSS-BOAGA – FUSO OVEST (EPSG:3003)  
NORD: 5053620,252 - EST: 1544701,637

COORDINATE ED50 / UTM Zone 32N (EPSG:23032)  
NORD: 5053798,54 – EST: 544756,48

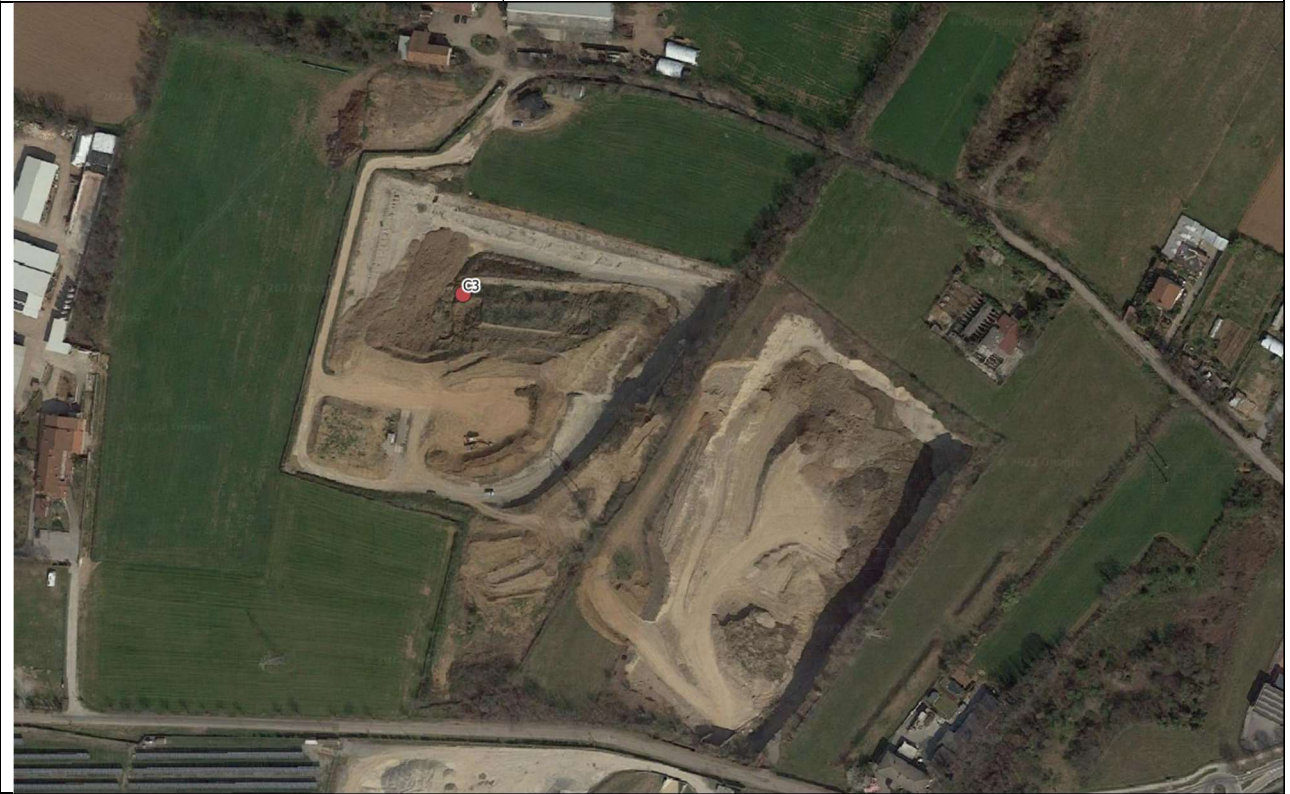



VERTICE C4 – FONDO SCAVO  
ECOLOGICA CAMUNA

COORDINATE GAUSS-BOAGA – FUSO OVEST (EPSG:3003)  
NORD: 5044600,928 - EST: 1581794,300

COORDINATE ED50 / UTM Zone 32N (EPSG:23032)  
NORD: 5044779,48 – EST: 581848,76

