
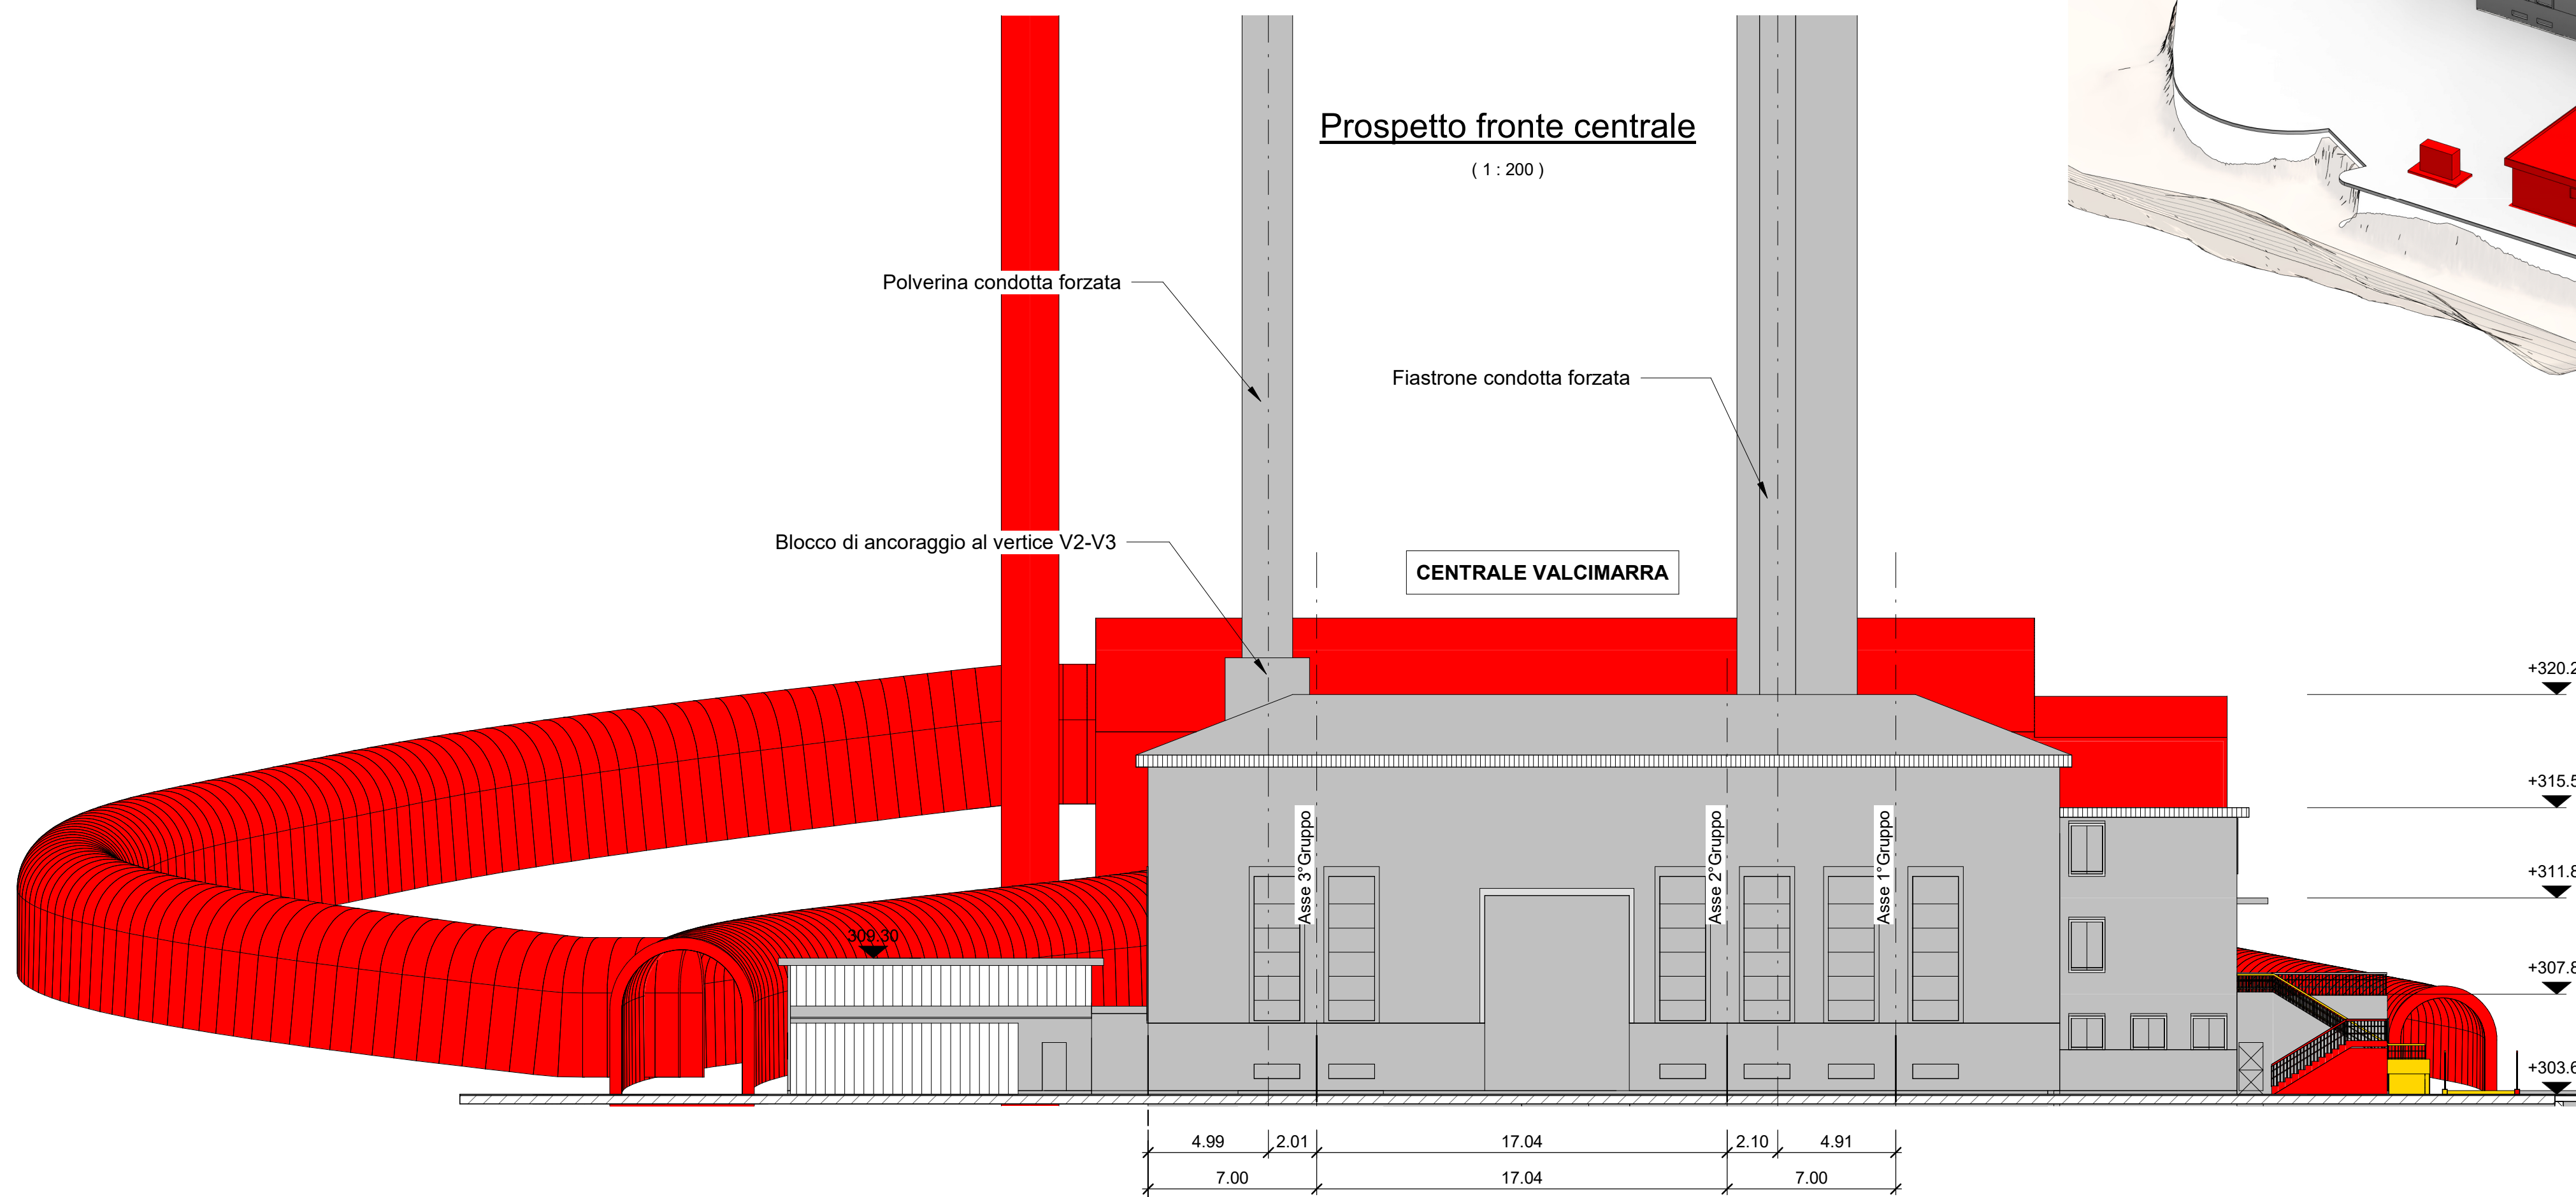


Vista 3D

Legenda :

- Demolizioni
- Nuove Costruzioni
- Stato di fatto

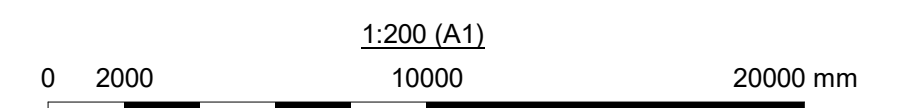

00	29/07/2022	Emissione per revisione cliente	D.Longo / A. Guglielmi	F. Maugliani / C. Piccini	A. Balestra
REV	DATE	DESCRIPTION	PREPARED	CHECKED	APPROVED
CONTRACTOR'S LOGO		PROJECT: <b>Impianto di Valcimarra II</b> <b>Installazione di nuovo gruppo reversibile</b>			
<b>Lombardi</b>		FILE NAME (EGP CODE): GRE.EEC.D.99.IT.H.17168.00.048.00	LOMBARDI CODE: 2021.0047.008-GC-PSP-DW-047		
<b>enel</b> Green Power		CLASSIFICATION: <b>Public</b>	FORMAT: <b>A1</b>	SCALE: <b>1:100</b>	PLOT SCALE: <b>1:1</b>
HGT Design & Execution <b>EGP VALIDATION</b>		UTILIZATION SCOPE: <b>Progetto Definitivo per Autorizzazione</b>		TITLE: <b>Comparativo Prospetto versante e centrale</b>	
VALIDATED BY: <b>G.RIPPELLINO</b>		EGP CODE			
VERIFIED BY:		GROUP	FUNCTION	TYPE	ISSUER
COLLABORATORS:		GRE EEC	D 9 9 I	T H 1 7 1 6 8 0 0 0 4 8 0 0	

This document is property of Enel Green Power SpA. It is strictly forbidden to reproduce this document, in whole or in part, and to provide to others any related information without the previous written consent by Enel Green Power SpA.