


Pianta sottostazione e vie cavi

(1 : 250 )

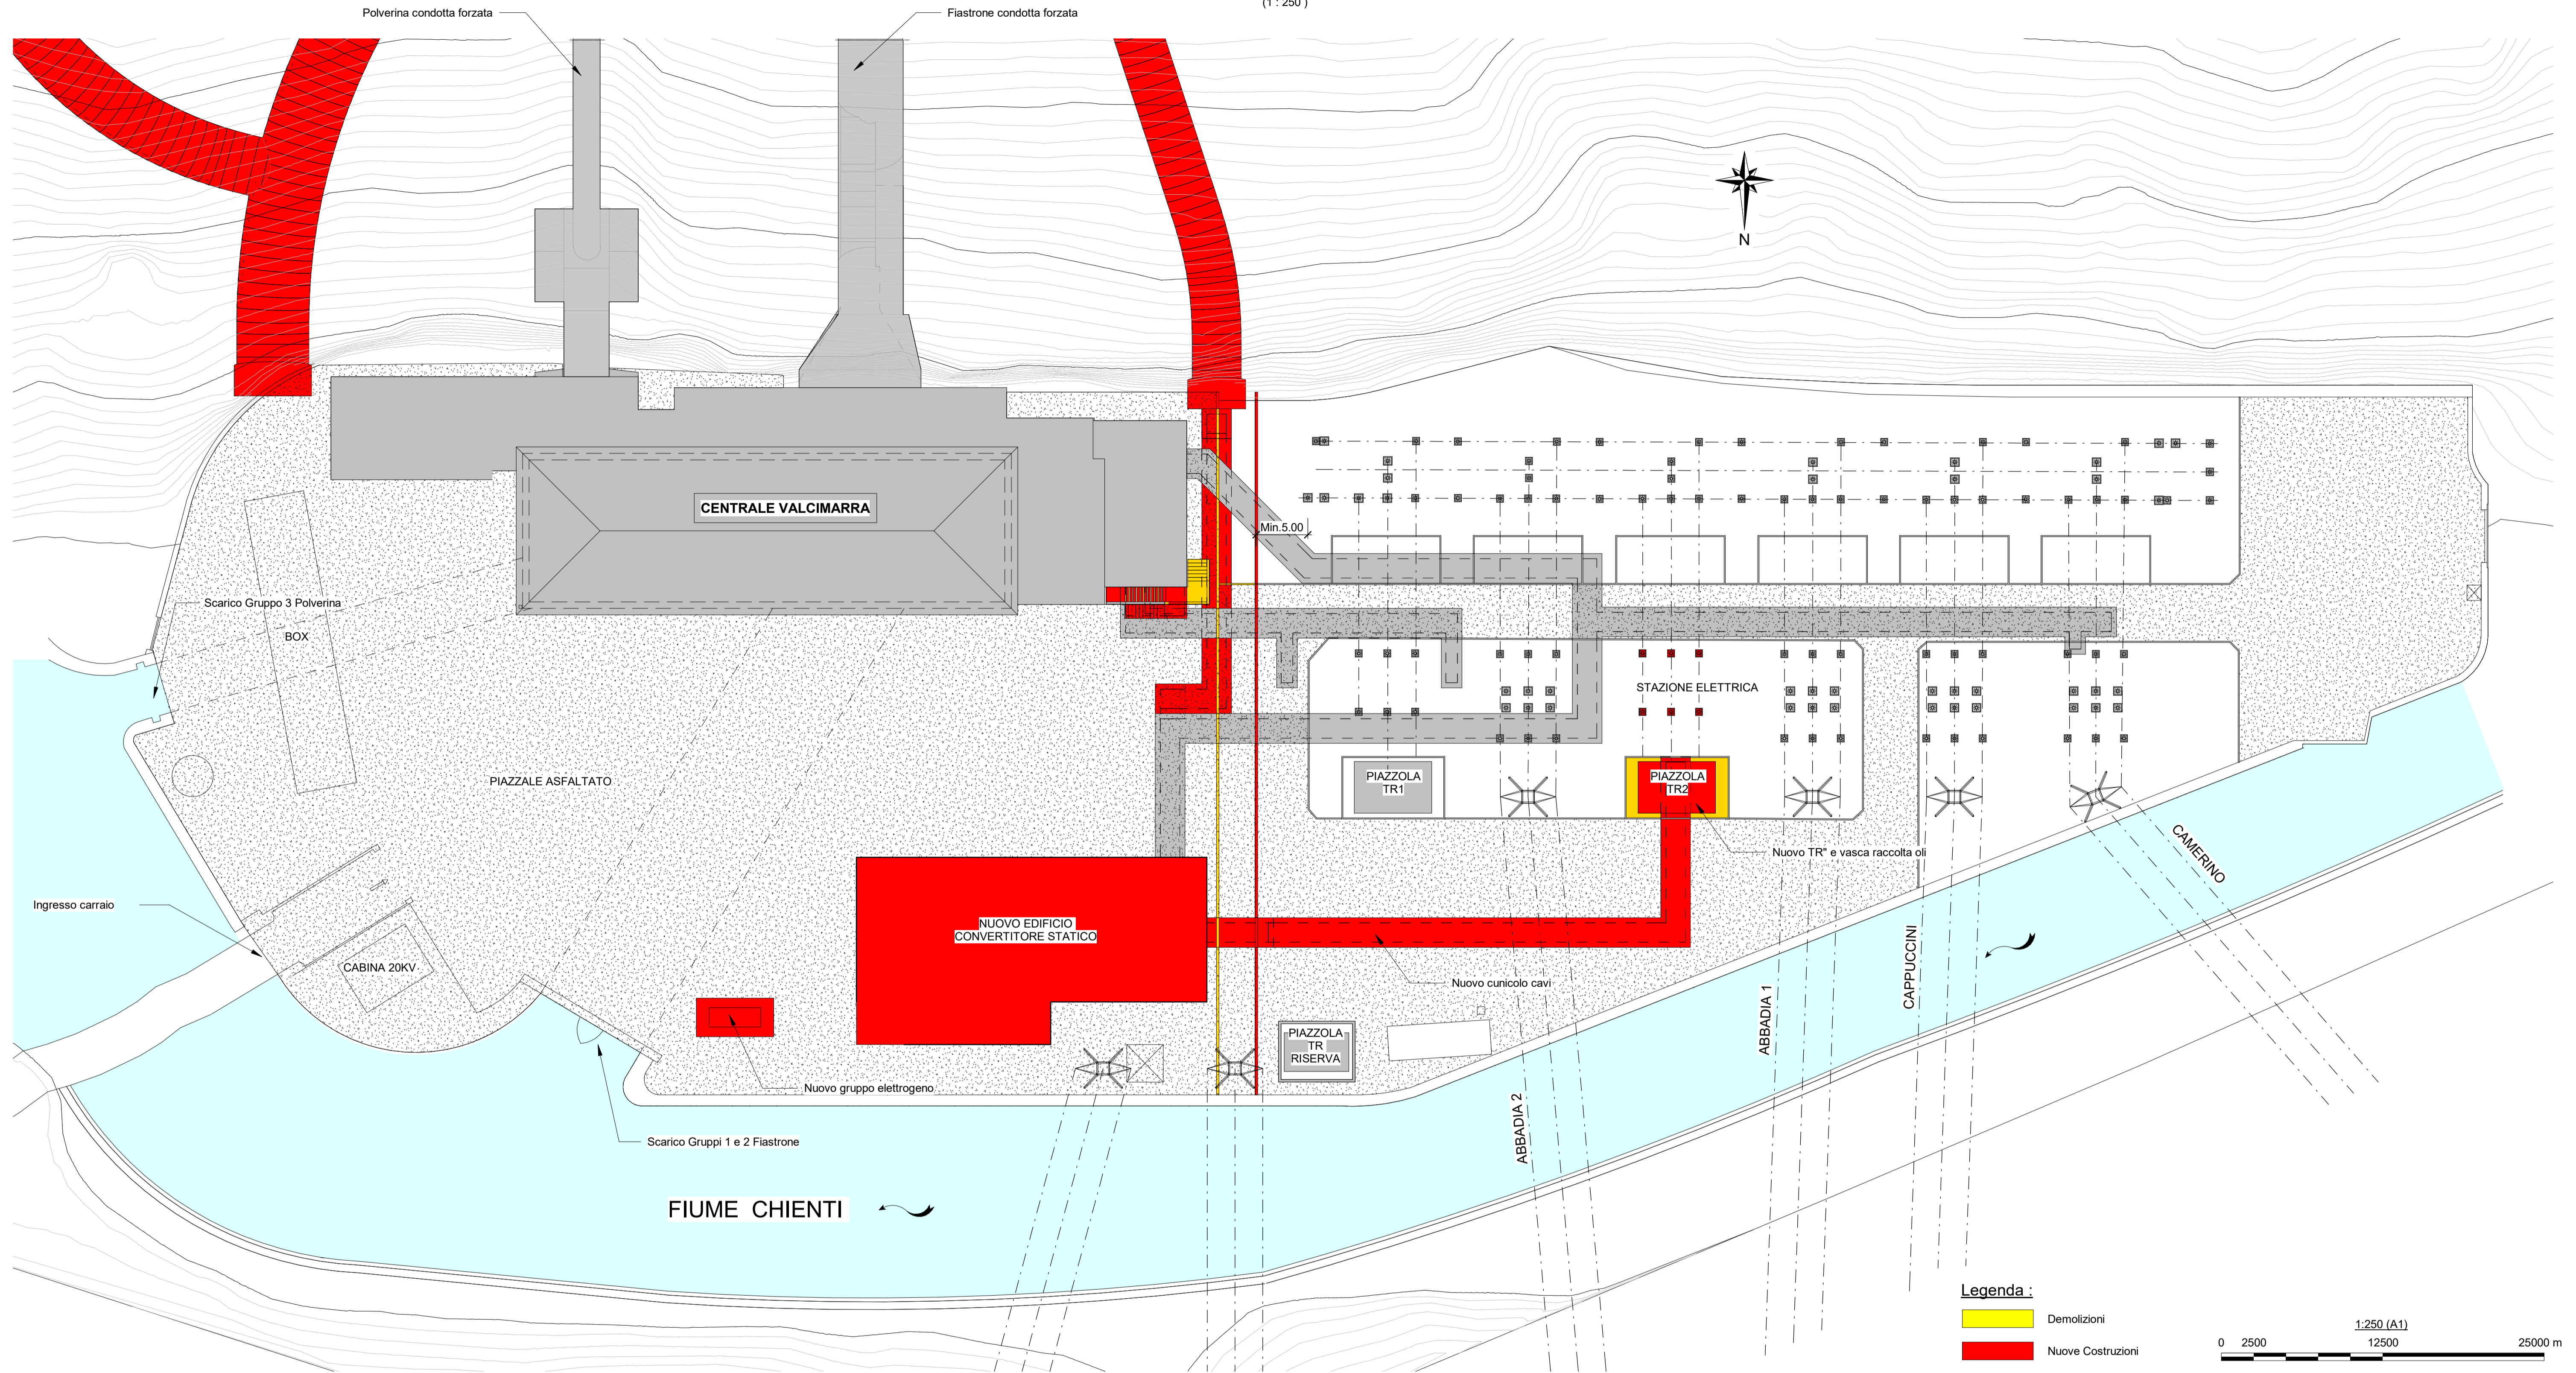

Legenda :

	Demolizioni	<p>1:250 (A1)</p>
	Nuove Costruzioni	
	Stato di fatto	

00	29/07/2022	Emissione per revisione cliente	D.Longo / A. Guglielmi	F. Maugliani / C. Piccinin	A. Salestra						
REV	DATE	DESCRIPTION	PREPARED	CHECKED	APPROVED						
		PROJECT: <b>Impianto di Valcimarra II</b> <b>Installazione di nuovo gruppo reversibile</b>									
		FILE NAME (EGP CODE): <b>GRE.EEC.D.99.IT.H.17168.00.049.00</b>	LOMBARDI CODE: <b>2021.0047.008-HM-CAB-DW-048</b>								
HGT Design & Execution <b>EGP VALIDATION</b>		CLASSIFICATION: <b>Public</b>	FORMAT: <b>A1</b>	SCALE: <b>1:100</b>	PLOT SCALE: <b>1:1</b>						
UTILIZATION SCOPE: <b>Progetto Definitivo per Autorizzazione</b>		TITLE: <b>Comparativo Sottostazione</b>									
VALIDATED BY: <b>G. RIPPellino</b>		EGP CODE <b>GRE EEC D 9 9 I T H 1 7 1 6 8 0 0 0 4 9 0 0</b>									
VERIFIED BY:		GROUP	FUNCTION	TYPE	ISSUER	COUNTRY	TEC.	PLANT	SYSTEM	PROGRESSIVE	REVISION
COLLABORATORS:		GRE	EEC	D	9	9	I	T	H	1	7
COLLABORATORS:		1	7	1	6	8	0	0	0	4	9

This document is property of Enel Green Power SpA. It is strictly forbidden to reproduce this document, in whole or in part, and to provide to others any related information without the previous written consent by Enel Green Power SpA.