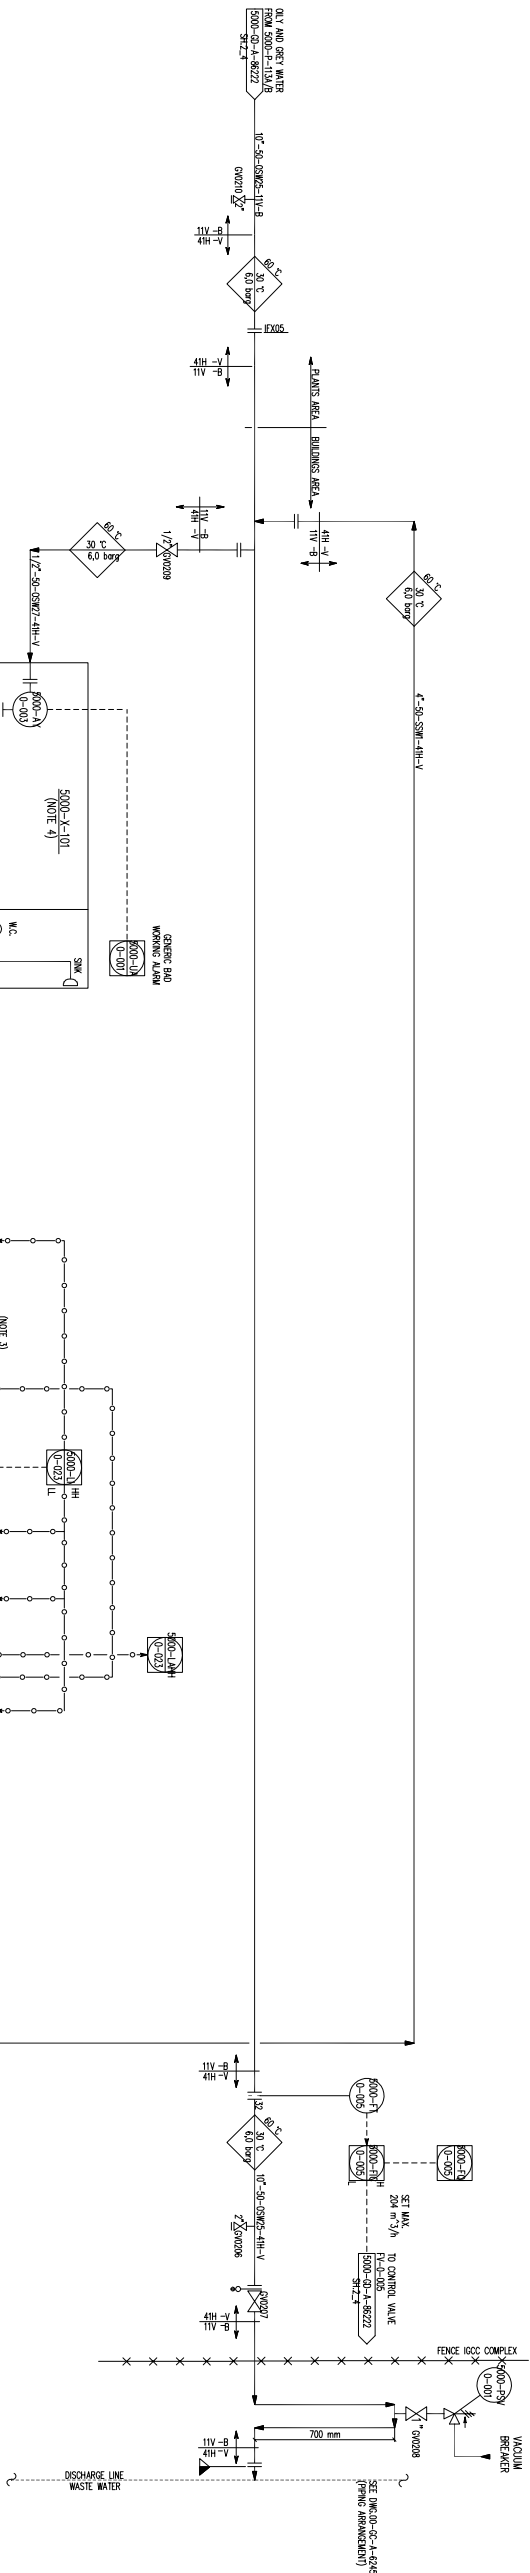



[illegible]

GENERAL NOTES

- 1) FOR NOTES SYMBOLS & DETAILS SEE DWG.0-50-01.
- 2) ALL INSTRUMENT TACS SHOWN ON THIS PAID HAVE DIGITS "5000" AS A PREFIX
- 3) FOR SAMPLE POINT ARRANGEMENTS SEE DWG.N° 00-CA-A-60063.

- 1) LSI START 1st PUMP A OR B, LSHI START 2nd PUMP A OR B, LSI STOP BOTH PUMPS
- 2) DELETED.
- 3) START/STOP COMMANDS AND STATUS RUN, INDICATION AVAILABLE ON A UNIQUE DISC POINT. LOCAL CONTROL STATION IS ALSO PROVIDED.
- 4) AUTOMATIC SAMPLING STATION (CONTIGENERATED THER) PACKAGE UNIT.

10			CONTR.	APPR.

Questo disegno non può essere né riprodotto né comunicato a terzi, senza l'approvazione della ISAB Energy.

