


103.6

MASSERIA TARANTINO NUOVA

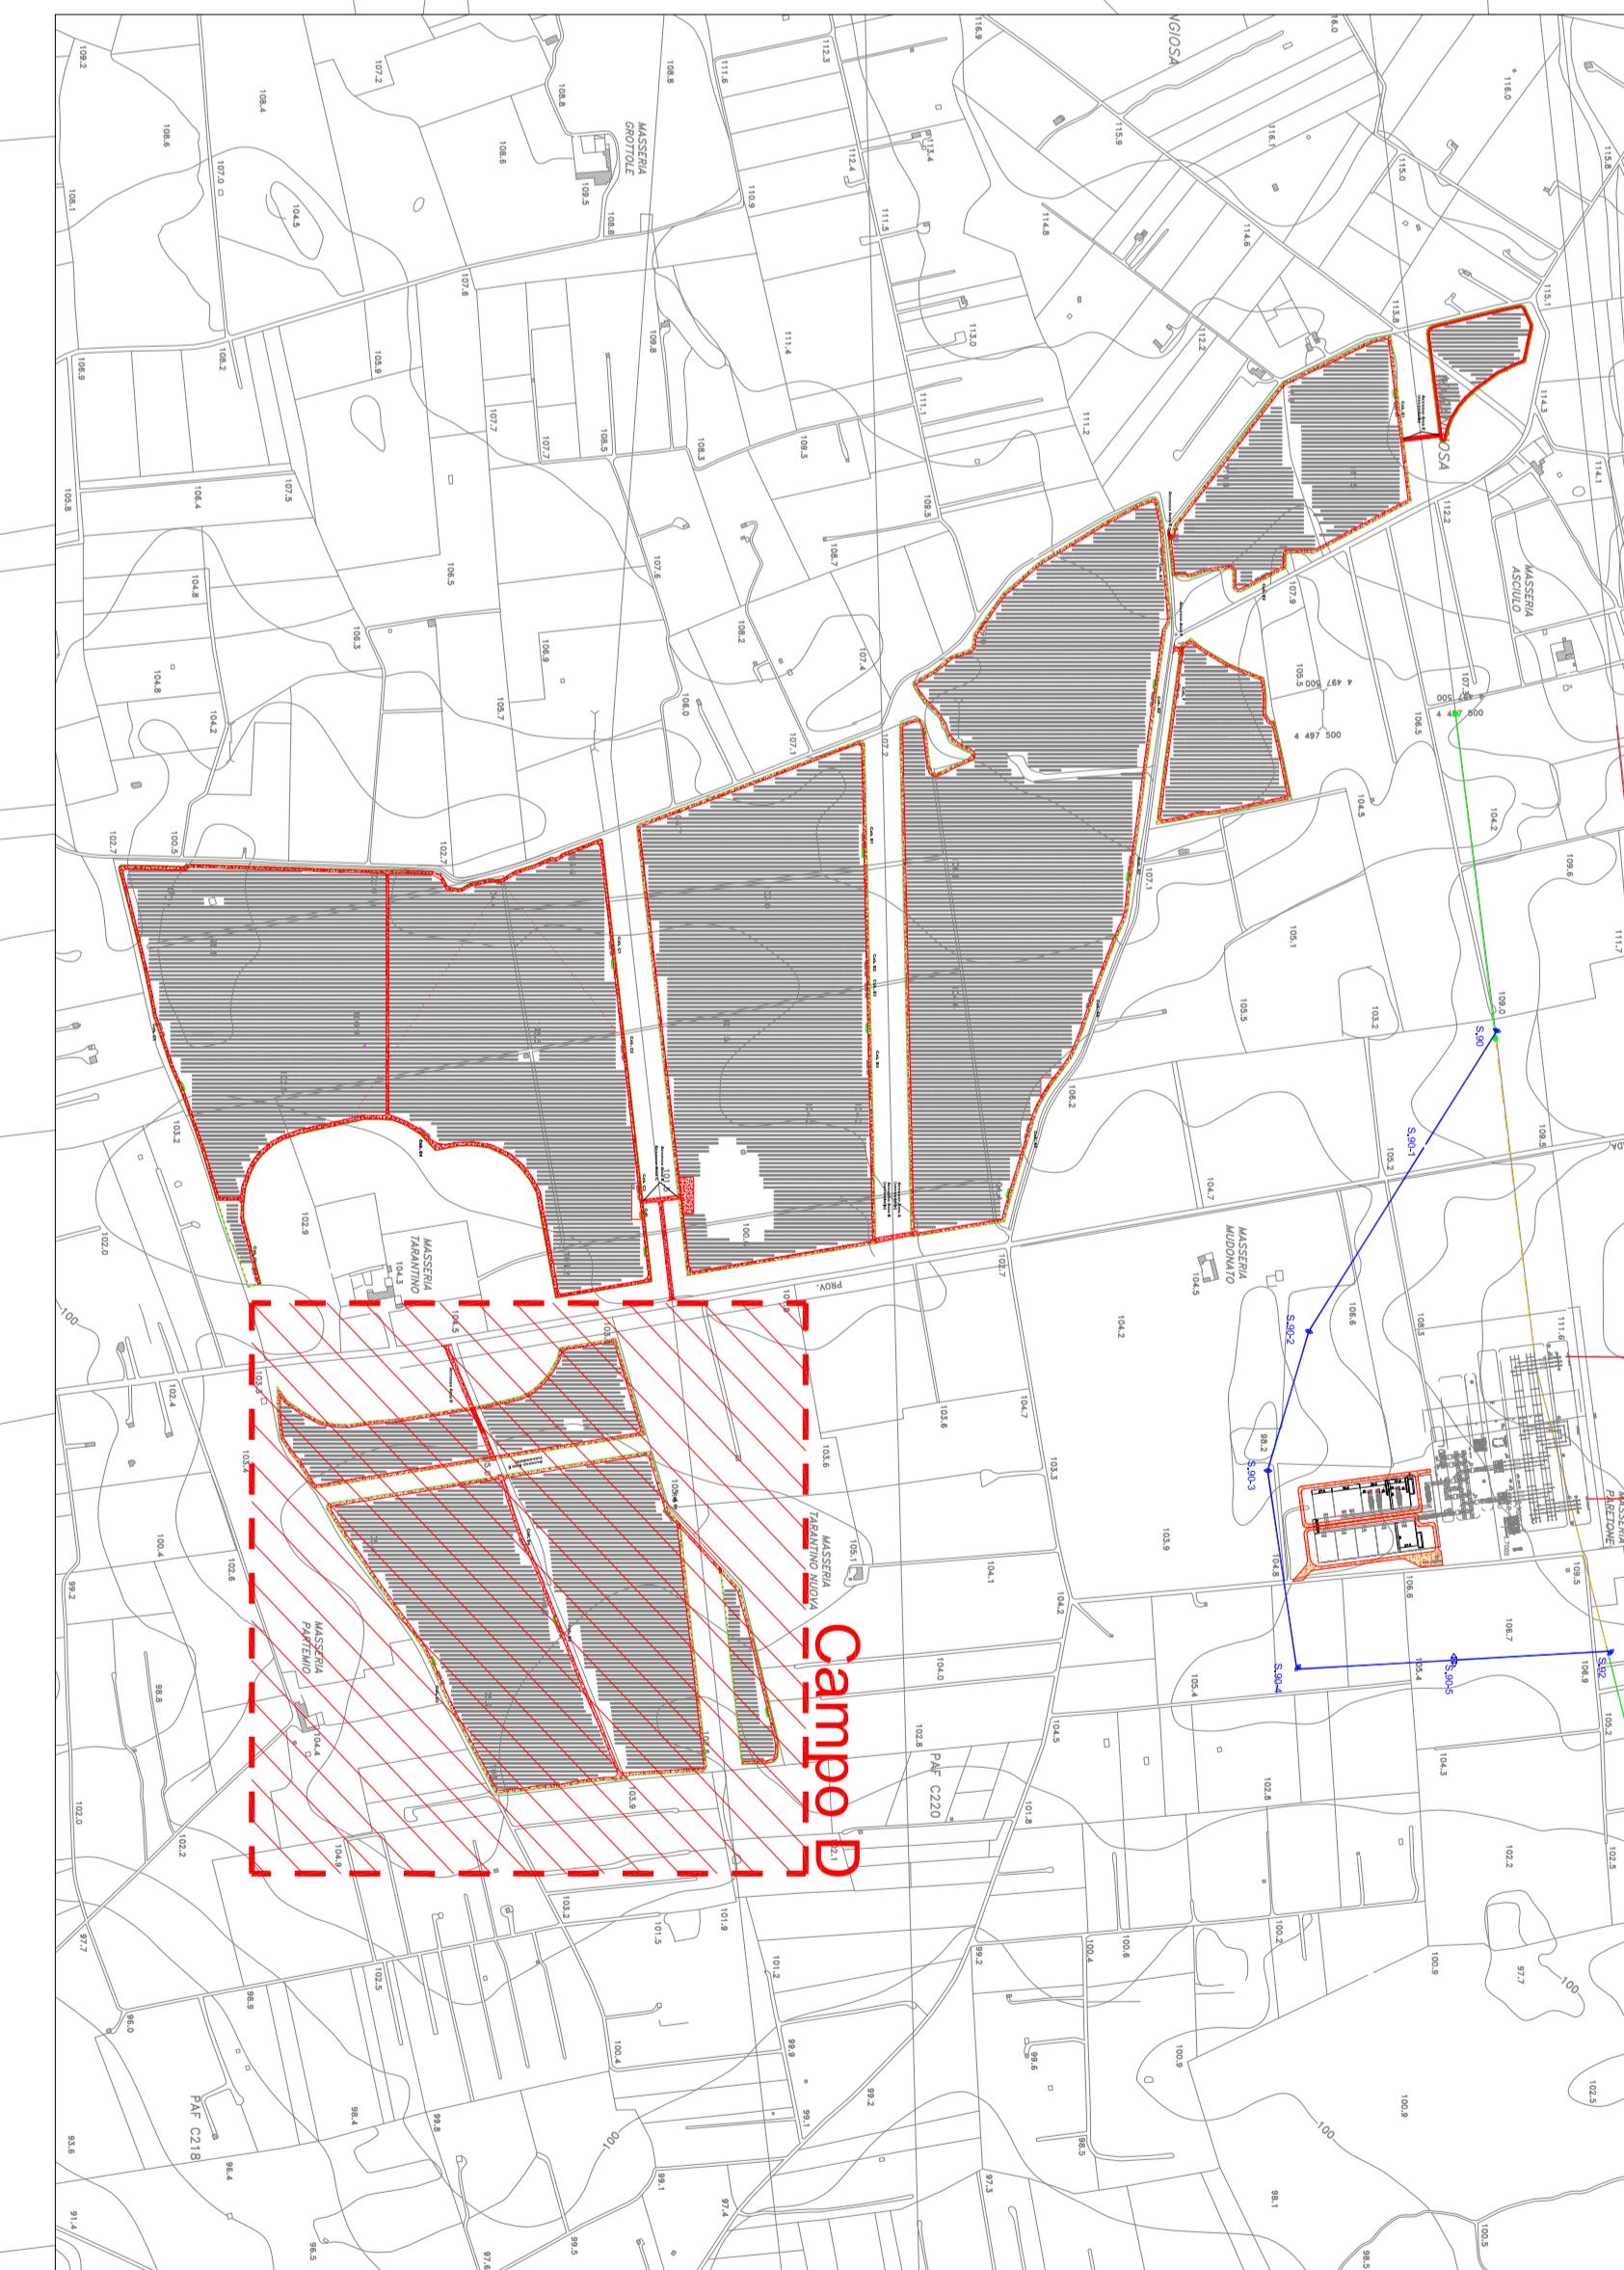

101.5

103.9

103.2

102.5

103.6

103.4

105.9

105.0

103.3

104.4

104.9

102.5

98.9

MASSERIA PARTEMIO

S. P. 46

30,00

103.3

103.4

4.5

103

105

Cab. D1

102.5

103.9

103.2

101.5

105.4

Cab. D2

105.9

Cab. D3

105.0

Accesso Area E (secondario)

Accesso Area D

5.0
















































