

Legenda Difetti

Table with columns: Descrizione, Simbolo, Codici. Lists structural defects like Cavità, Fessure chiuse, Fessure aperte, Zone alterate, Alterazioni, Suono sordo, Venute acqua.

Table with columns: Descrizione, Simbolo, Codici. Lists water leaks like Infiltrazione con fessure, Infiltrazione fessure, Corrosione, etc.



Classification tables for IQQA - Canto Civile and IQQA - Azione dell'acqua. Includes categories like 'In buono stato apparente', 'Difetti superficiali', etc.

LEGENDA SEZIONI INTERPRETATIVE INDAGINI GEORADAR

Legend for GPR sections with symbols for Centina, Spessore investimento, etc.



NOTE: LE PROGRESSIVE RIPORTATE NEL PRESENTE ELABORATO SONO RIFERITE A INIZIO GALLERIA NATURALE (P.K. 0+225.12).

PK 2+000 - 2+200

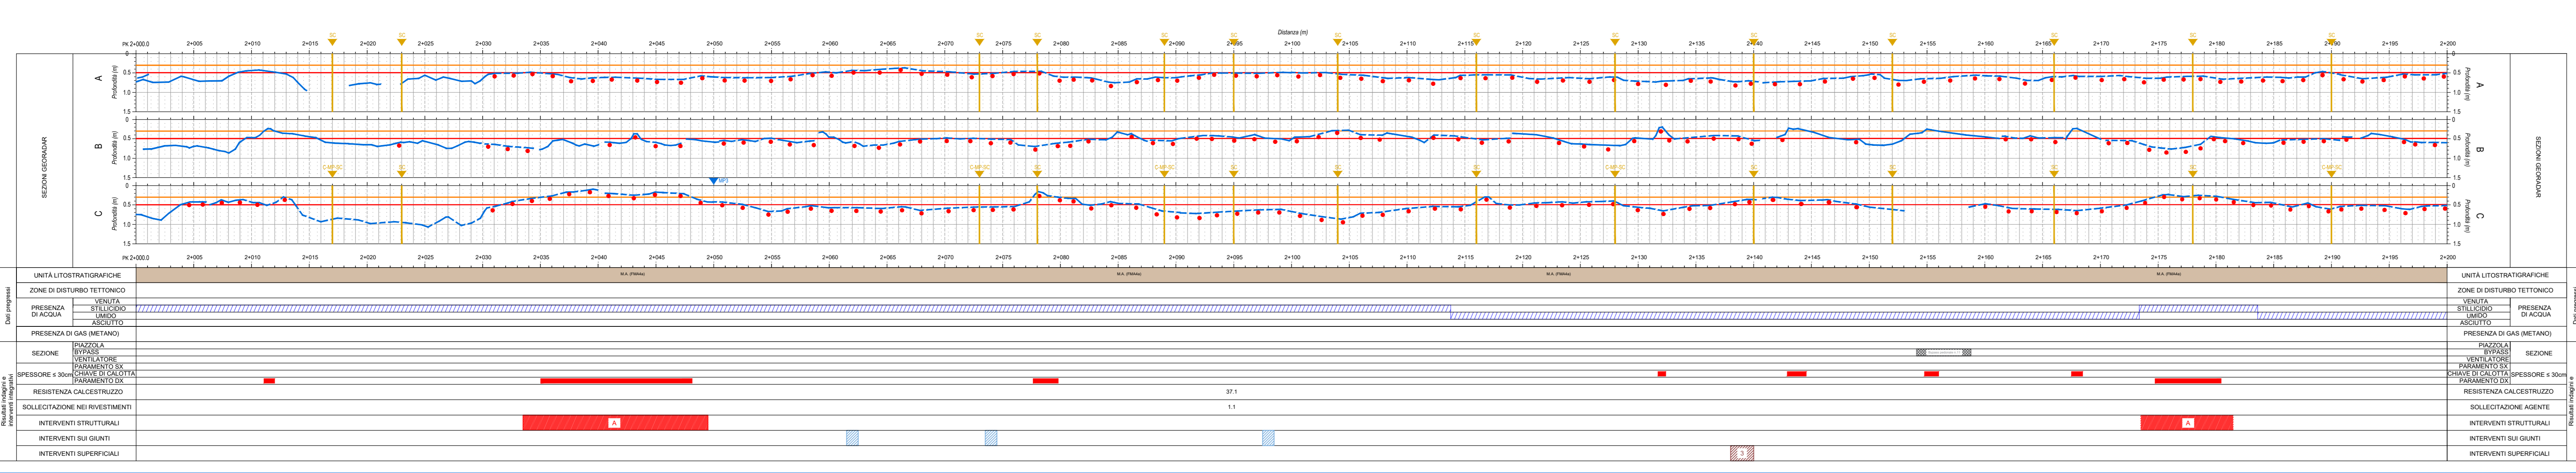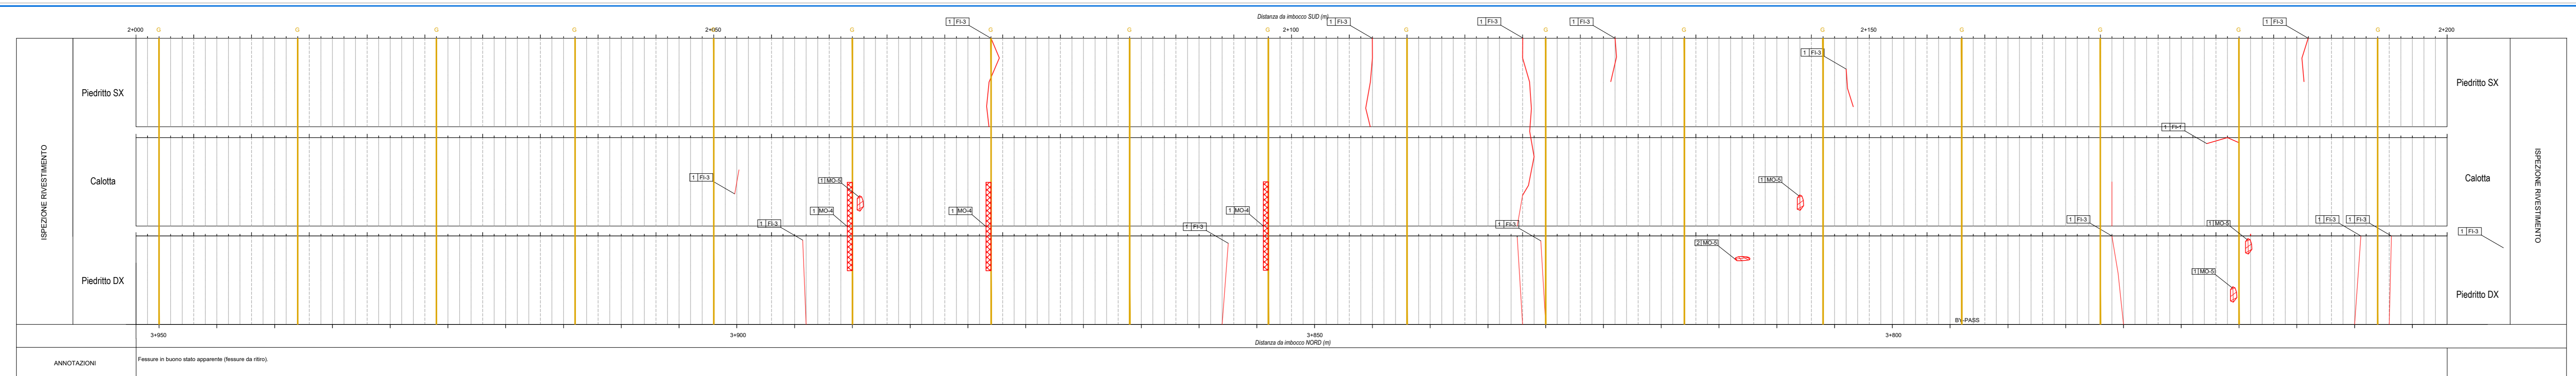


PK 2+200 - 2+400

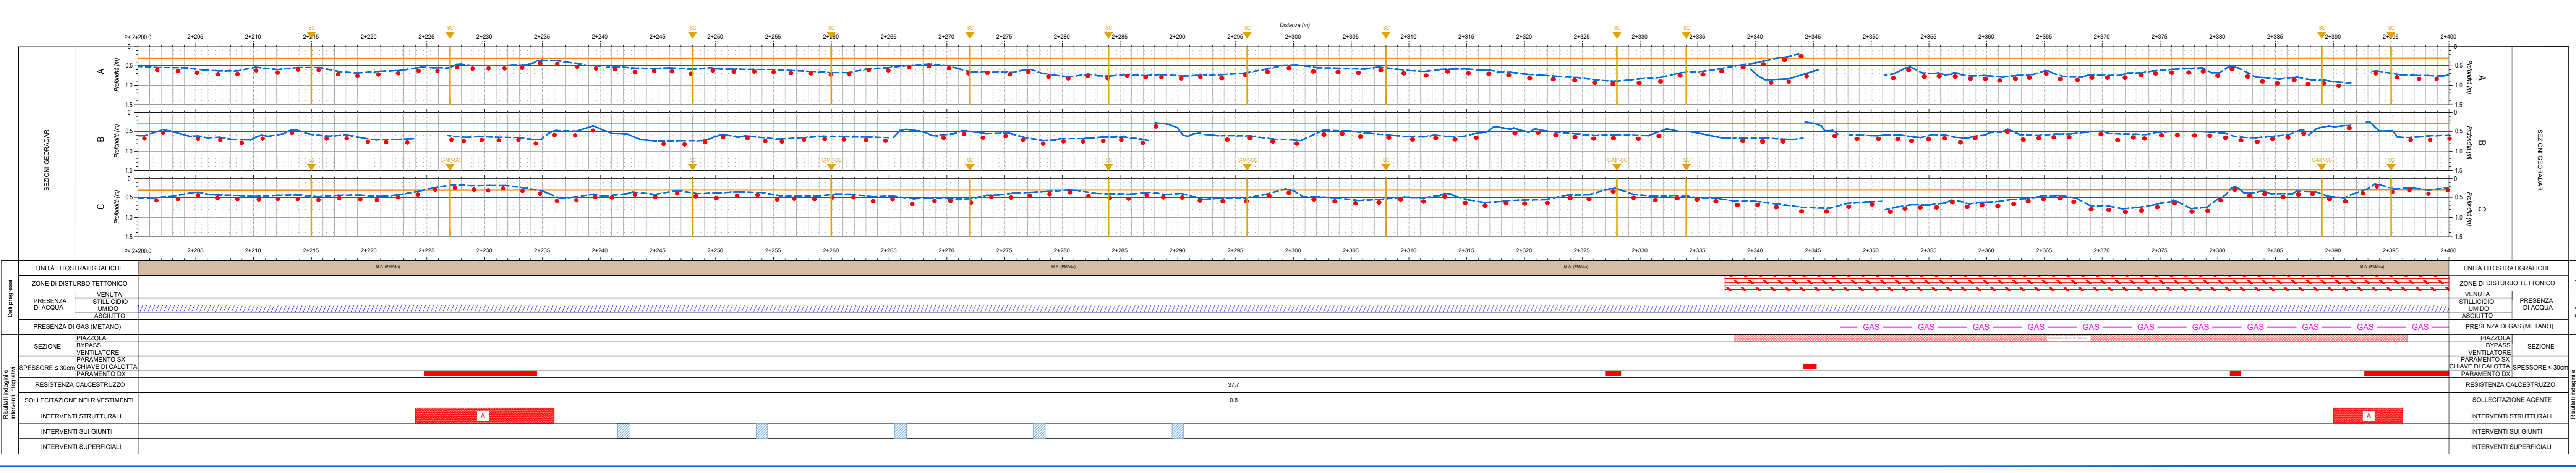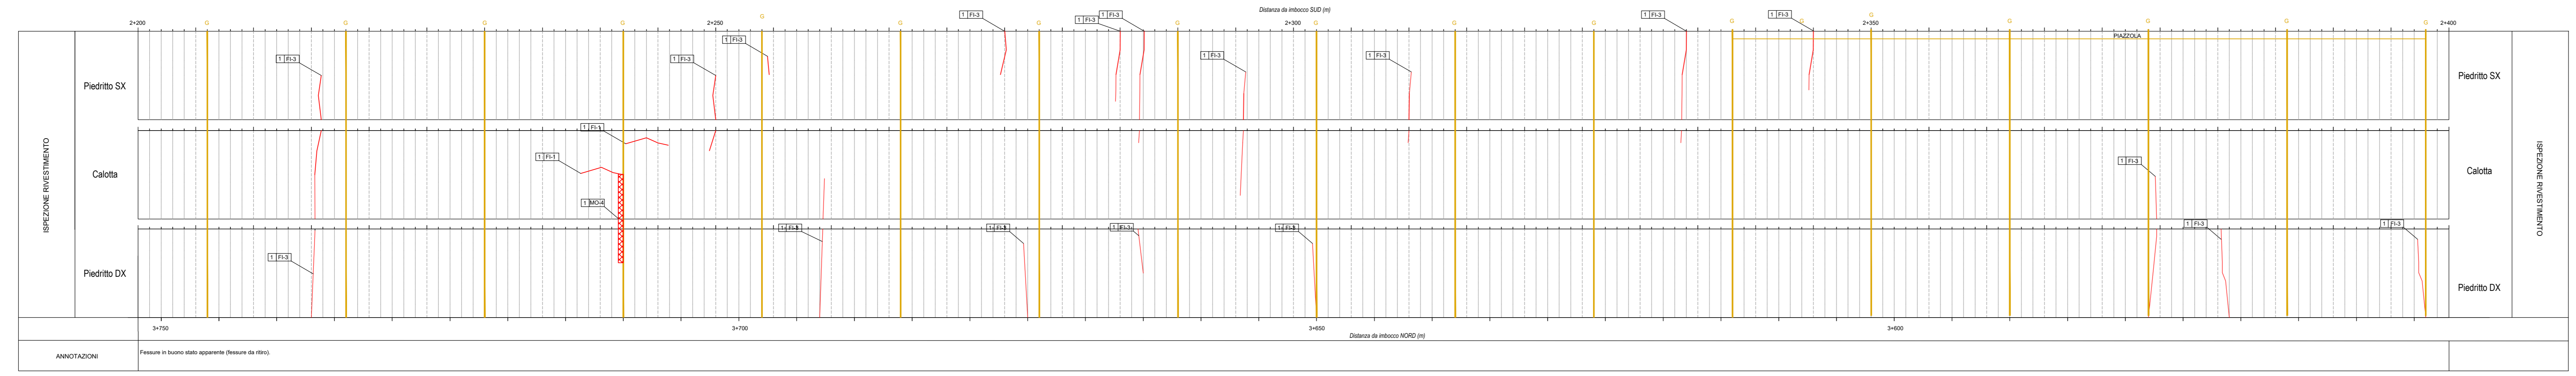

Technical specifications table for PK 2+200-2+400, including material types, thicknesses, and reinforcement details.

Project information block for 'ITINERARIO INTERNAZIONALE E78 S.G.C. GROSETO - FANO'. Includes logos for Sanas, PPO, and sinergo, project details, and a signature.

Project data table with columns: CODICE PROGETTO, NOME FILE, REVISIONE, SCALA, etc.