

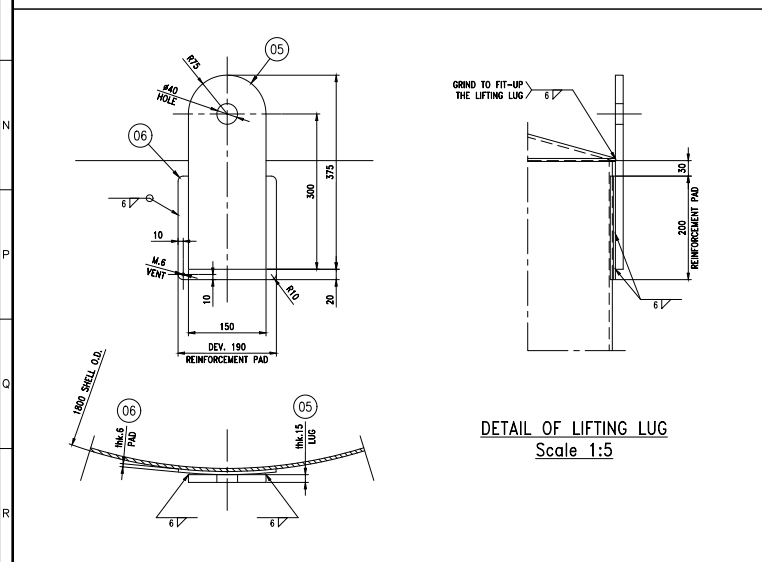



ELEVATION
(REFER PLAN VIEW FOR TRUE ORIENTATION)

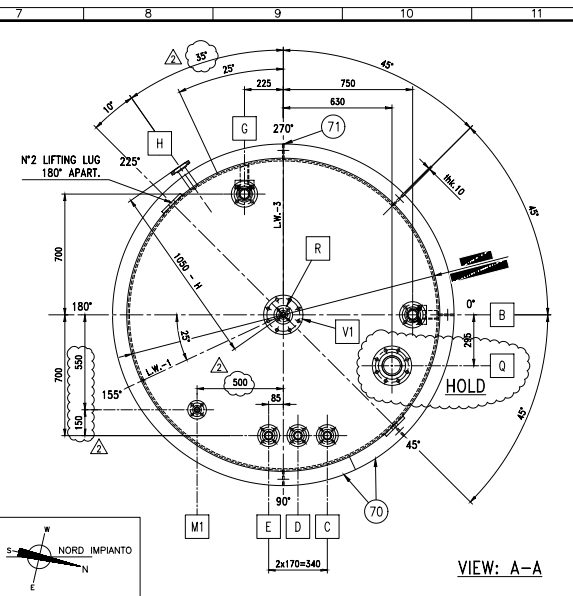



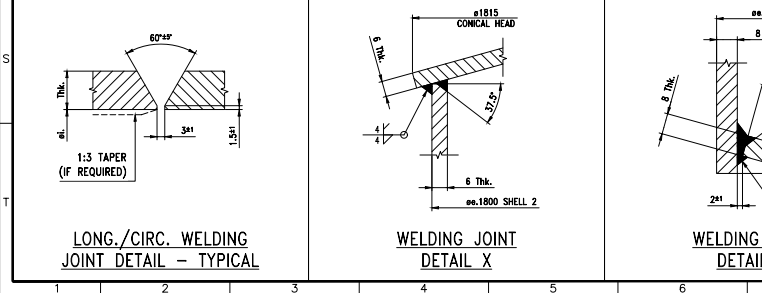



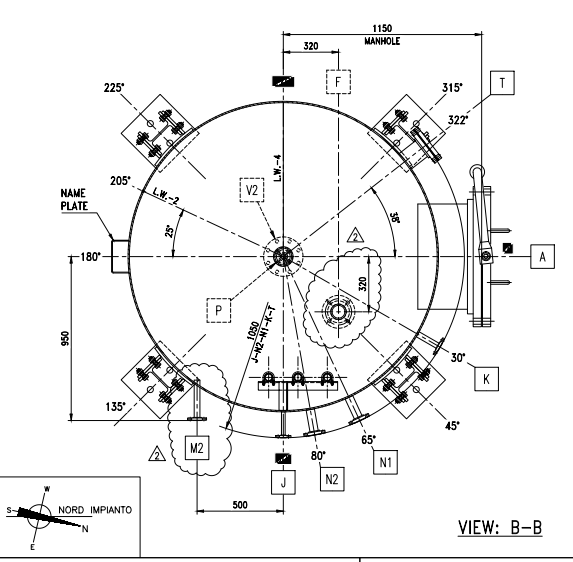


VIEW: B-B

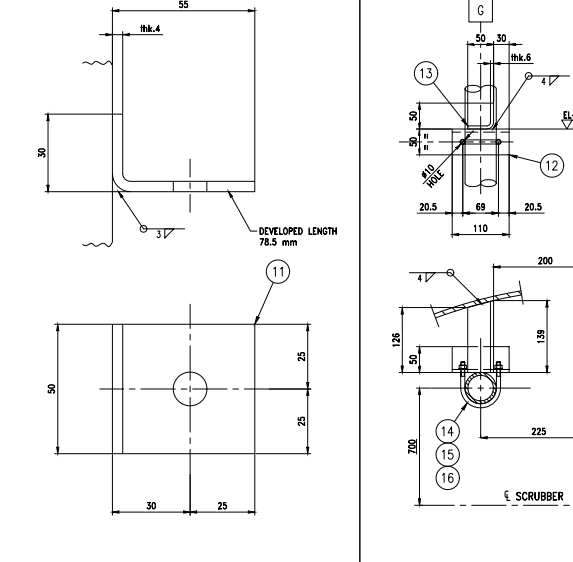


DETAIL OF EARTHING LUG
Scale 1:1

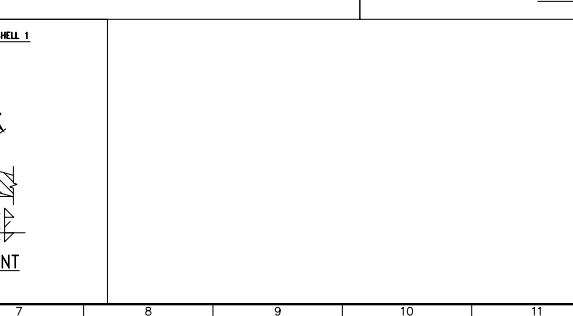


DETAIL OF PIPE SUPPORT
Scale 1:5

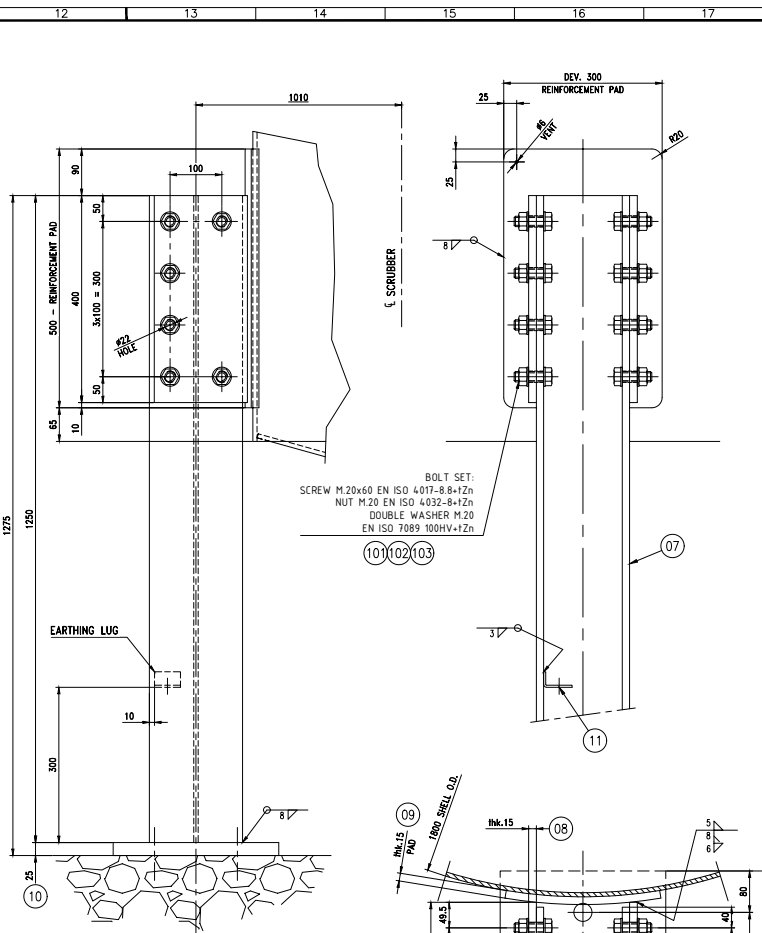

DETAIL OF LEG SUPPORT
Scale 1:5

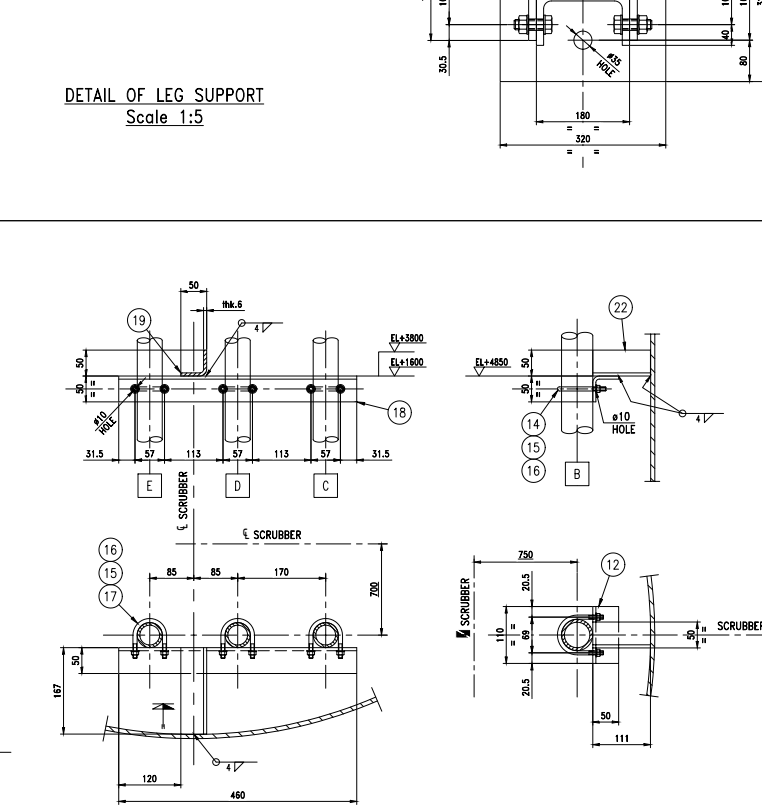

DETAIL OF NAME PLATE
Scale 1:5

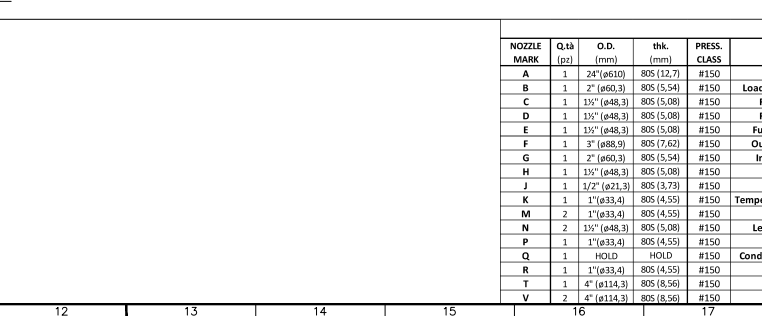

BILL OF MATERIAL									

IMPORTANT: THE DIMENSION (X) OF FILLET WELDS MUST BE 0.7 TIMES THE LOWER THICKNESS TO BE JOINED, UNLESS OTHERWISE INDICATED.

GENERAL NOTES

- ALL BOLT HOLES TO STRADDLE THE NORMAL VESSEL CENTERLINES OR THEIR PARALLELS UNLESS NOTED.
- AFTER HYDROSTATIC TEST, THE VESSEL SHALL BE DRAINED AND THOROUGHLY CLEANED TO REMOVE ALL GREASE, SCALE, AND OTHER FOREIGN DEBRIS.
- ALL REINFORCEMENT PADS ARE TO BE TESTED PRIOR TO HYDRO @ 1 bar USING DRY AIR AND SOAP SUDS.
- LEAVE TEST HOLES OPEN DURING HYDROTEST, FILL WITH HEAVY GREASE PRIOR TO SHIPPING.
- WHEN POSSIBLE AND ACCESSIBLE, FULL PENETRATION WELDS MAY, WITH CONCURRENCE OF OCP, BE BACK WELDED.
- FABRICATION TOLERANCES AS PER EN 13445-4.
- MANWAY COVERS SHALL BE SHIP TRIAL FIT AND DAVIT'S NUT ADJUSTED. A TEMPORARY 3MM RUBBER SHIPPING GASKET SHALL BE INSTALLED PRIOR TO CLOSURE AND BOLT UP. SUPPLIER TO NOTE ON SHIPPING DRAWINGS THAT THIS GASKET IS FOR SHIPPING ONLY AND MUST BE REPLACED WITH THE SERVICE GASKET PRIOR TO START-UP.
- ALL SEAM WELDS TO BE PICKLED AND PASSIVATED.
- ALL STAINLESS STEEL BOLTS TO BE LUBRICATED BEFORE INSTALLATION WITH ANTI-SEIZE PASTE LOTITE 8012 OR 8023.

DATI DI PROGETTO / DESIGN DATA			
SIGLA	TAG	76HS228-BB180	
CODICE DI PROGETTO	DESIGN CODE	EN 13445	
CATEGORIA APPARECCHIATO	EQUIPMENT CLASS	SOUND ENGINEERING PRACTICE	
CLASSE DEI CONTROLLI	TESTING GROUP	3b EN 13445-5	
MARCATURA	MARKING	NO	
NUMERO DI FABBRICA	SERIAL NUMBER	2822	
ANNO DI COSTRUZIONE	FABRICATION YEAR	2022	
PRESSIONE DI PROVA	DESIGN PRESSURE INT/EXT	0.845/6.085 MPa	
PRESSIONE OPERATIVA	OPERATING PRESSURE	ATM	
PRESSIONE DI PROVA	TEST PRESSURE	0.867 MPa	
TEMPERATURA DI PROGETTO	DESIGN TEMPERATURE	50 °C	
TEMPERATURA MINIMA DI PROGETTO	MINI	0 °C	
FLUIDO	FLUID	WATER + NH3	
SOVRAPRESSORE DI CORROSIONE	CORROSION ALLOWANCE	0.85	
EFFICIENZA DEI GIUNTI	JOINT EFFICIENCY	0.85	
PESO A VUOTO	EMPTY WEIGHT	2800 kg	
PESO IN ESERCIZIO	OPERATING WEIGHT	13000 kg	
PESO IN PROVA IDRAULICA	TEST WEIGHT	14600 kg	
CAPACITA	CAPACITY	11.7 m³	
TRATTAMENTO SUPERFICIALE INT/EST	SURFACE FINISHING INT/EXT	NO	
ISOLAMENTO	INSULATION	THIRD PARTY	

REV	DATE	DESCRIPTION	ISSUED	CHKD	APPD
2	22/09/2022	REVISED WHERE INDICATED	DZ	SB	AM
1	28/07/2022	REVISED WHERE INDICATED	DZ	SB	AM
0	29/06/2022	FIRST ISSUE	DZ	SB	AM

THIS DRAWING HAS BEEN FURNISHED BY NOTOTERIKSEN. THE INFORMATION KNOW HOW, AND ALL NEW OR PATENTABLE FEATURES ARE THE PROPERTY OF NOTOTERIKSEN AND MUST NOT BE COPIED OR REPRODUCED WITHOUT PERMISSION. THE FOREGOING IN NO WAY APPLIES TO DESIGN AND FEATURES WHICH ARE OUR CUSTOMER'S PROPERTY.



TITLE:
AMMONIA SCRUBBER TANK
ASSEMBLY AND DETAILS DRAWINGS

PURCHASER: ENEL PRODUZIONE S.p.A.
OWNER: ENEL PRODUZIONE S.p.A.

PROJECT: Chemical quantities of SR - Ammonia solution storage
Power Plant "Andrea Palladio" Fusina (VE)

REVISION: 02
JOB NO: 223530-00-AGT501
CODE: 1-2
SHT: 02
REV: 02
FE: 02

DRAWINGNUMBER: 223530-00-AGT501
SCALE: 1:15

APPROVATO: 26/09/22
EAG: BEC
SUPERVISOR: 26/09/22
EAG: BEC

DOCUMENTO: PBCFUS58341
DOCUMENT NO: PBCFUS58341

PROGETTO: FUSINA
CAPACITY MARKET ITALY


CLIENT: ENEL PRODUZIONE S.p.A.

PRODOTTO: PBCFUS58341

REVISION: 02


SCALE: 1:15

NOTOTERIKSEN

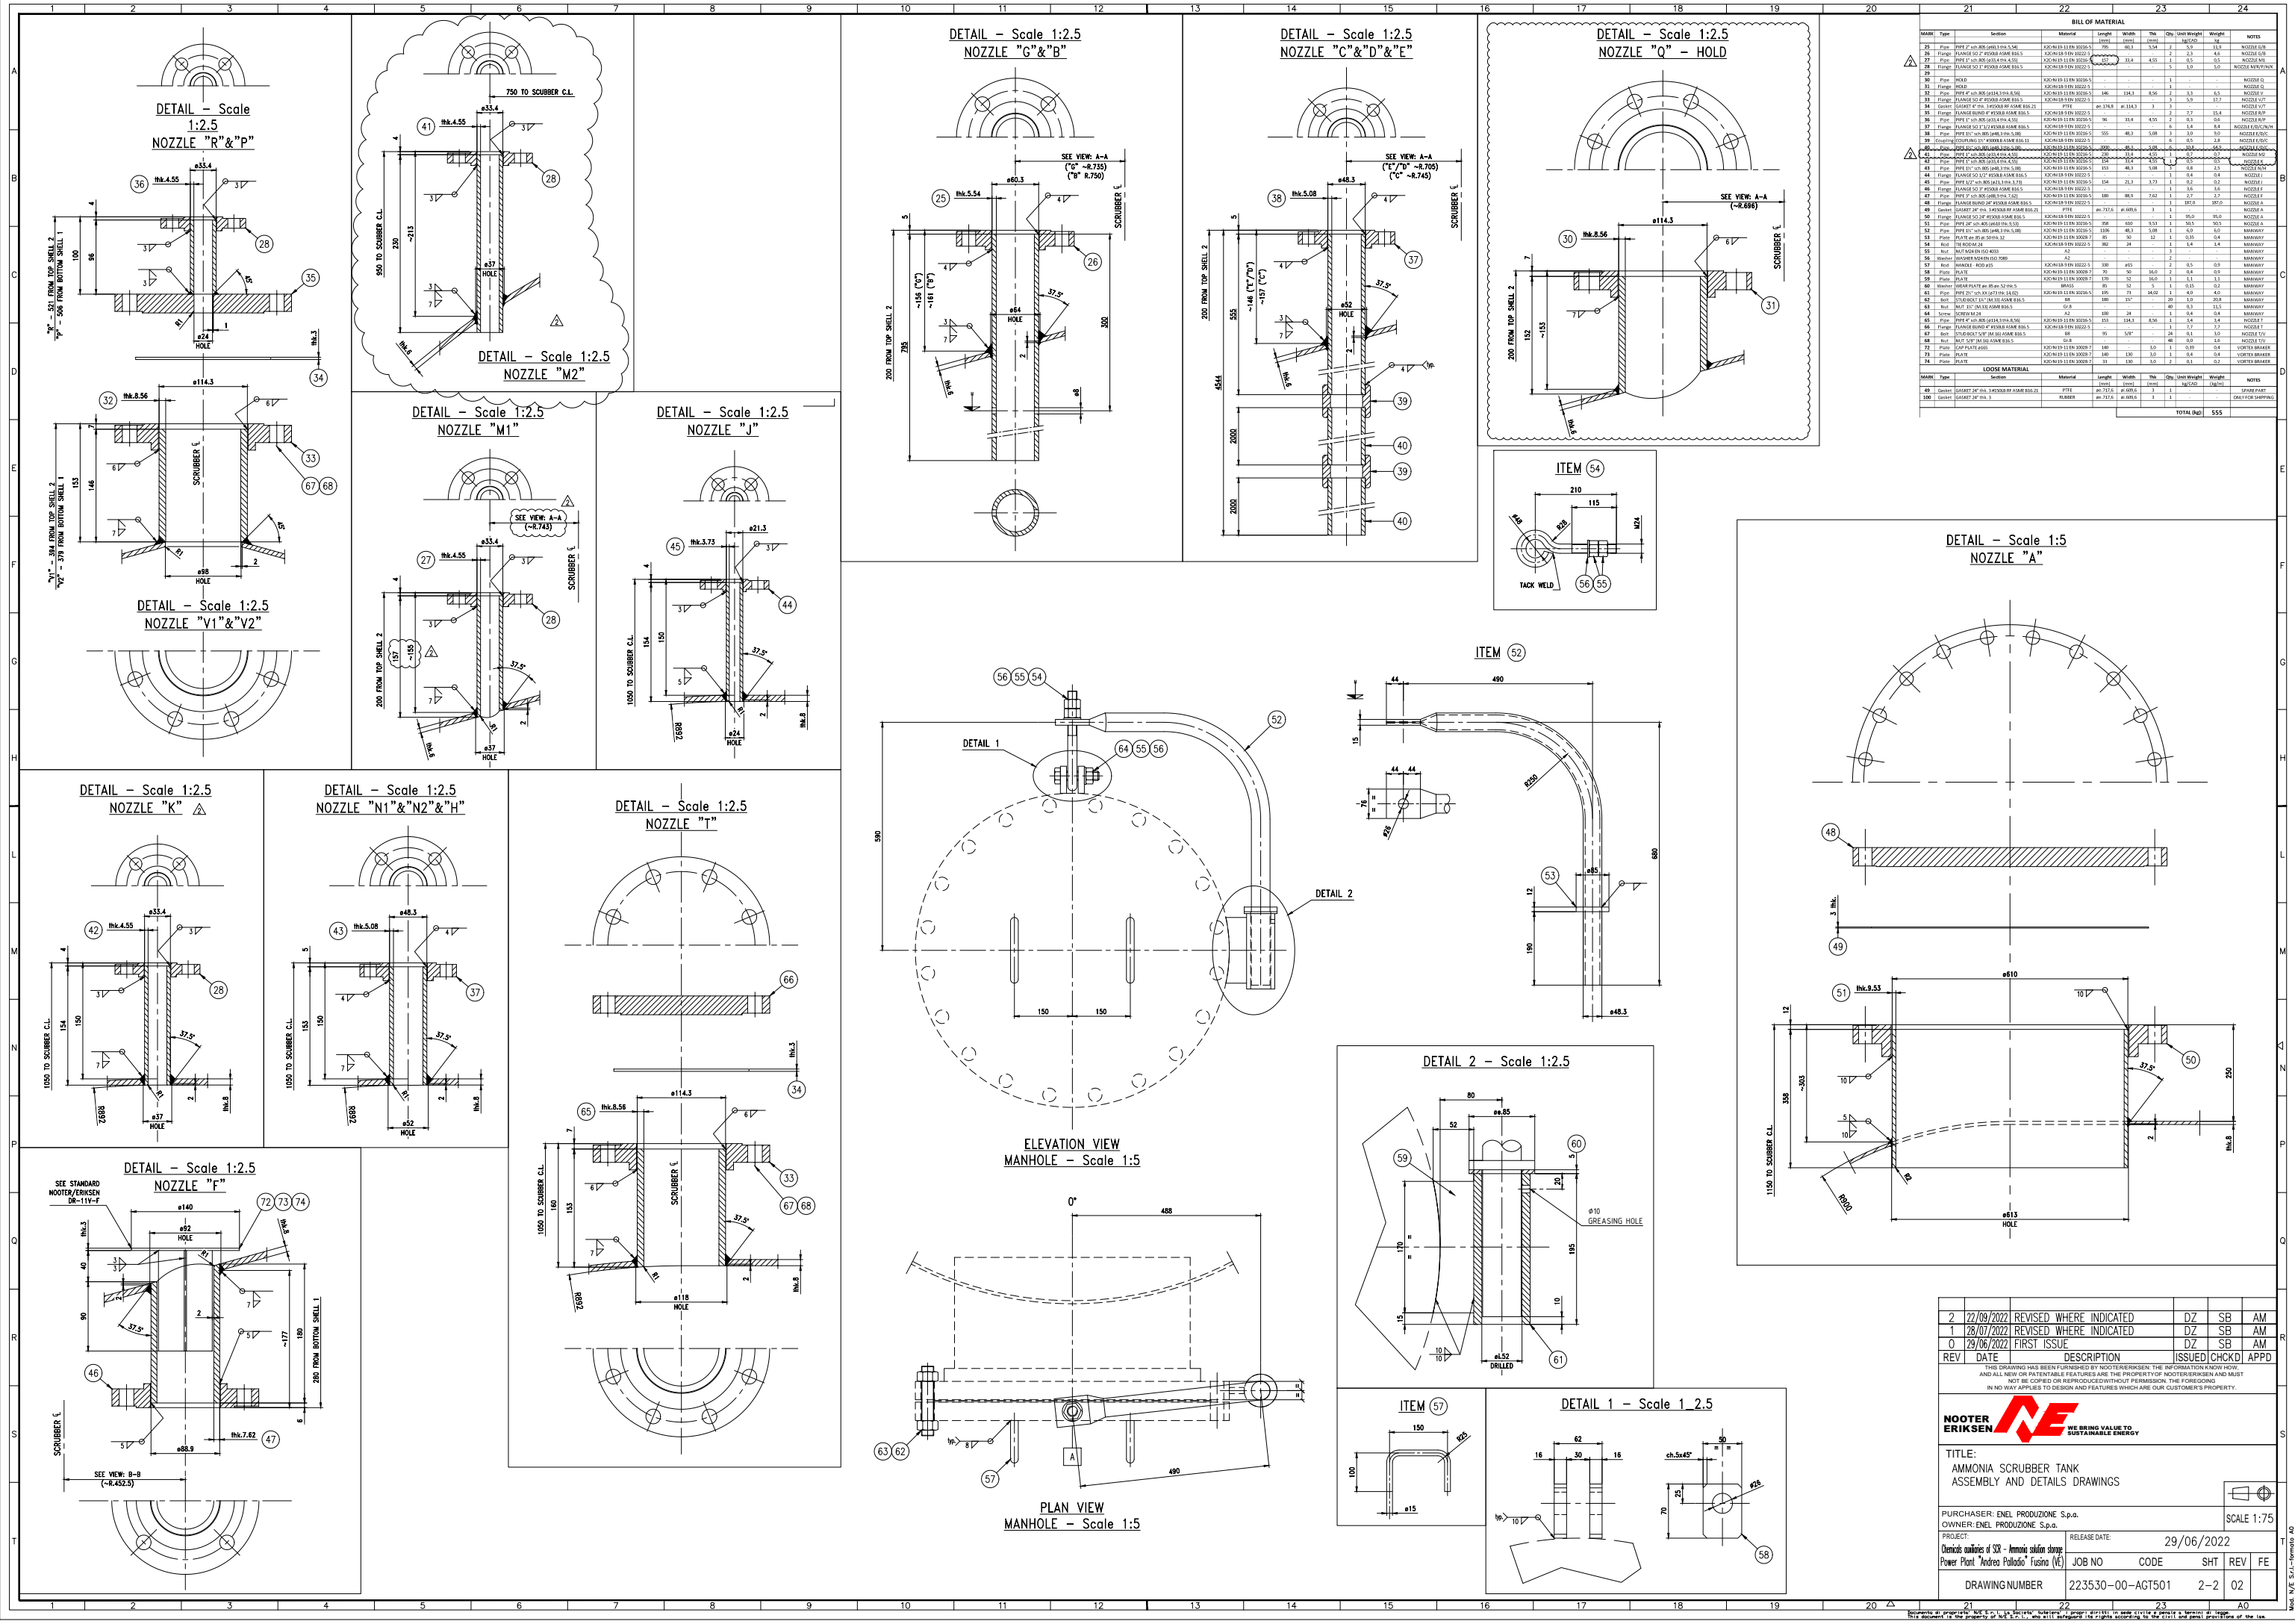

2	22/09/2022	REVISED WHERE INDICATED	DZ	SB	AM
1	28/07/2022	REVISED WHERE INDICATED	DZ	SB	AM
0	29/06/2022	FIRST ISSUE	DZ	SB	AM
REV	DATE	DESCRIPTION	ISSUED	CHKD	APPD

THIS DRAWING HAS BEEN FURNISHED BY NOTTER/ERIKSEN. THE INFORMATION KNOW HOW AND ALL NEW OR PATENTABLE FEATURES ARE THE PROPERTY OF NOTTER/ERIKSEN AND MUST NOT BE COPIED OR REPRODUCED WITHOUT PERMISSION. THE FOREGOING IN NO WAY APPLIES TO DESIGN AND FEATURES WHICH ARE OUR CUSTOMER'S PROPERTY.

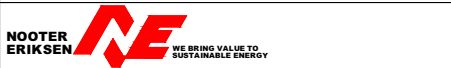

TITLE:
AMMONIA SCRUBBER TANK
ASSEMBLY AND DETAILS DRAWINGS

PURCHASER: ENEL PRODUZIONE S.p.A.
OWNER: ENEL PRODUZIONE S.p.A.

Power Plant: "Andrea Palladio" Fusina (VE)

RELEASE DATE: 29/06/2022
JOB NO: CODE SHT REV FE

DRAWING NUMBER: 223530-00-AGT501 2-2 02

SCALE 1:75