

MIL02 - Site 44
Datacenter Italy
 Caleppio di Settala
 Strada Prov. 415

Design Team

Design	CLAUDIA CODEGONE
Drawn	FABIO VERSETTI
Checked	GIUSEPPE LACERENZA
Approved	27/01/2023
Date	K781
Company Project No.	P. 0724
M.S. Project No.	

Approvals

CUSTOMER	MICROSOFT	Date
Microsoft Mechanical Engineer	GREG LYNCH	
Microsoft Civil Engineer	CATHAL O'SULLIVAN	
Microsoft Cabinet Engineer	ALAN KELLETTE	
Microsoft Electrical Engineer	VICTORIA MARSHALL	
Design Manager	MICHAEL O'DONNELL	
Security Manager	SPANMENDRA NADEU LAJOS MARVER	
CSA		

PROJECT MANAGEMENT


Project Manager	LEONARDO DI RENZO
Design Manager	GIUSEPPE LACERENZA
Development Manager	DAMIRO FRANCESCATI
Quality Control Reviewer	FABIO VERSETTI

Revisions

No.	Date	Description

Registration

Key Plan

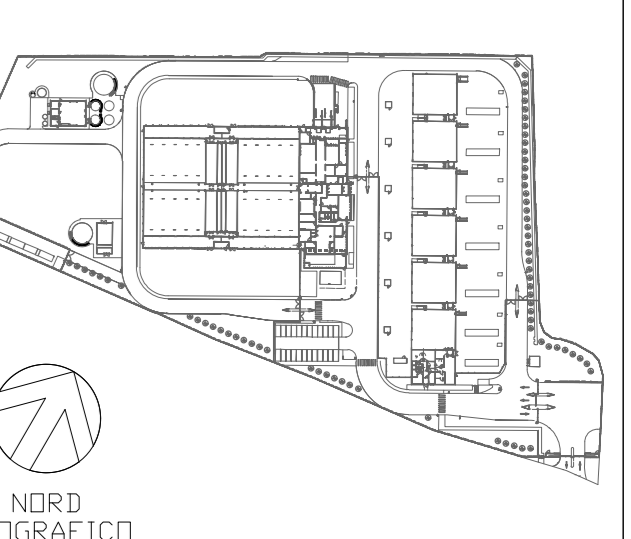

Bar Code


Sheet Title/Number

PLANIMETRIA GENERALE- Stato modificativo


MIL02-Tav 004

LEGENDA

- Perimetro del sito
- Recinzione perimetrale
- Area oggetto di intervento
- Strada-Asfalto
- Strada-Calcestruzzo drenante
- Marciapiede
- ♿ Parcheggio per disabili
- 🔌 Parcheggio per automobili elettriche
- Aree verdi
- ➔ Entrata principale
- ➔ Entrata secondaria
- Costruzione
- Demolizione

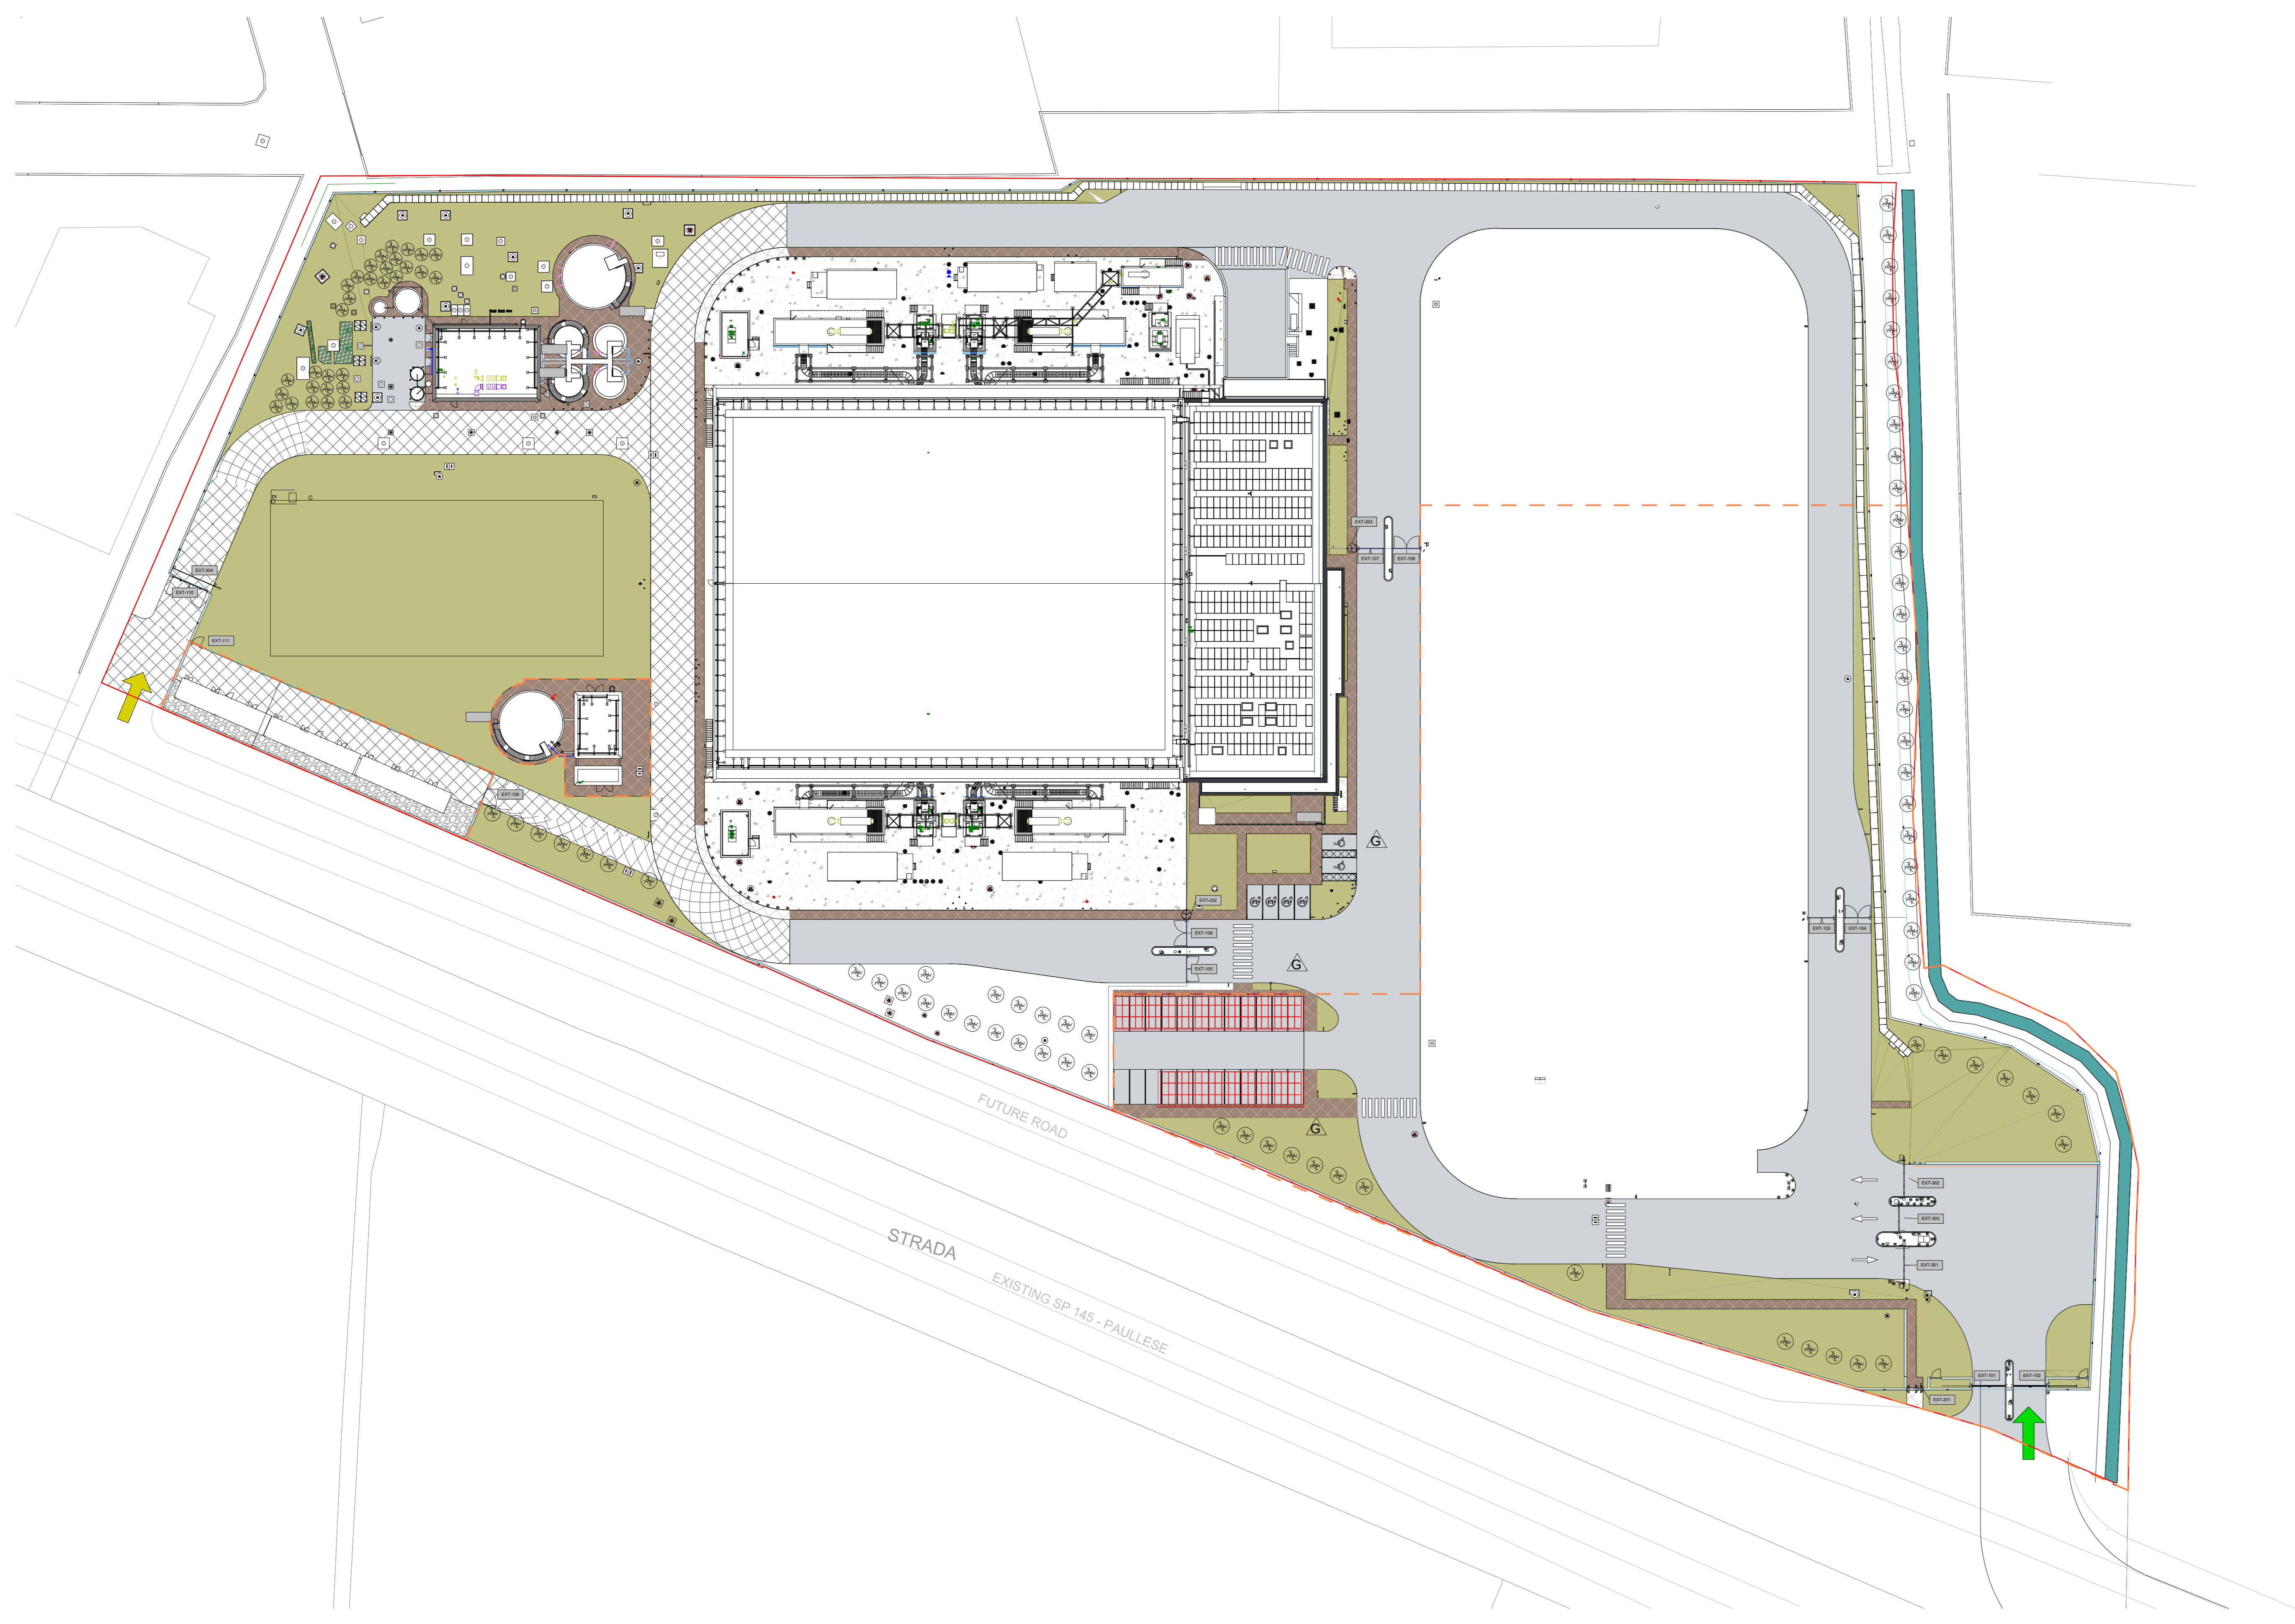

1 PLANIMETRIA GENERALE-STATO MODIFICATIVO
 1: 500

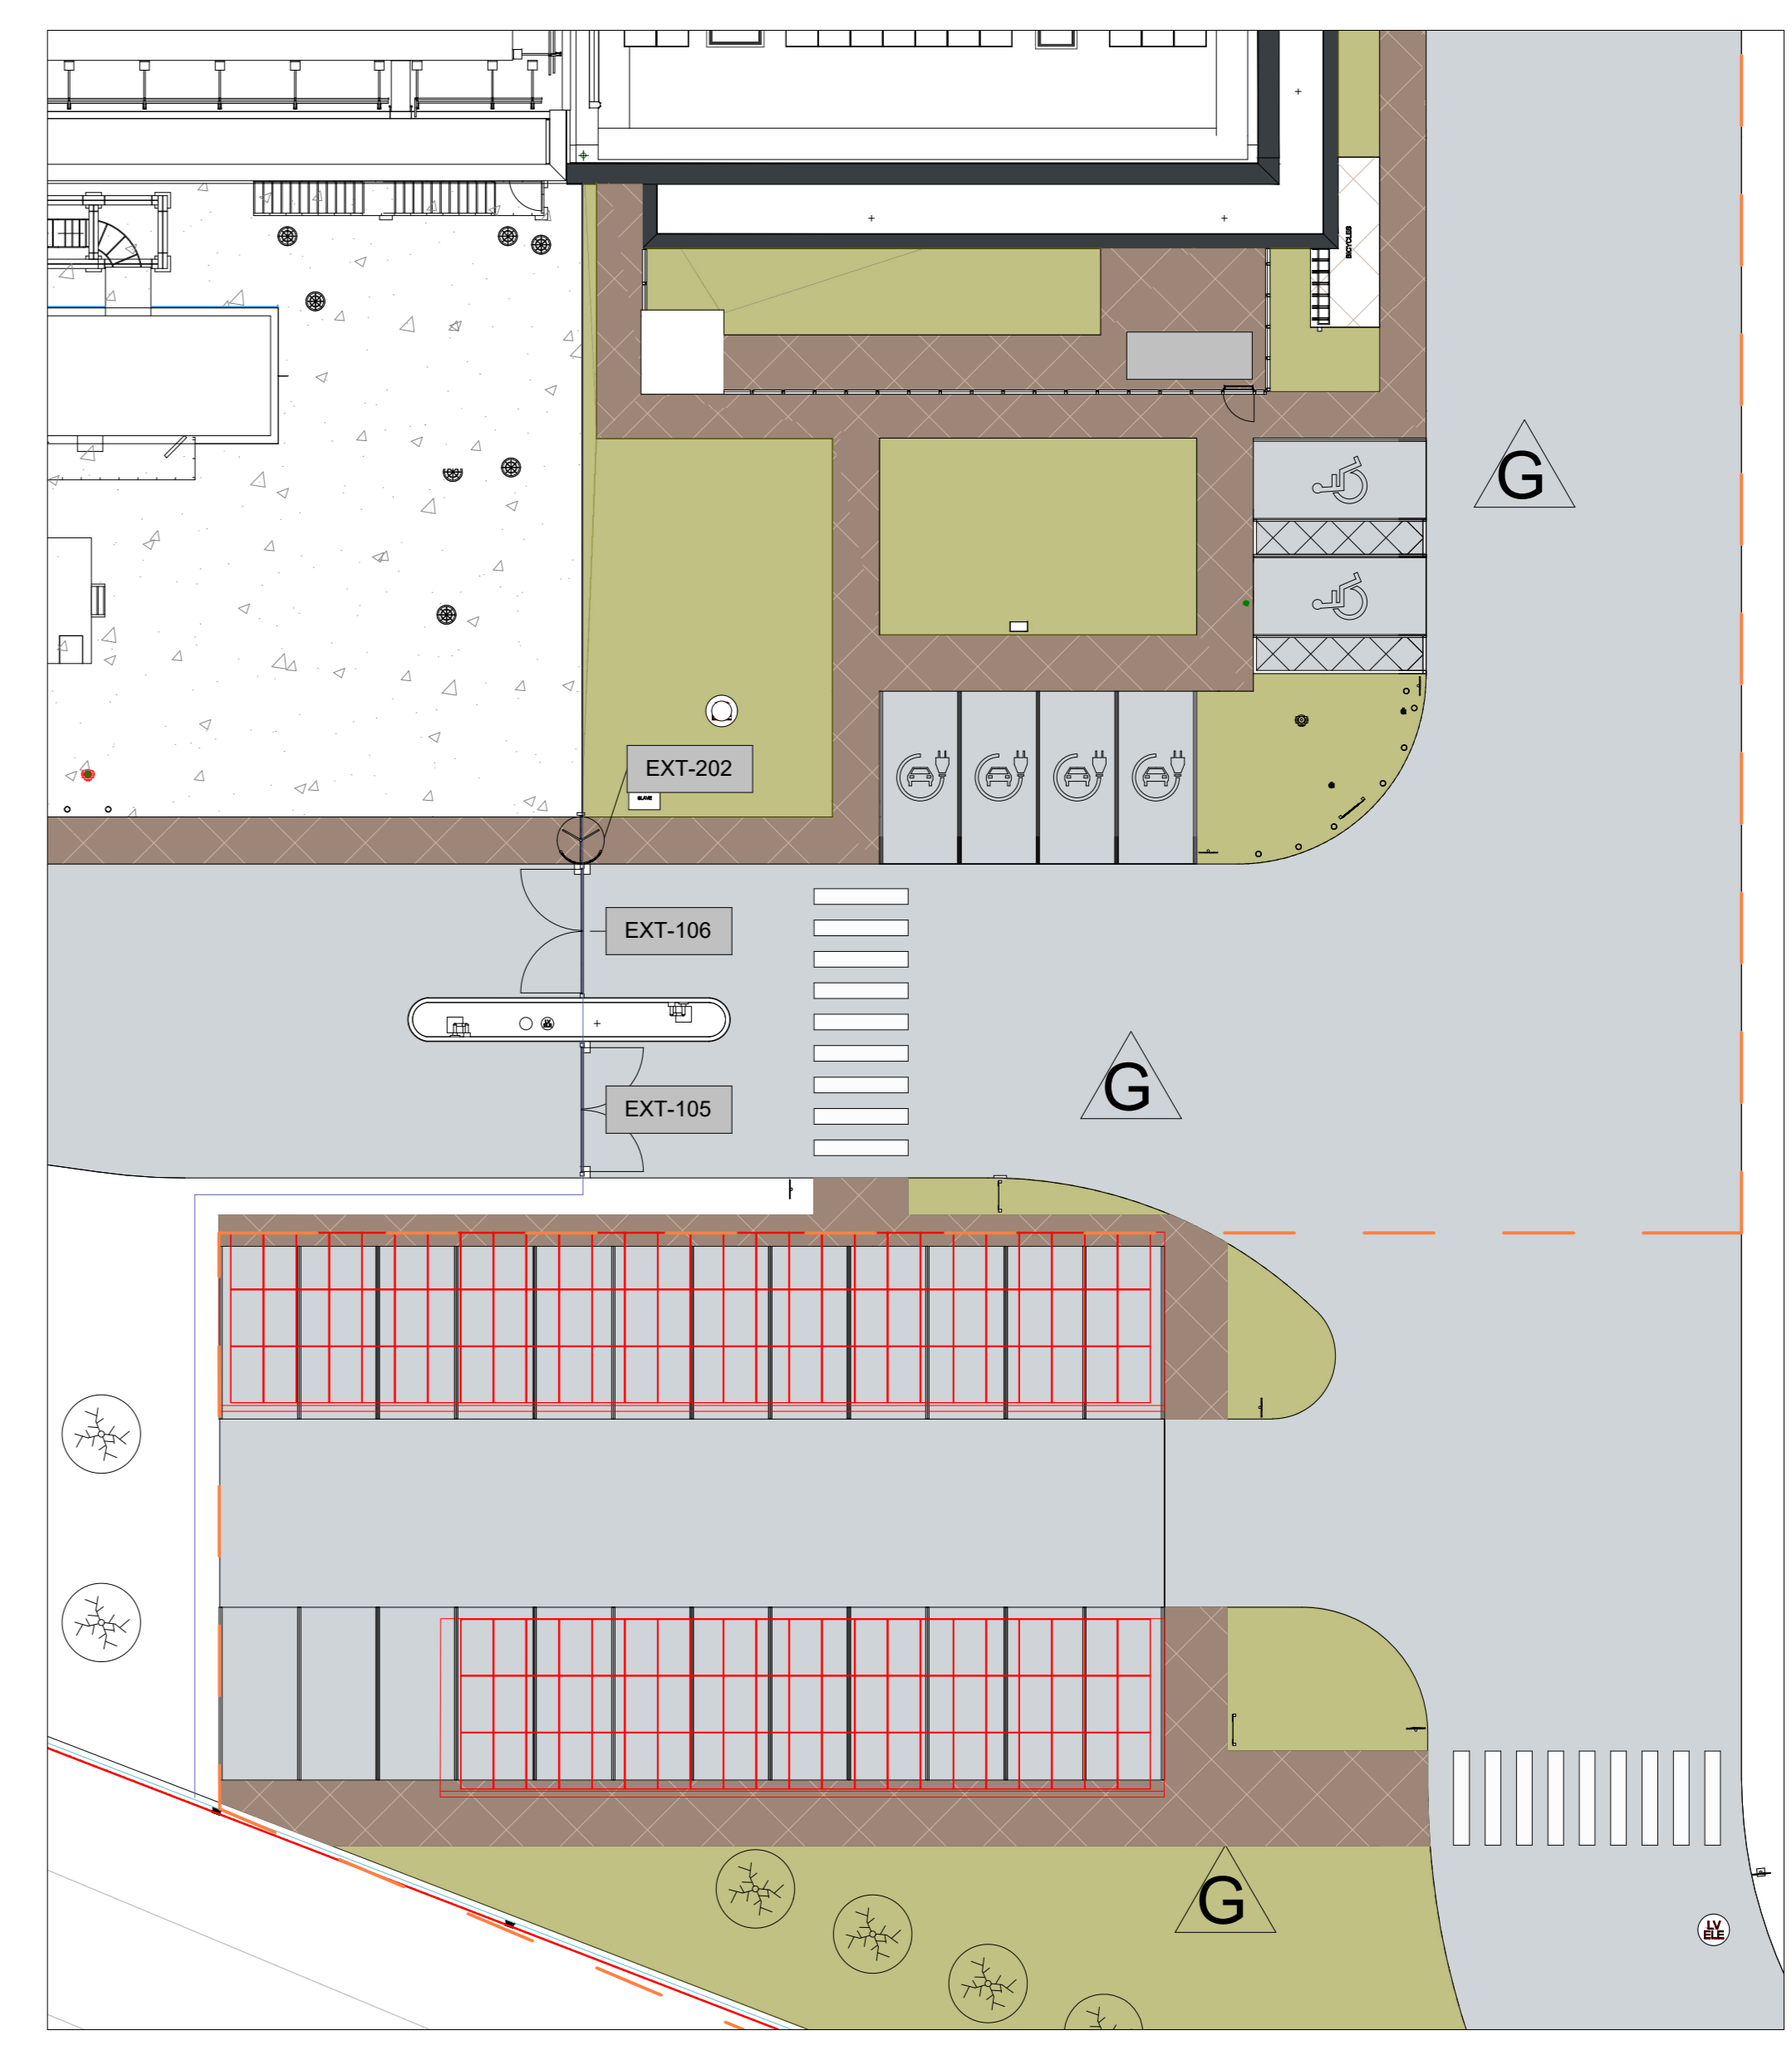

2 PLANIMETRIA di DETTAGLIO-STATO MODIFICATIVO
 1: 200