

MICROSOFT 4825 ITALY S.R.L.

MIL02 - Site 44
Datacenter Italy
Caleppio di Settala
Strada Prov. 415

Design Team

Design: JACOBS Italia S.p.A.
Claudia Codicione
Drawn: FABIO VERSETTI
Checked: GIUSEPPE LACERENZA
Approved: 27/04/2023
Date: 27/04/2023
Company Project No.: P-0224
M.I. Project No.:

Approvals

| CUSTOMER | DATE |
|-------------------------------|--------------------------------|
| MICROSOFT | |
| Microsoft Mechanical Engineer | GREG LYNCH |
| Microsoft Civil Engineer | CATHAL O'SULLIVAN |
| Microsoft Electrical Engineer | ALAN KELLETT |
| Microsoft Structural Engineer | VICTORIA MARCHALL |
| Design Manager | MICHAEL O'DONNELL |
| Security Manager | SRIHANDEERA NANDU LAJES MARVER |
| CIA | |

PROJECT MANAGEMENT



| | |
|--------------------------|--------------------|
| Project Manager | LEONARDO DI RENZO |
| Design Manager | GIUSEPPE LACERENZA |
| Development Manager | DAVID FRANCESCATI |
| Quality Control Reviewer | FABIO VERSETTI |

Revisions

| No. | Date | Description |
|-----|------|-------------|
| | | |
| | | |
Registration

Key Plan

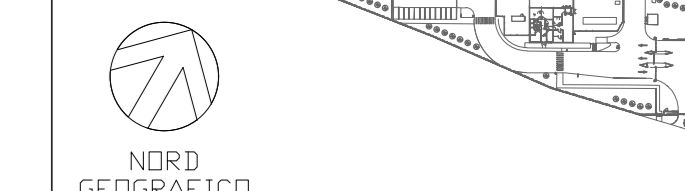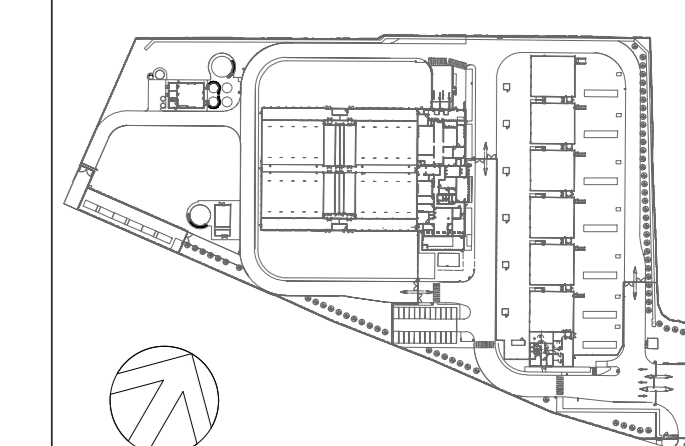

Bar Code



Sheet Title/Number

PLANIMETRIA
GENERALE-
Stato modificativo

MIL02-Tav 004

LEGENDA

| | |
|--|--------------------------------------|
| | Perimetro del sito |
| | Recinzione perimetrale |
| | Area oggetto di intervento |
| | Strada-Asfalto |
| | Strada-Calcestruzzo drenante |
| | Marciapeste |
| | Parcheggio per disabili |
| | Parcheggio per automobili elettriche |
| | Area verdi |
| | Entrata principale |
| | Entrata secondaria |
| | Costruzione |
| | Demolizione |

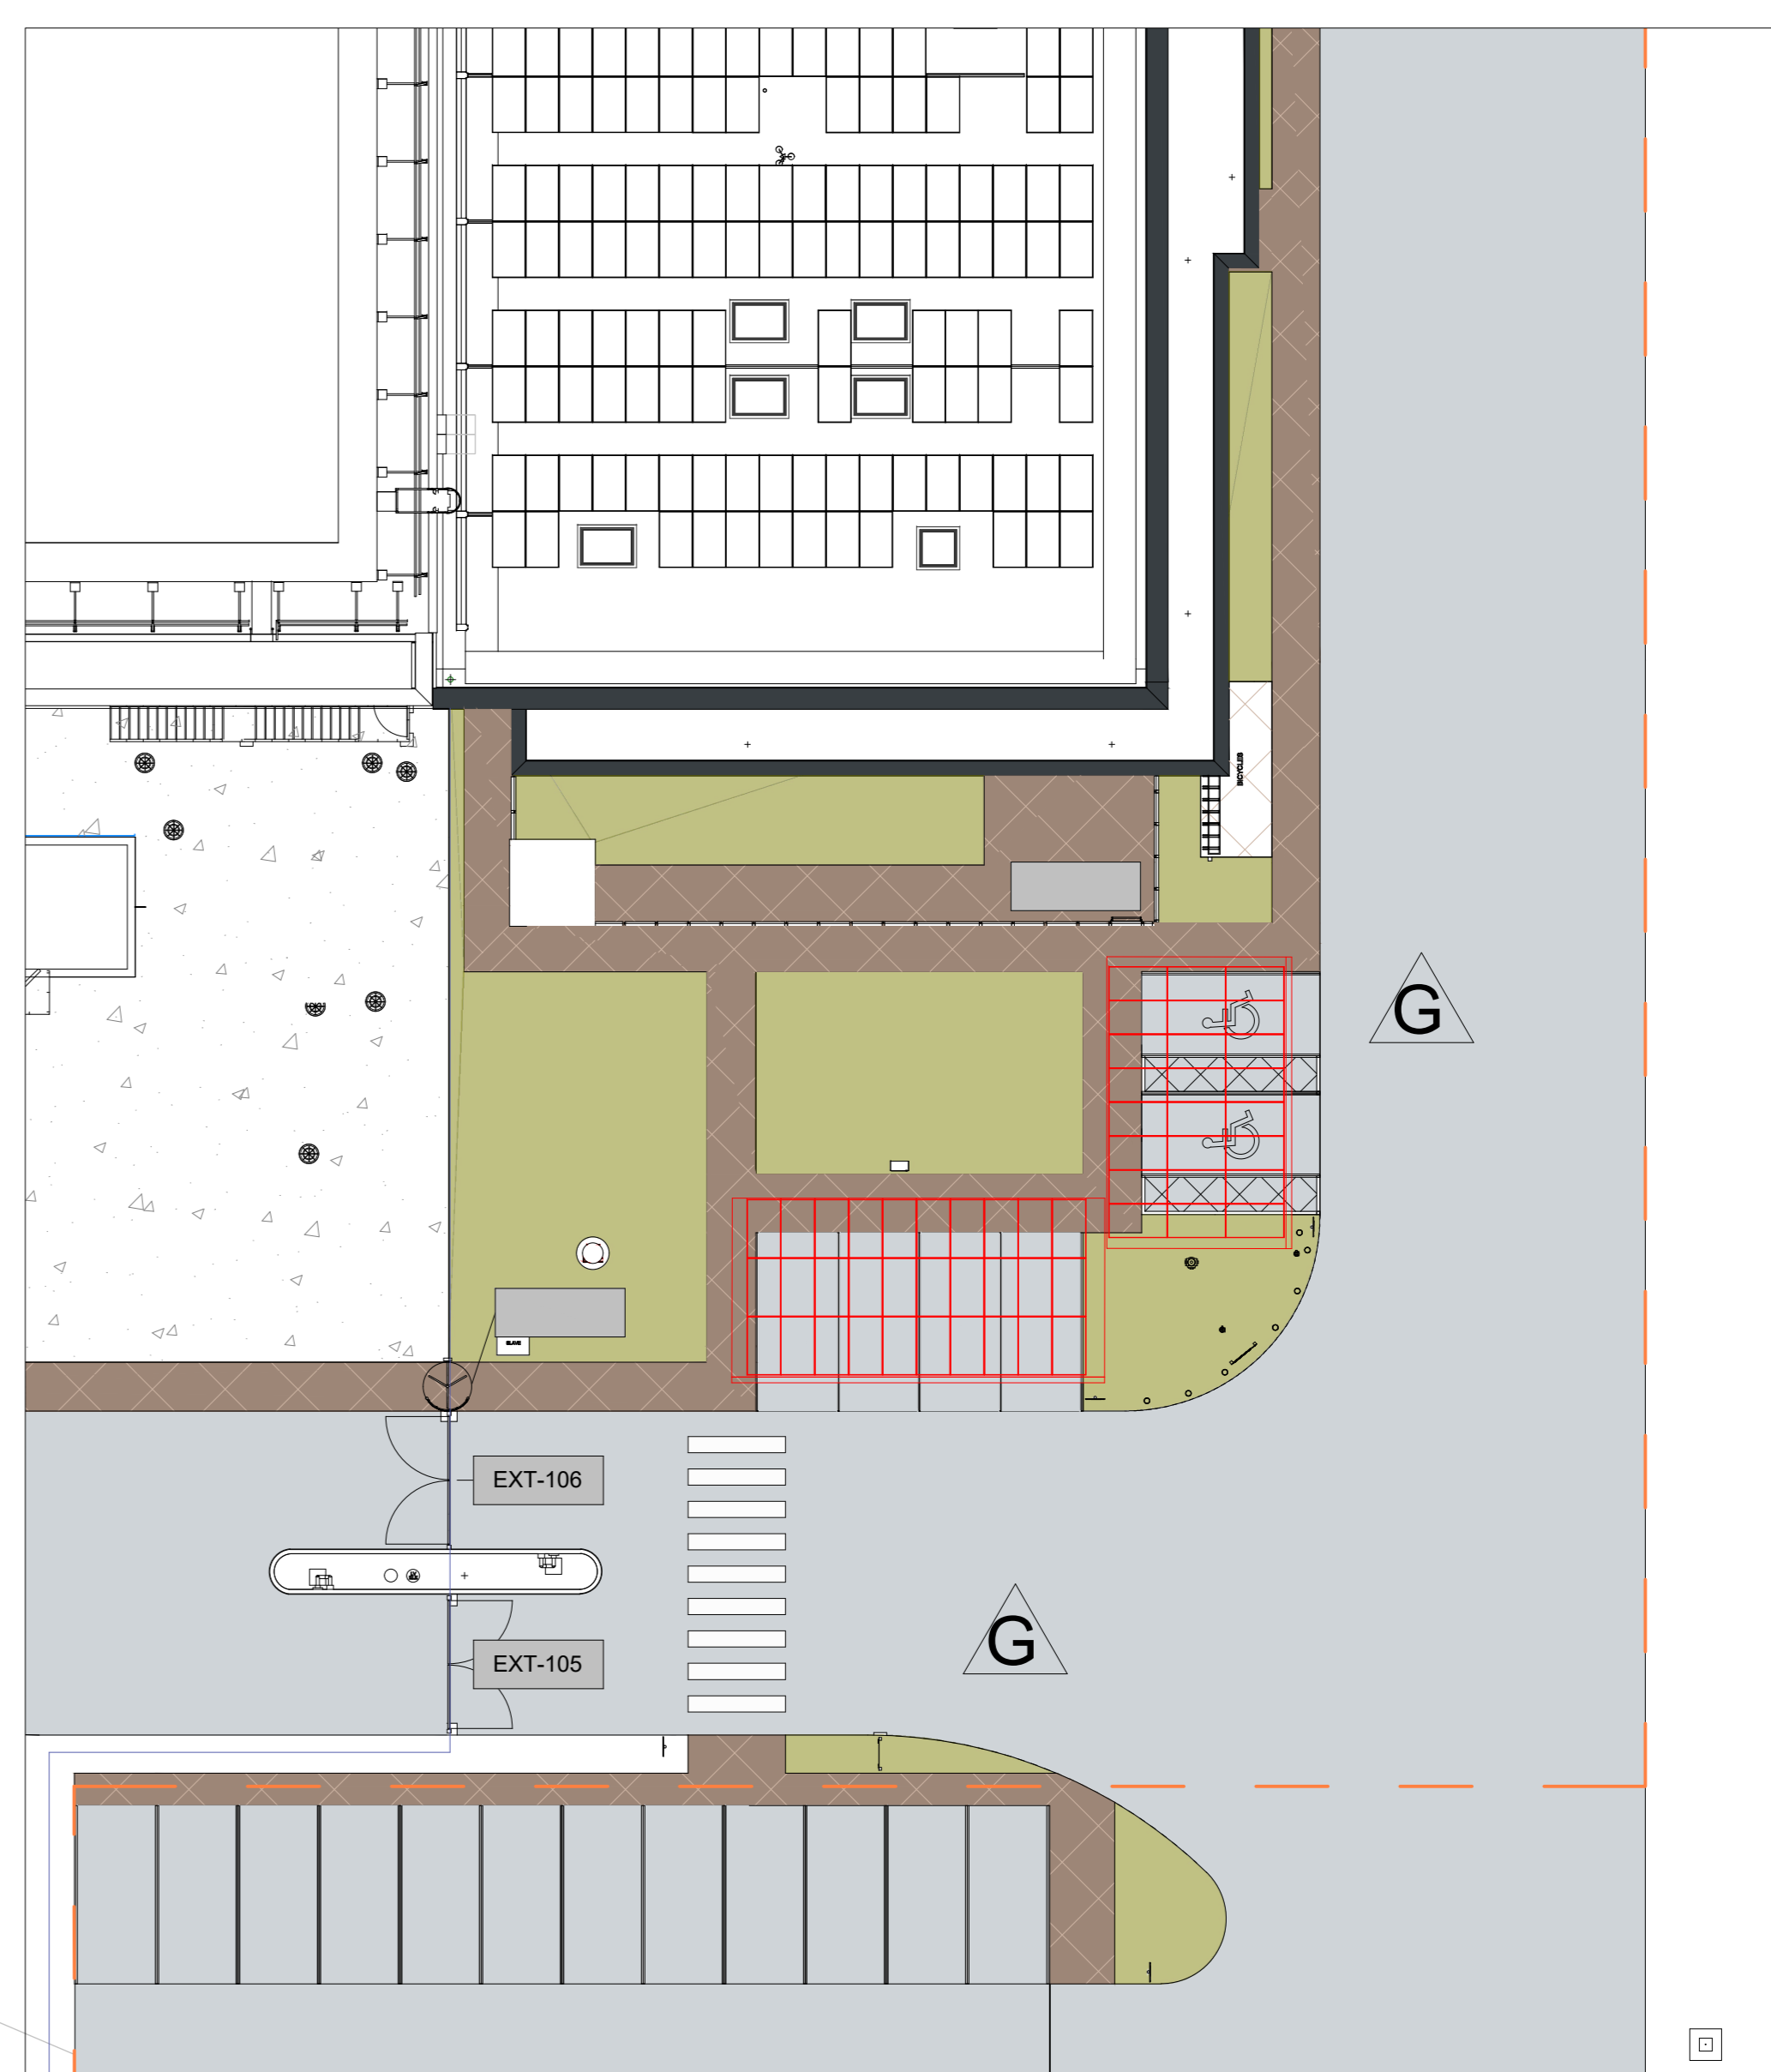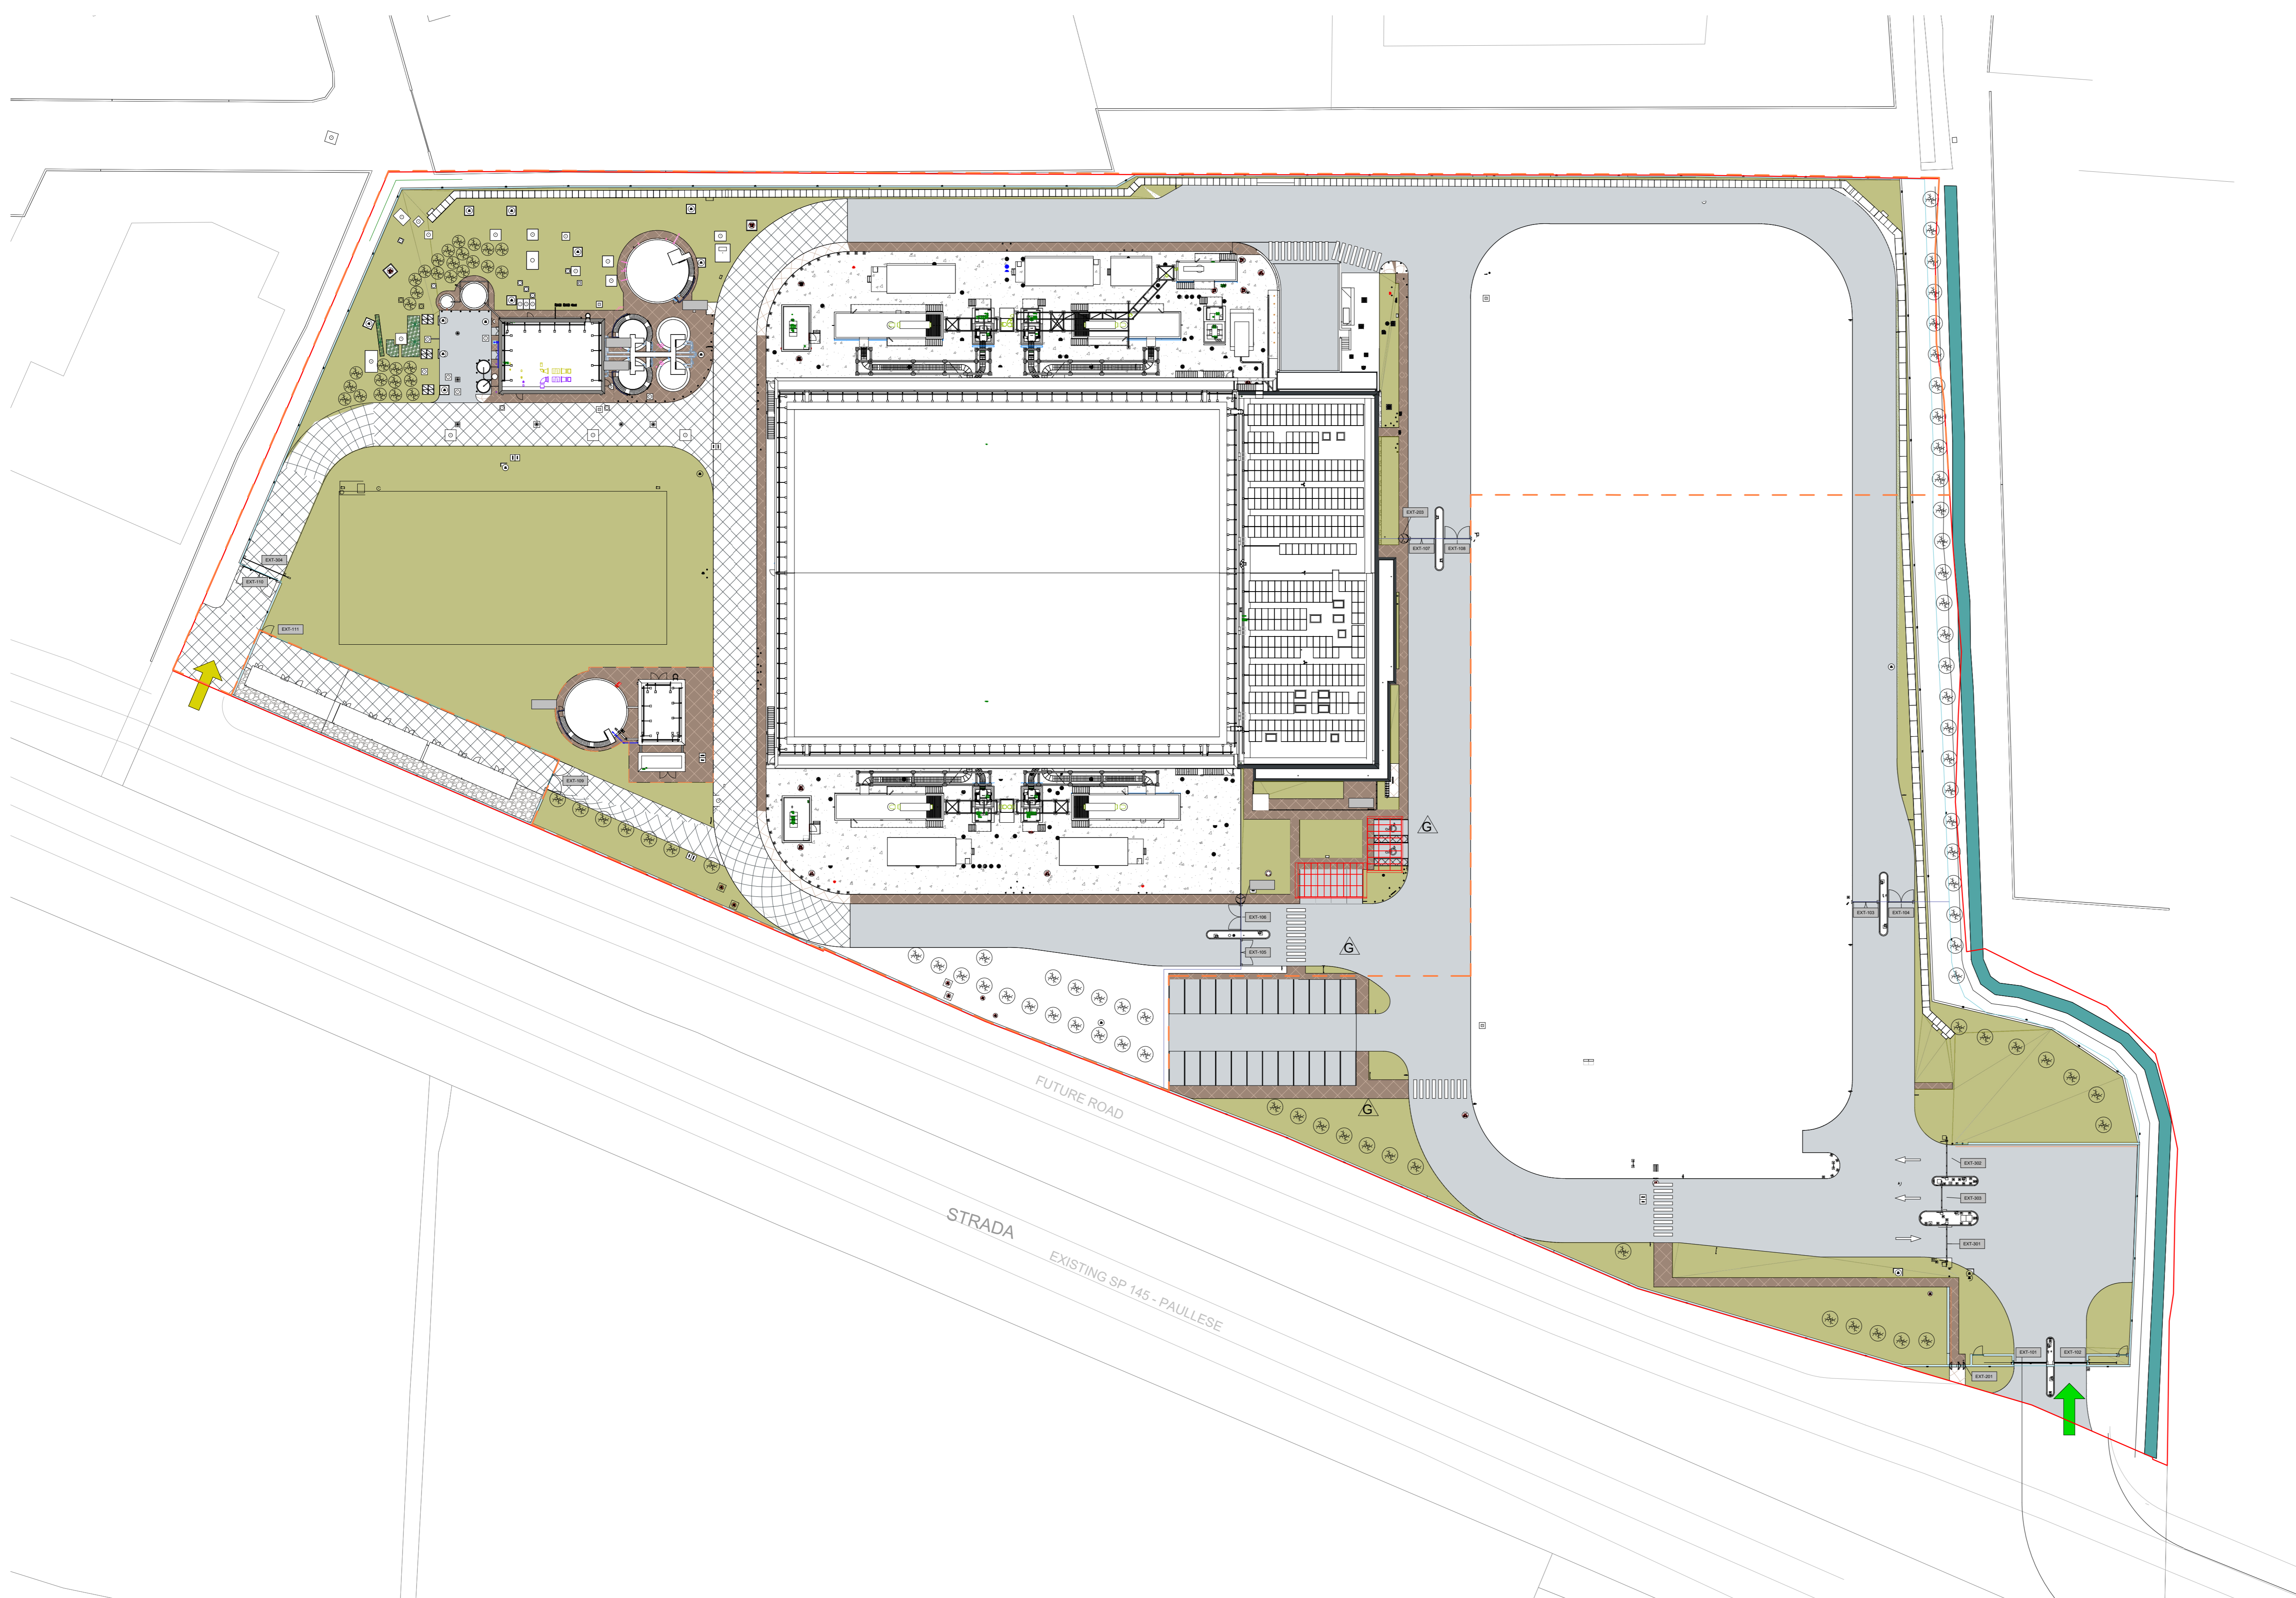

1 PLANIMETRIA GENERALE-STATO DI FATTO
1:500

2 PLANIMETRIA di DETTAGLIO-STATO MODIFICATIVO
1:200